EROSION MATTING			
STA.	STA.	LOCATION	
REV. 268+00	271+30	LEFT	
SURV. 282+08	284+50	LEFT	

CONSTRUCT DRIVE			
STA.	LOCATION	TYPE	WIDTH
278+38	LEFT	GRAVEL	12 FT.
282+35	LEFT	GRAVEL	15 FT.

CONSTRUCT DRIVE			
STA.	LOCATION	TYPE	WIDTH
REV. 269+02	RIGHT	GRAVEL	12 FT.
REV. 270+52	RIGHT	GRAVEL	12 FT.
283+00	RIGHT	GRAVEL	12 FT.

SPECIAL DITCH W/STONE FILL			
STA.	STA.	LOCATION	TYPE
REV 271+54	RTE 282 51+50	LEFT	I
RTE 282 51+50	275+00	LEFT	I

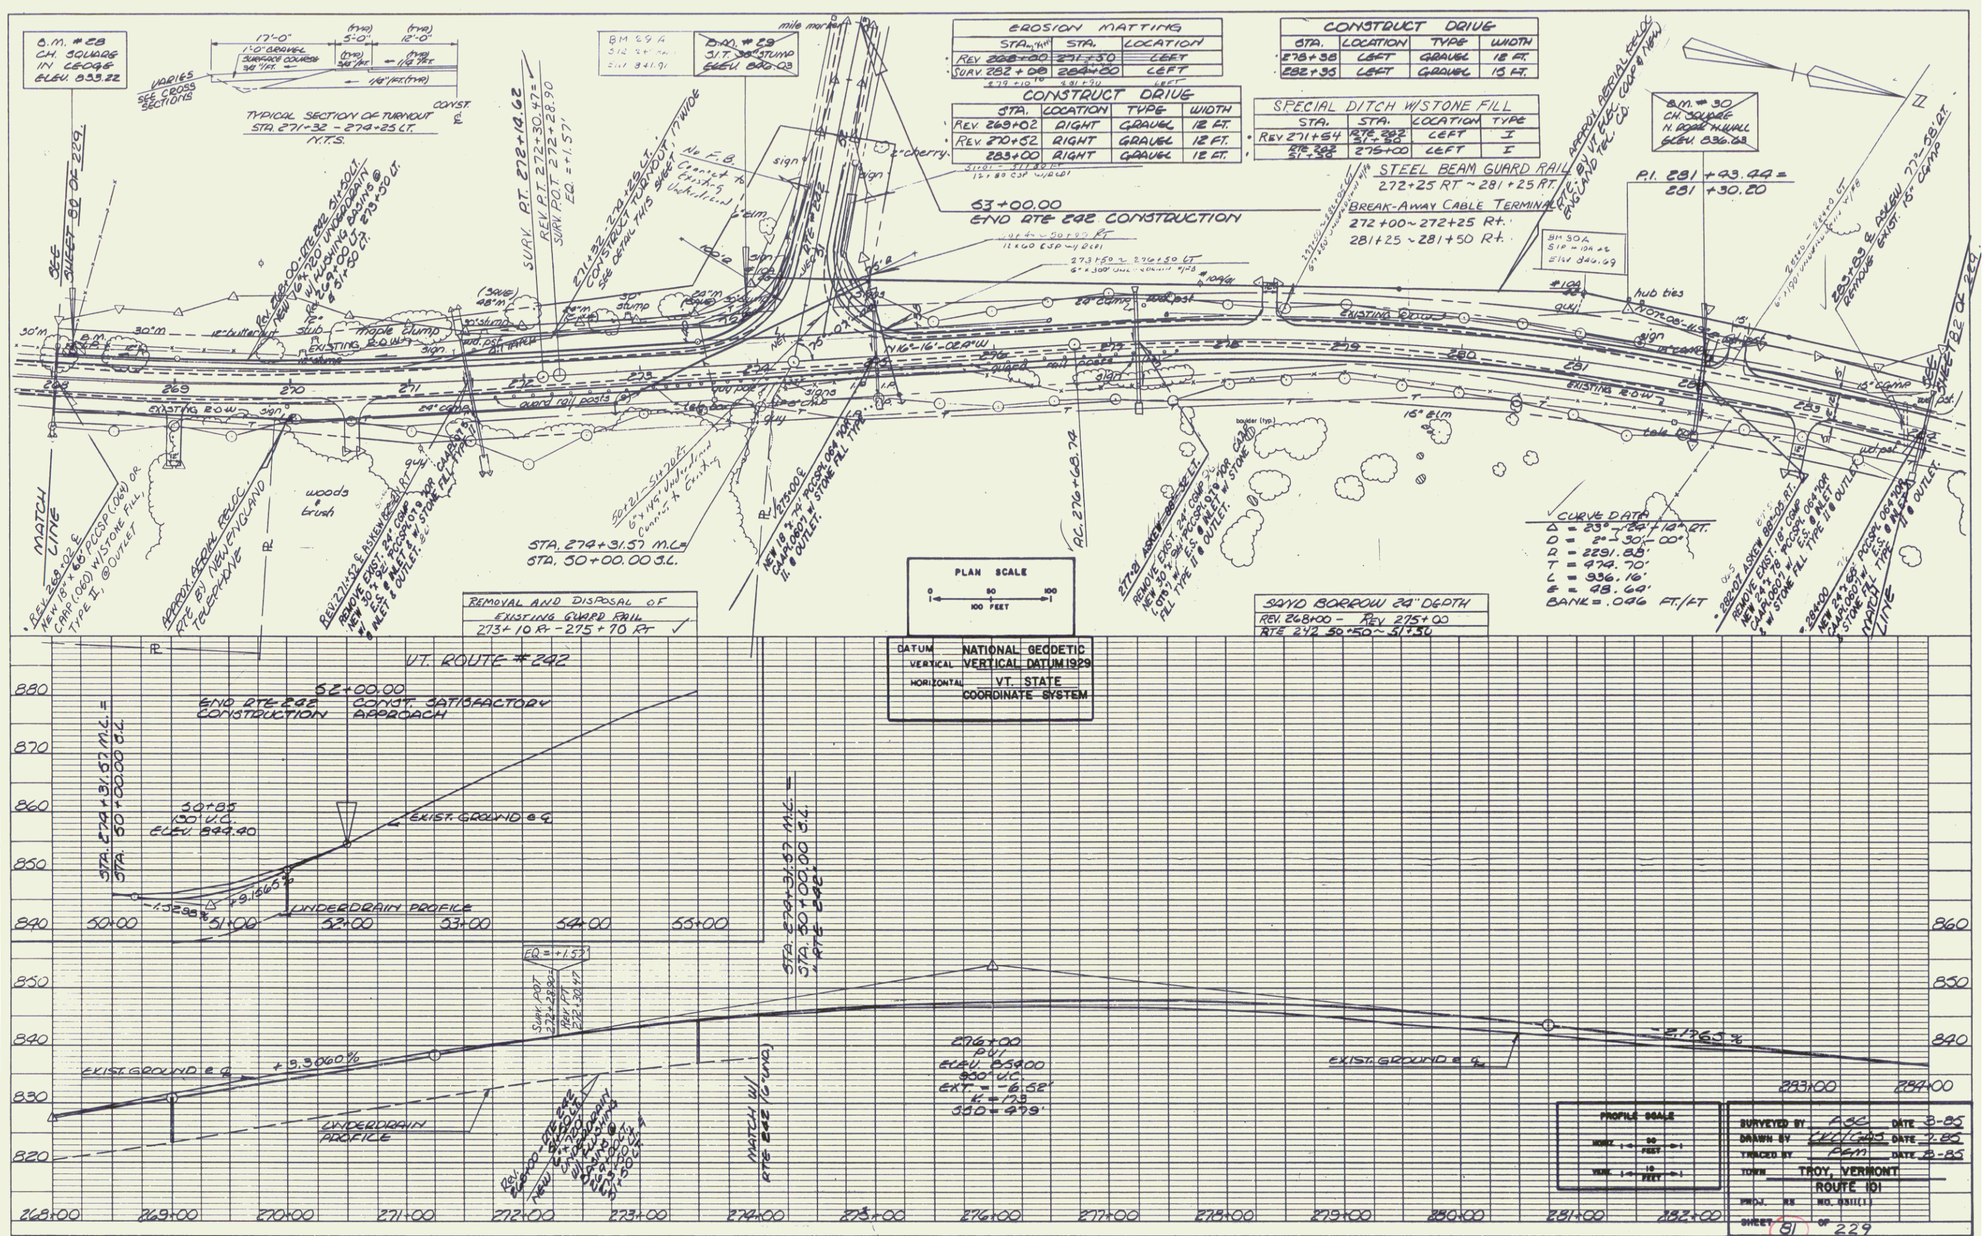

MAR 29 1995