

PLAN
NOTE BOOK
NO. 1

PROFILE
NOTE BOOK
NO. 2

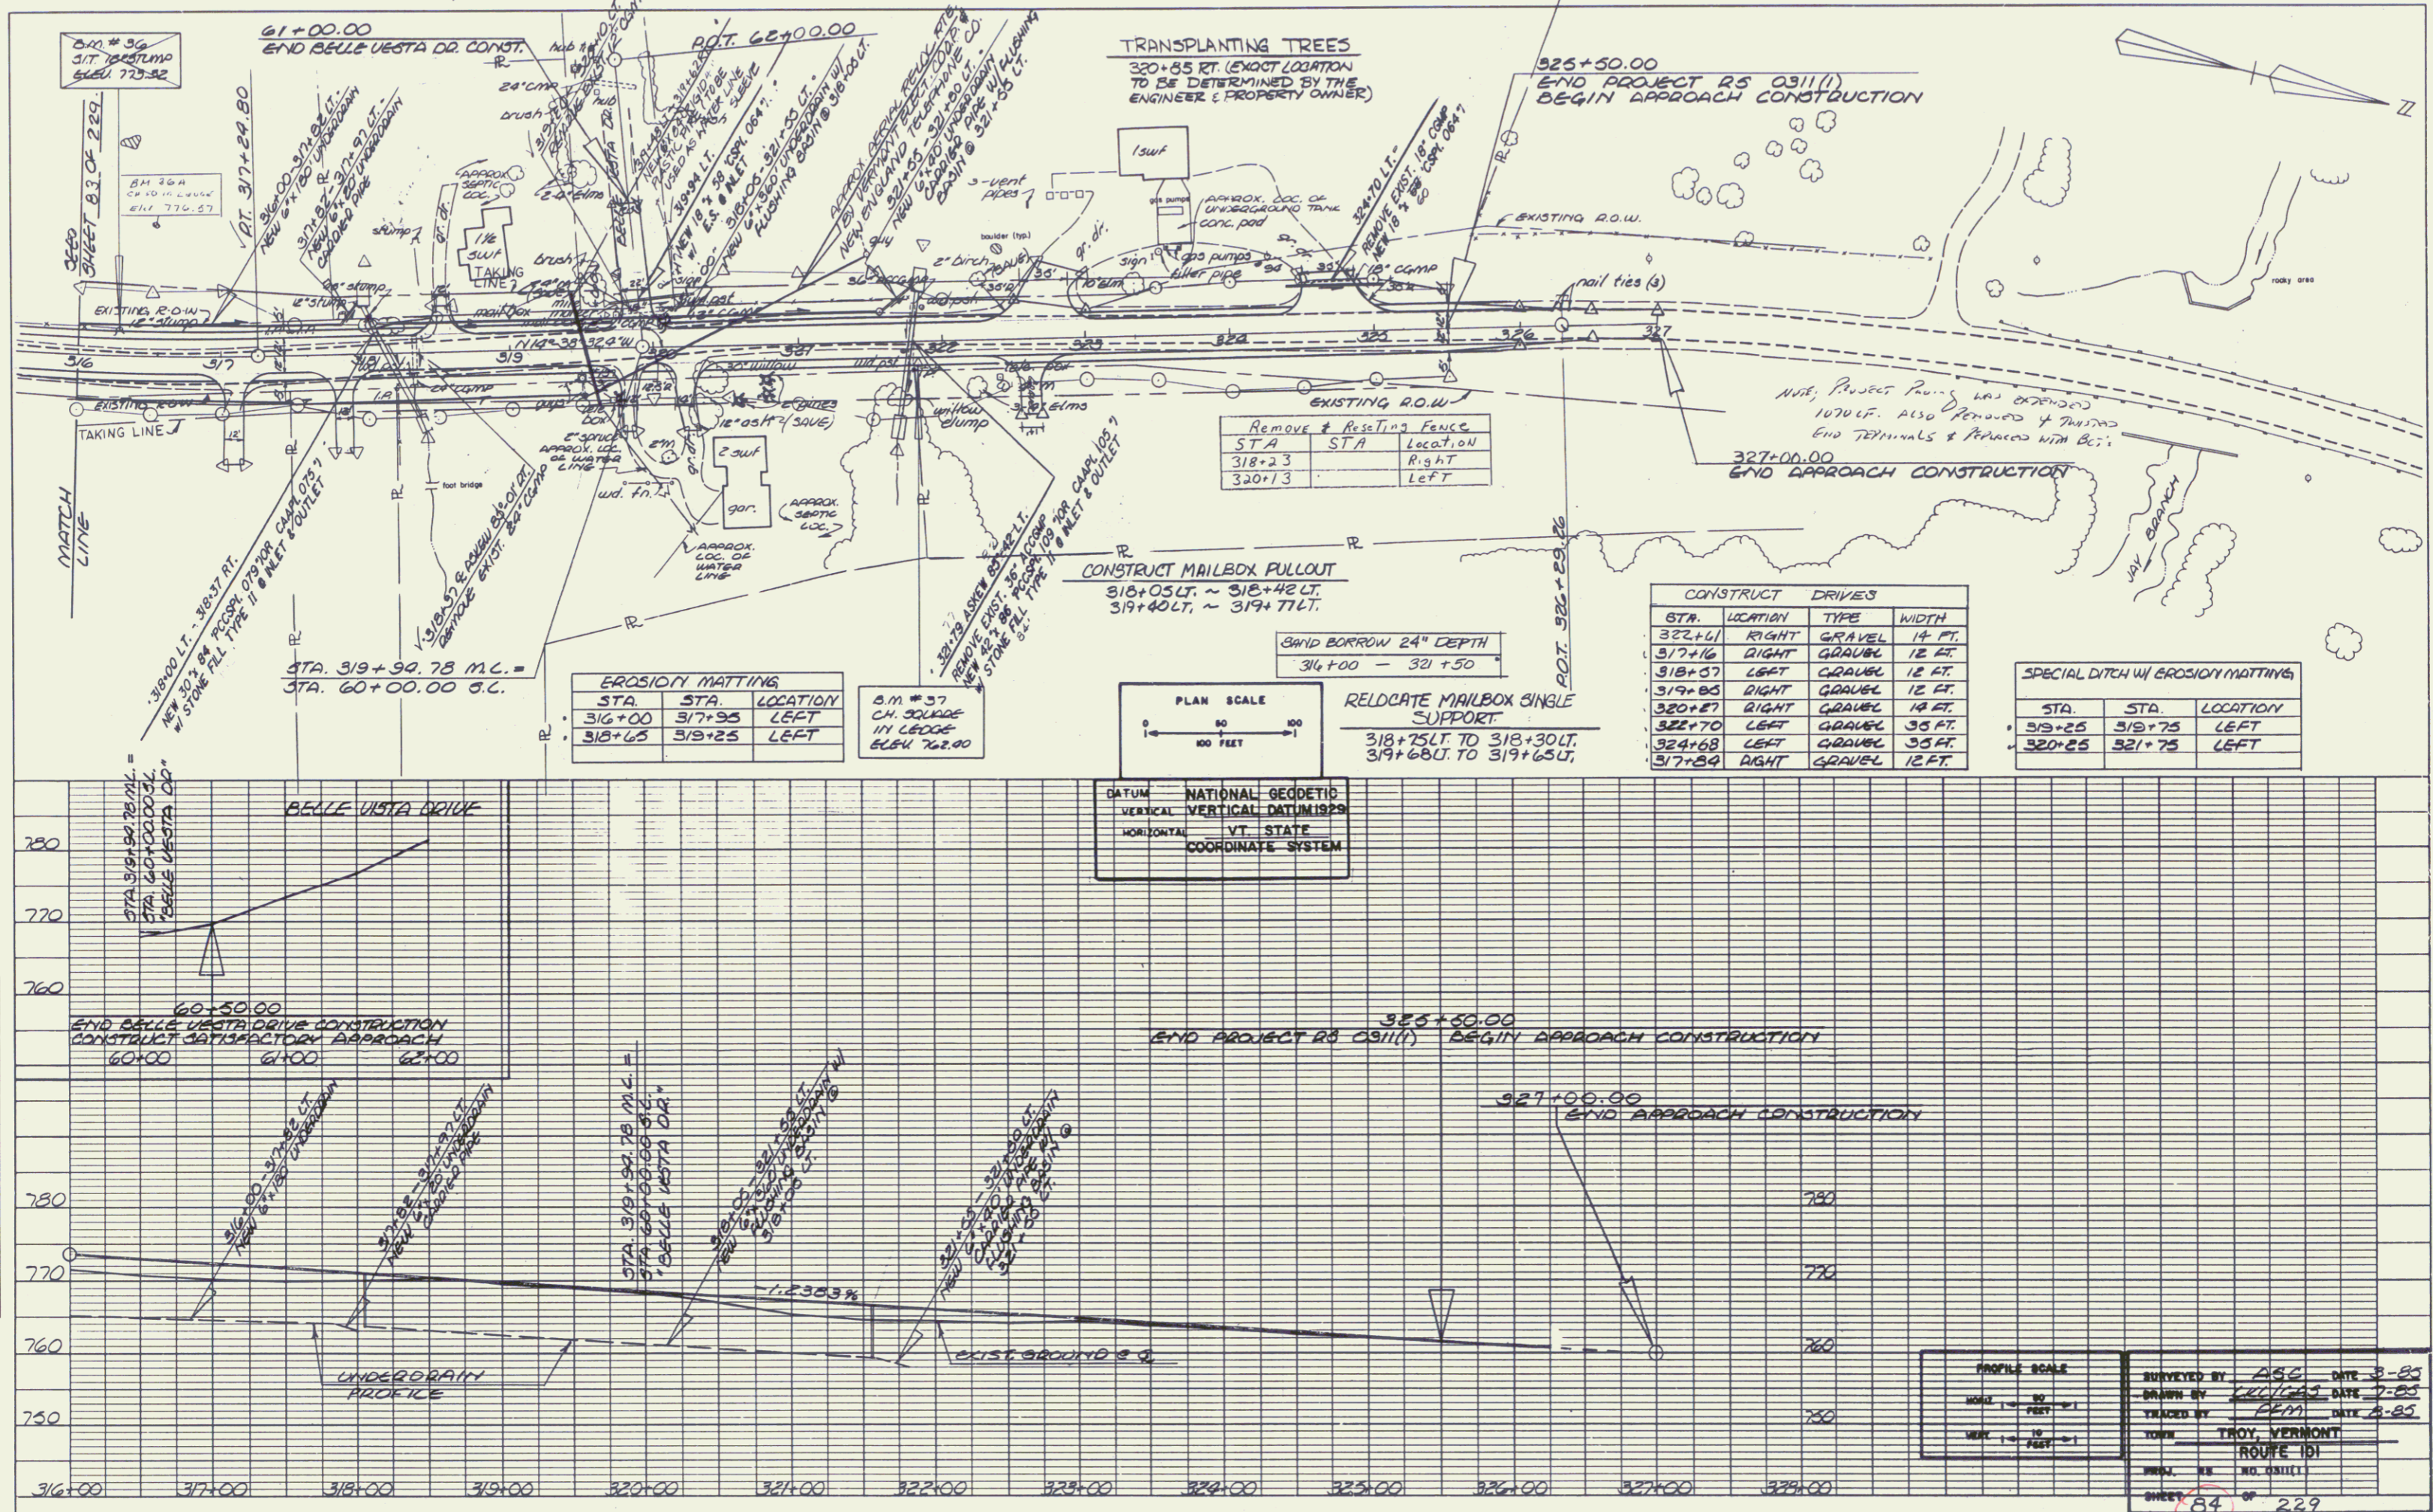


PLATE 1 PLAN PROFILE D & S & L STANDARD
MAY 1988 EDITION

MAR 29 1995 81

PROFILE SCALE
HORIZ. 1" = 100'
VERT. 1" = 10'

 TOWN: TROY, VERMONT
 ROUTE: 101
 SHEET: 84 OF 229