INDEX OF SHEETS

# STATE OF VERMONT
# AGENCY OF TRANSPORTATION

## PROPOSED IMPROVEMENT
## TOWN OF ELMORE
## COUNTY OF LAMOILLE
## VERMONT ROUTE 12 (FAS)

R.O.W. PLANS

BEGINNING AT A POINT 1.200 MILES IN A SOUTHEASTERLY DIRECTION FROM THE MORRISTOWN-ELMORE TOWN LINE AND EXTENDING 0.095 MILES IN A NORTHWESTERLY DIRECTION.

THIS PROJECT CONSISTS OF BRIDGE WIDENING, INCLUDING APPROACHES, ON EXISTING VT. 12.

LENGTH OF ROADWAY 477.7 FEET = 0.091 MILES
LENGTH OF BRIDGE 22.3 FEET = 0.004 MILES
LENGTH OF PROJECT 500.0 FEET = 0.095 MILES
LENGTH OF ROW. PROJ. 700.0 FEET = 0.133 MILES

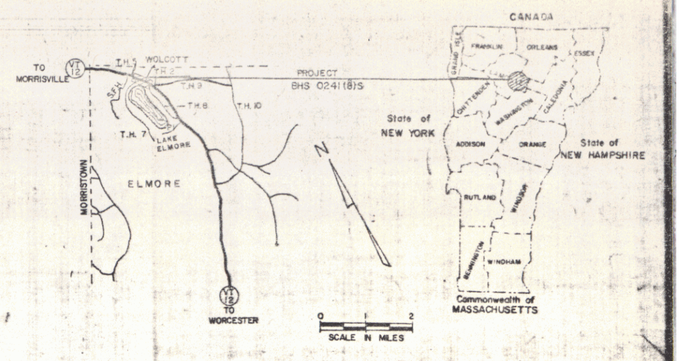


TRAFFIC DATA
1981 AADT 1600
1981 DHV 240
D 55% NB
T 3%
V 40 MPH

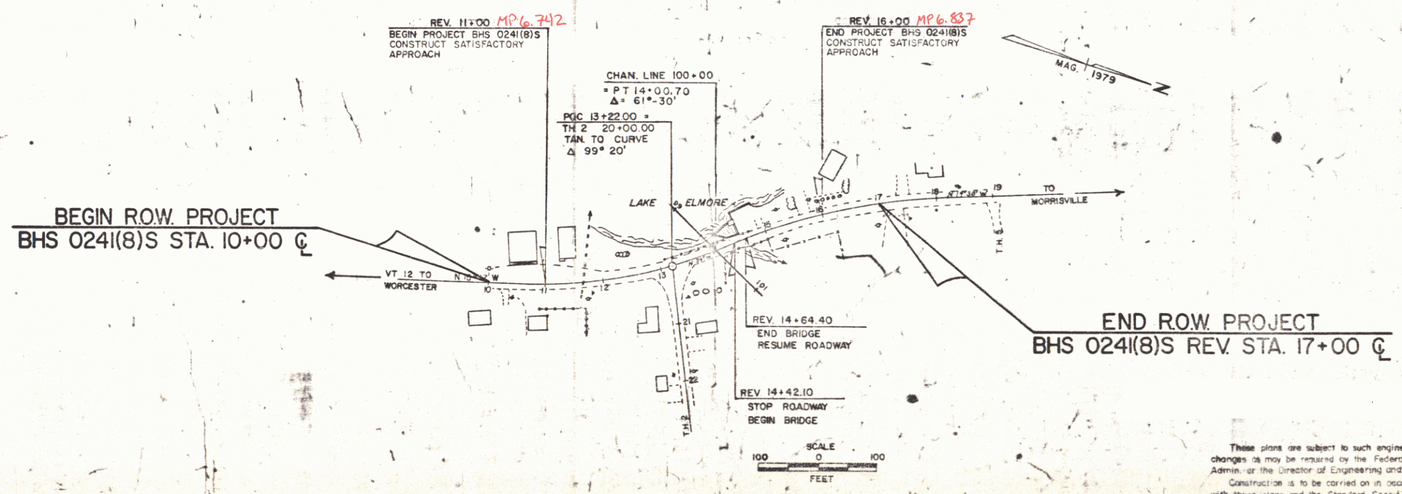


CONVENTIONAL SIGNS

COUNTY LINE
TOWN LINE
LIMITS OF ACCESS
POINT OF ACCESS
FENCE LINE
STONE WALL
TRAVELED WAY
GUARD RAIL
RAILROAD
SURVEY LINE
CULVERT
POWER PL E
TELEPHONE POLE
TREES
CONTROL OF ACCESS
PROPERTY LINE
R/W TAKING LINE
SLOPE RIGHTS
TOP OF CUT
TOE OF SLOPE

DATUM
VERTICAL NGVD 1929
HORIZONTAL N/A

RIGHT-OF-WAY DIVISION
TOWN FILE
PERPETUAL

Town of _____
(To Be Returned to R.O.W. Division)

Pin# 78E150

PROJECT PROCESSED UNDER SECONDARY ROAD PLAN

These plans are subject to such engineering changes as may be required by the Federal Highway Administrator the Director of Engineering and Construction.

Construction is to be carried on in accordance with these plans and the Standard Specifications for Highway and Bridge Construction dated March, 1976, as approved by the Federal Highway Administration on October 27, 1975 for use on this project, including all subsequent revisions and such revised specifications and special provisions as are incorporated in these plans.

SUBMITTED BY ORDER OF THE STATE TRANSPORTATION BOARD
APPROVED S.J. Page DATE 2-2-81
DIRECTOR OF ENGINEERING AND CONSTRUCTION

DEPARTMENT OF TRANSPORTATION
FEDERAL HIGHWAY ADMINISTRATION
APPROVED _____ DATE _____
DIVISION ADMINISTRATOR

APPROVED _____ DATE 7-21-81
CHIEF, PROPERTY ADMINISTRATION

ELMORE BHS 0241(8)S
SHEET 1 OF 6 SHEETS