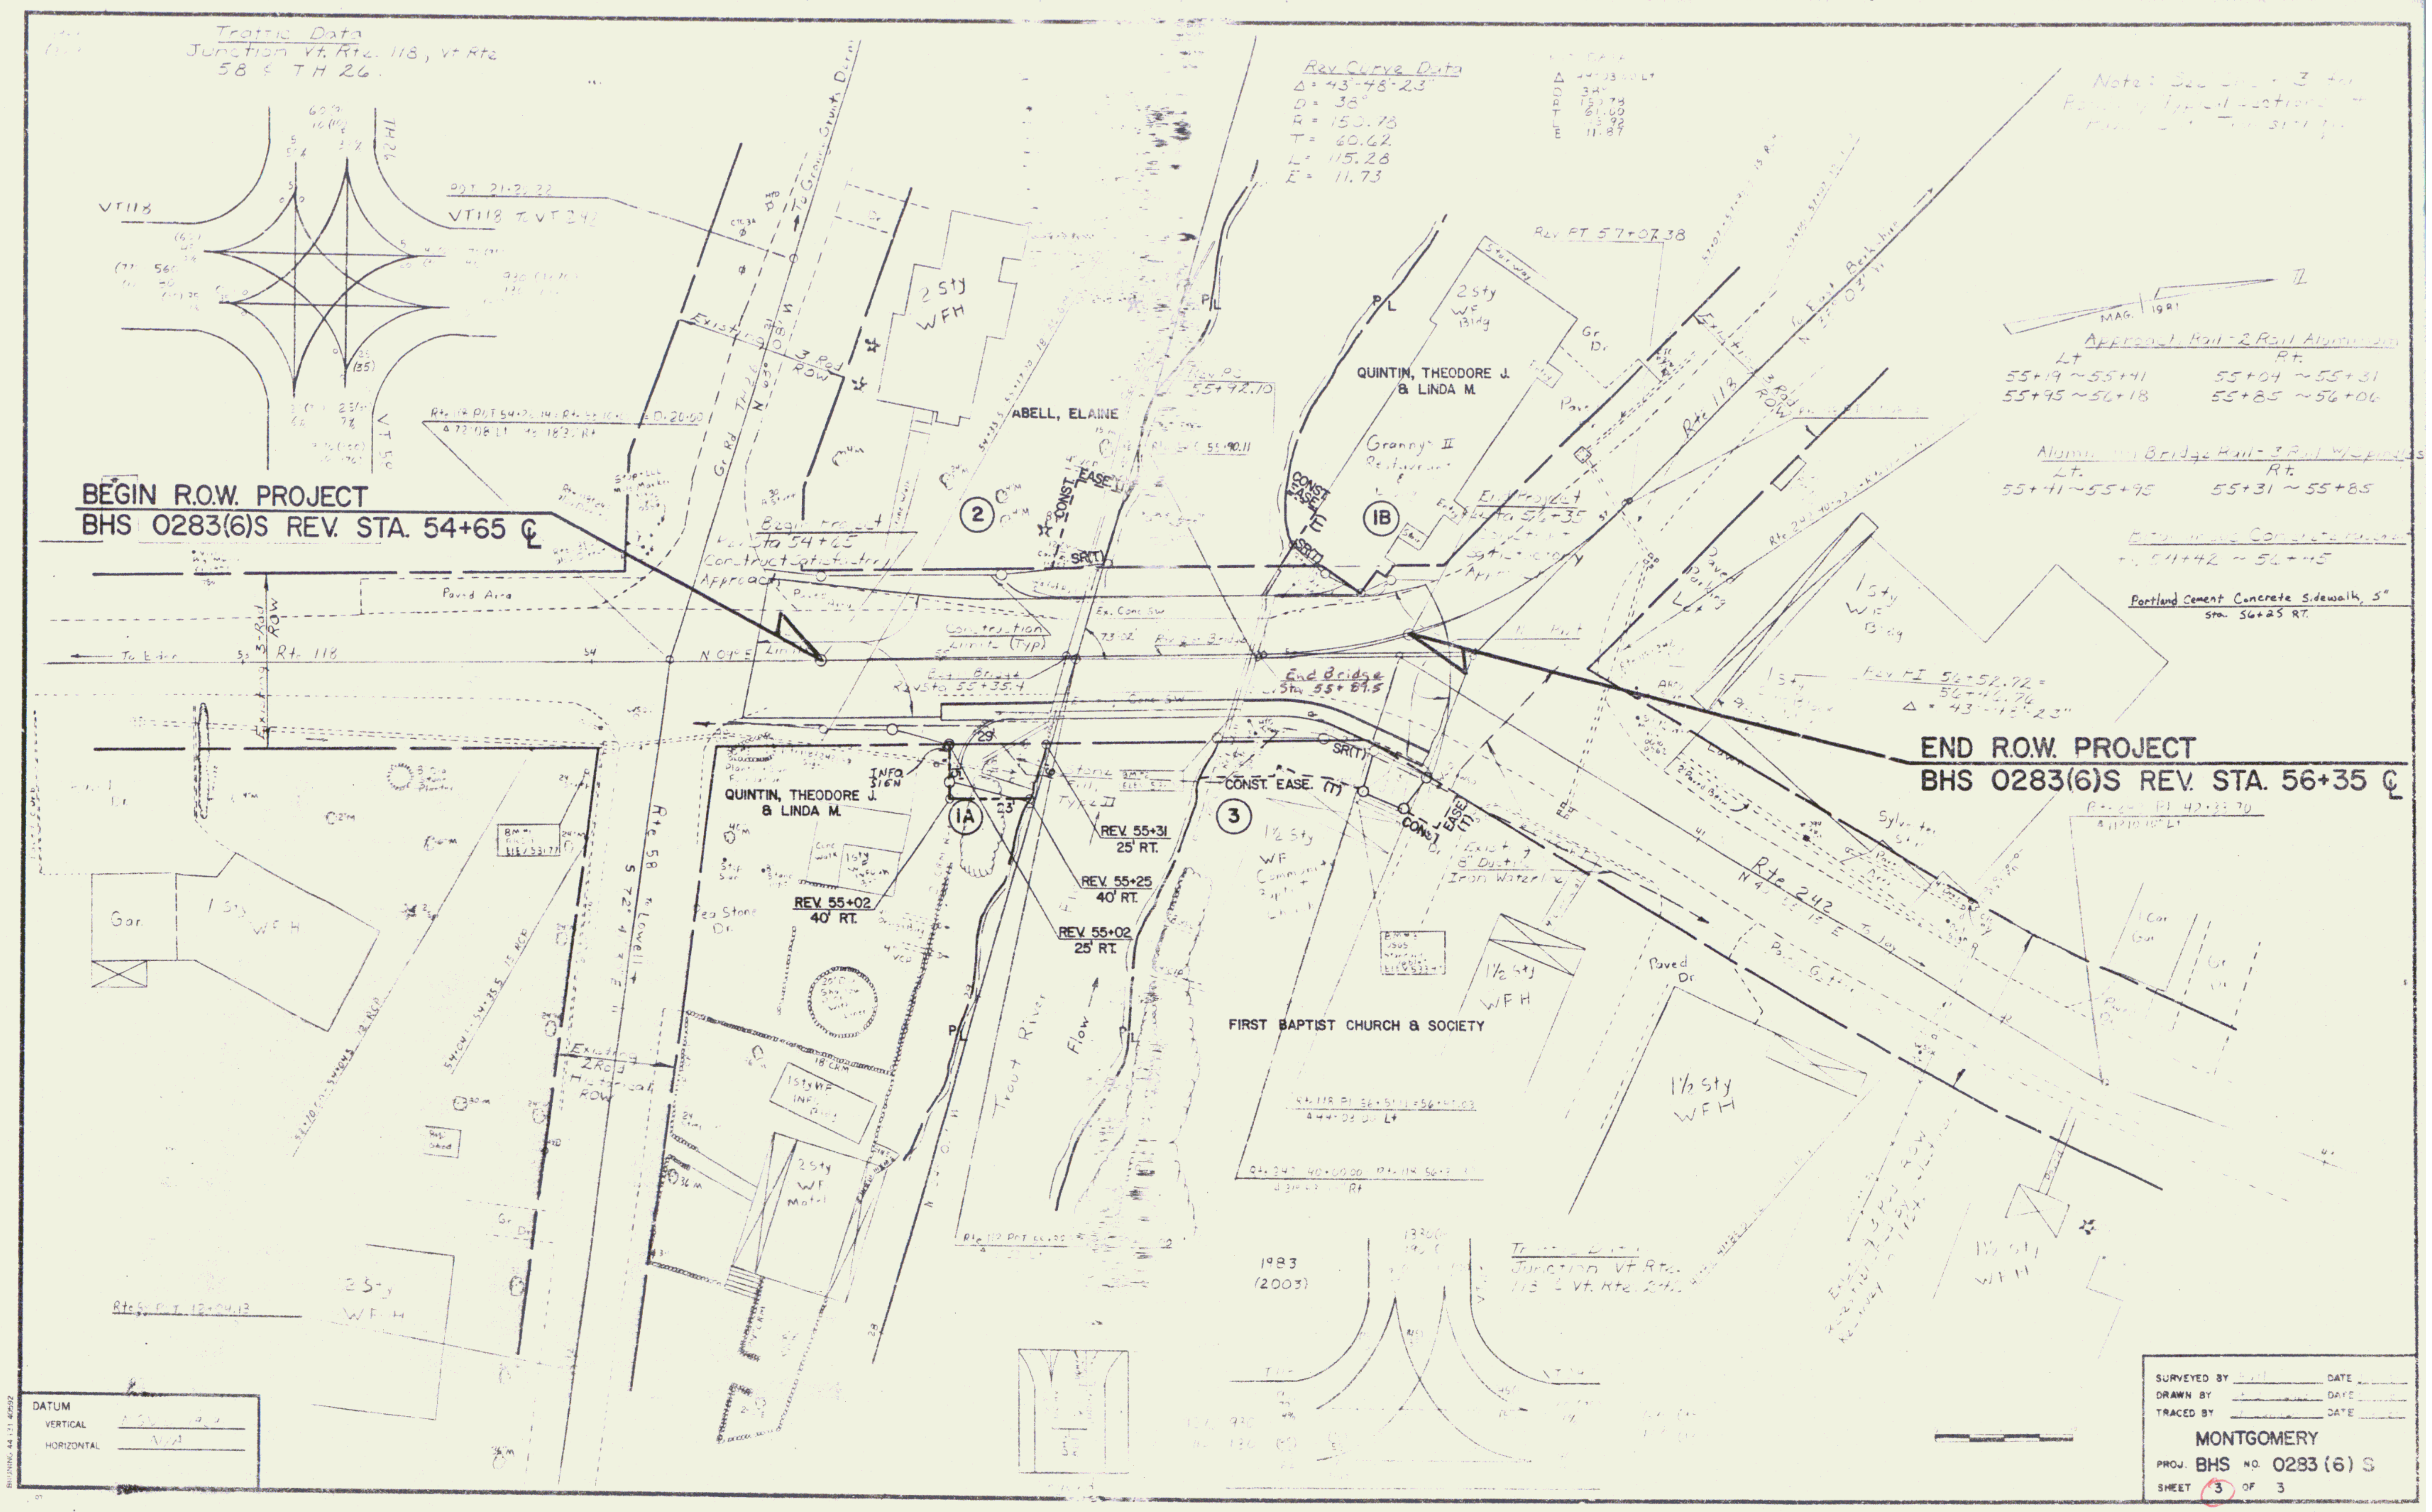
BEGIN R.O.W. PROJECT
BHS 0283(6)S REV. STA. 54+65 ℄
END R.O.W. PROJECT
BHS 0283(6)S REV. STA. 56+35 ℄
ABELL, ELAINE
QUINTIN, THEODORE J. & LINDA M.
QUINTIN, THEODORE J. & LINDA M.
FIRST BAPTIST CHURCH & SOCIETY
CONST. EASE. (T)
REV. 55+31 25' RT.
REV. 55+25 40' RT.
REV. 55+02 25' RT.
REV. 55+02 40' RT.
Rte 118
Rte 242
Trout River
Flow
Portland Cement Concrete Sidewalk, 5"
Sta. 56+25 RT.
1983
(2003)
DATUM
VERTICAL
HORIZONTAL
SURVEYED BY
DRAWN BY
TRACED BY
DATE
MONTGOMERY
PROJ. BHS NO. 0283 (6) S
SHEET 3 OF 3

2