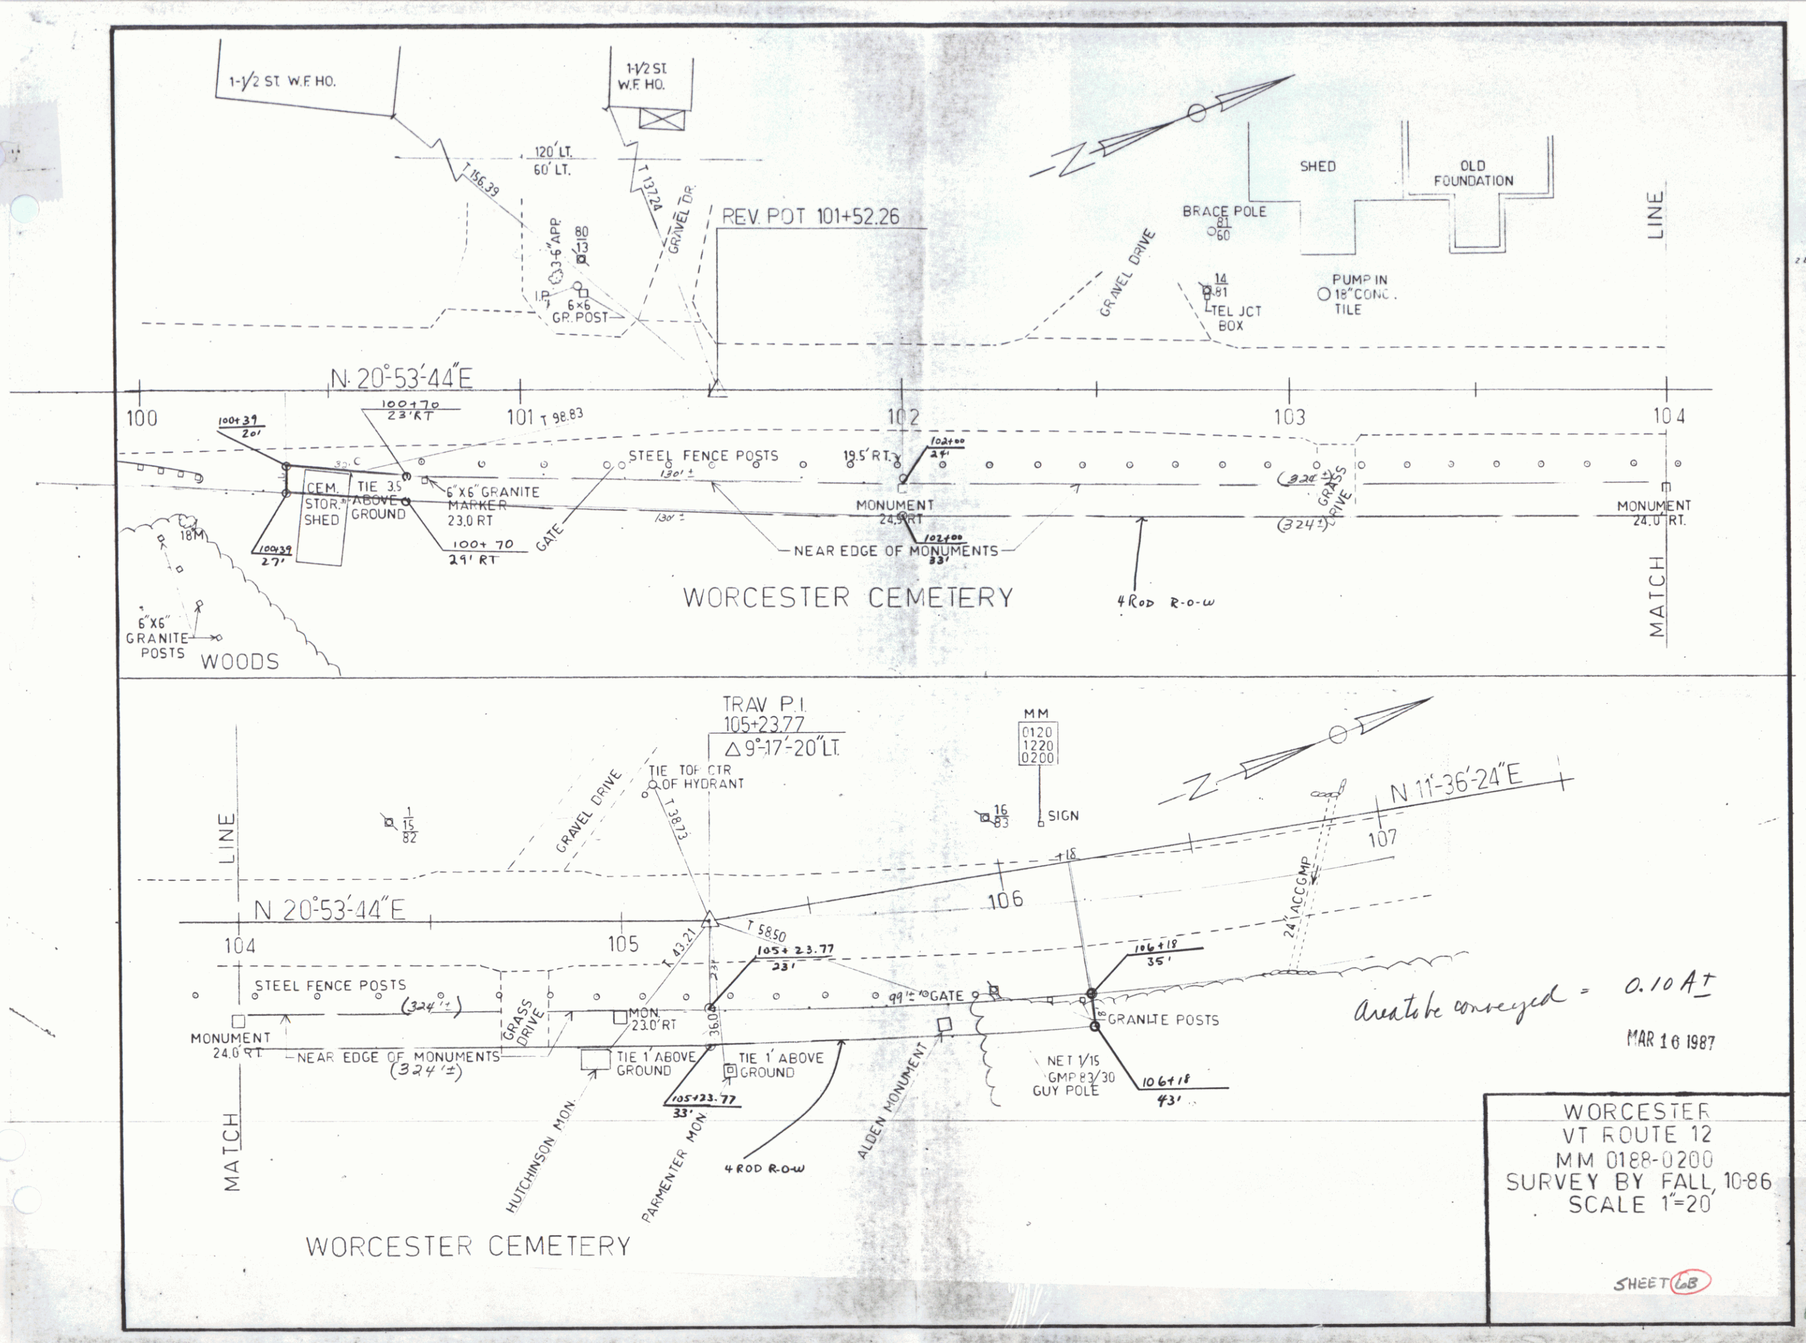

Area to be conveyed = 0.10 A±

MAR 16 1987

WORCESTER
VT ROUTE 12
MM 0188-0200
SURVEY BY FALL, 10-86
SCALE 1"=20

SHEET 6B

4