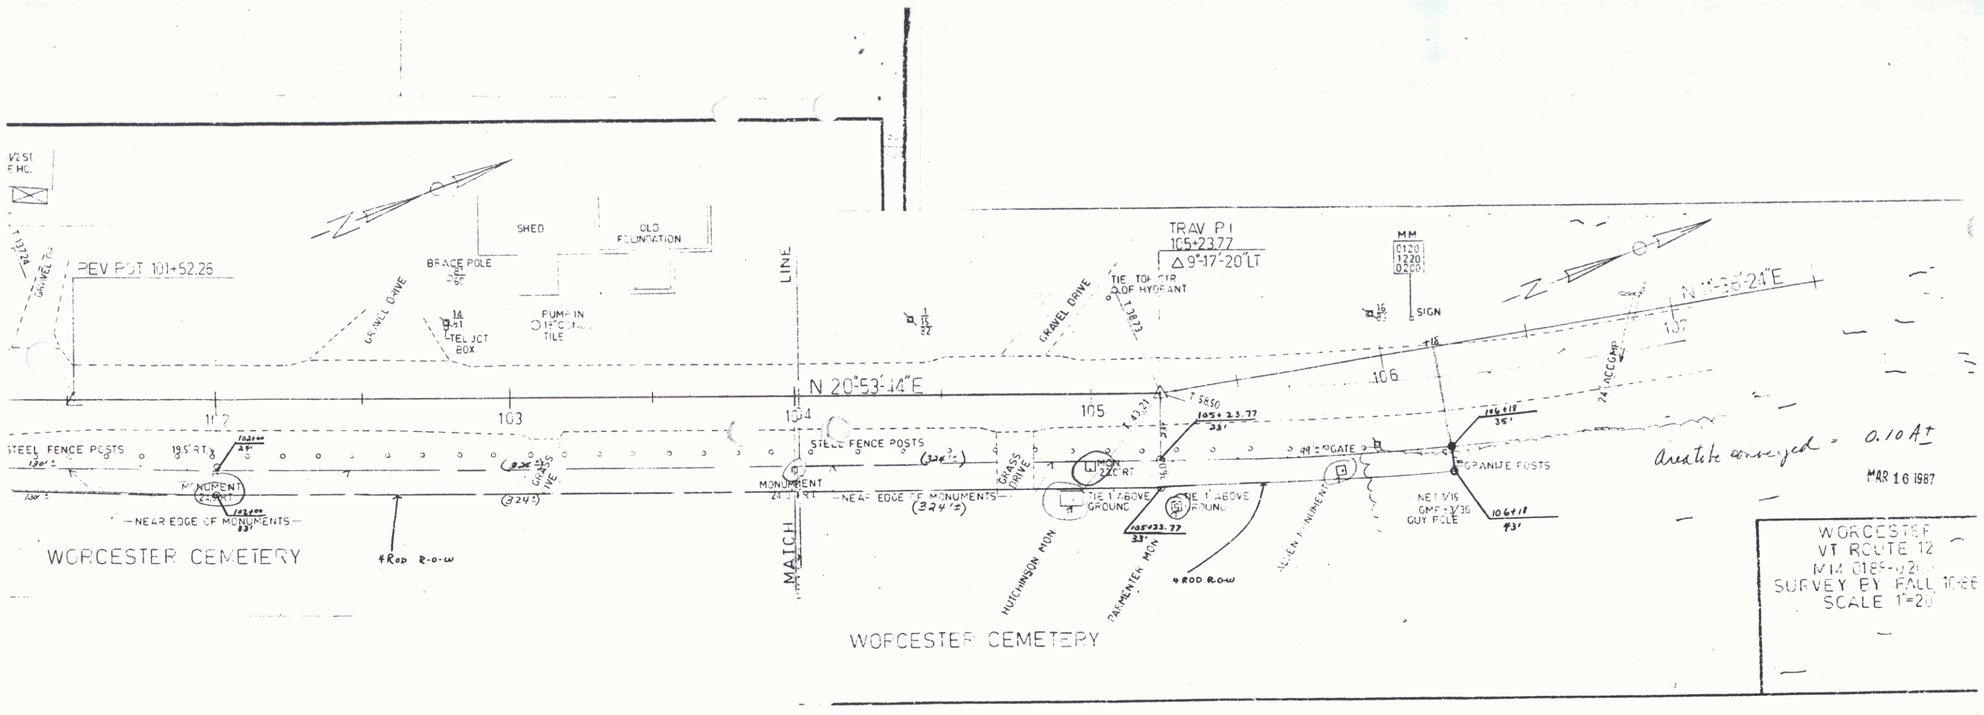

Acreage conveyed = 0.10 A±

MAR 16 1987

SHEET 6D

6