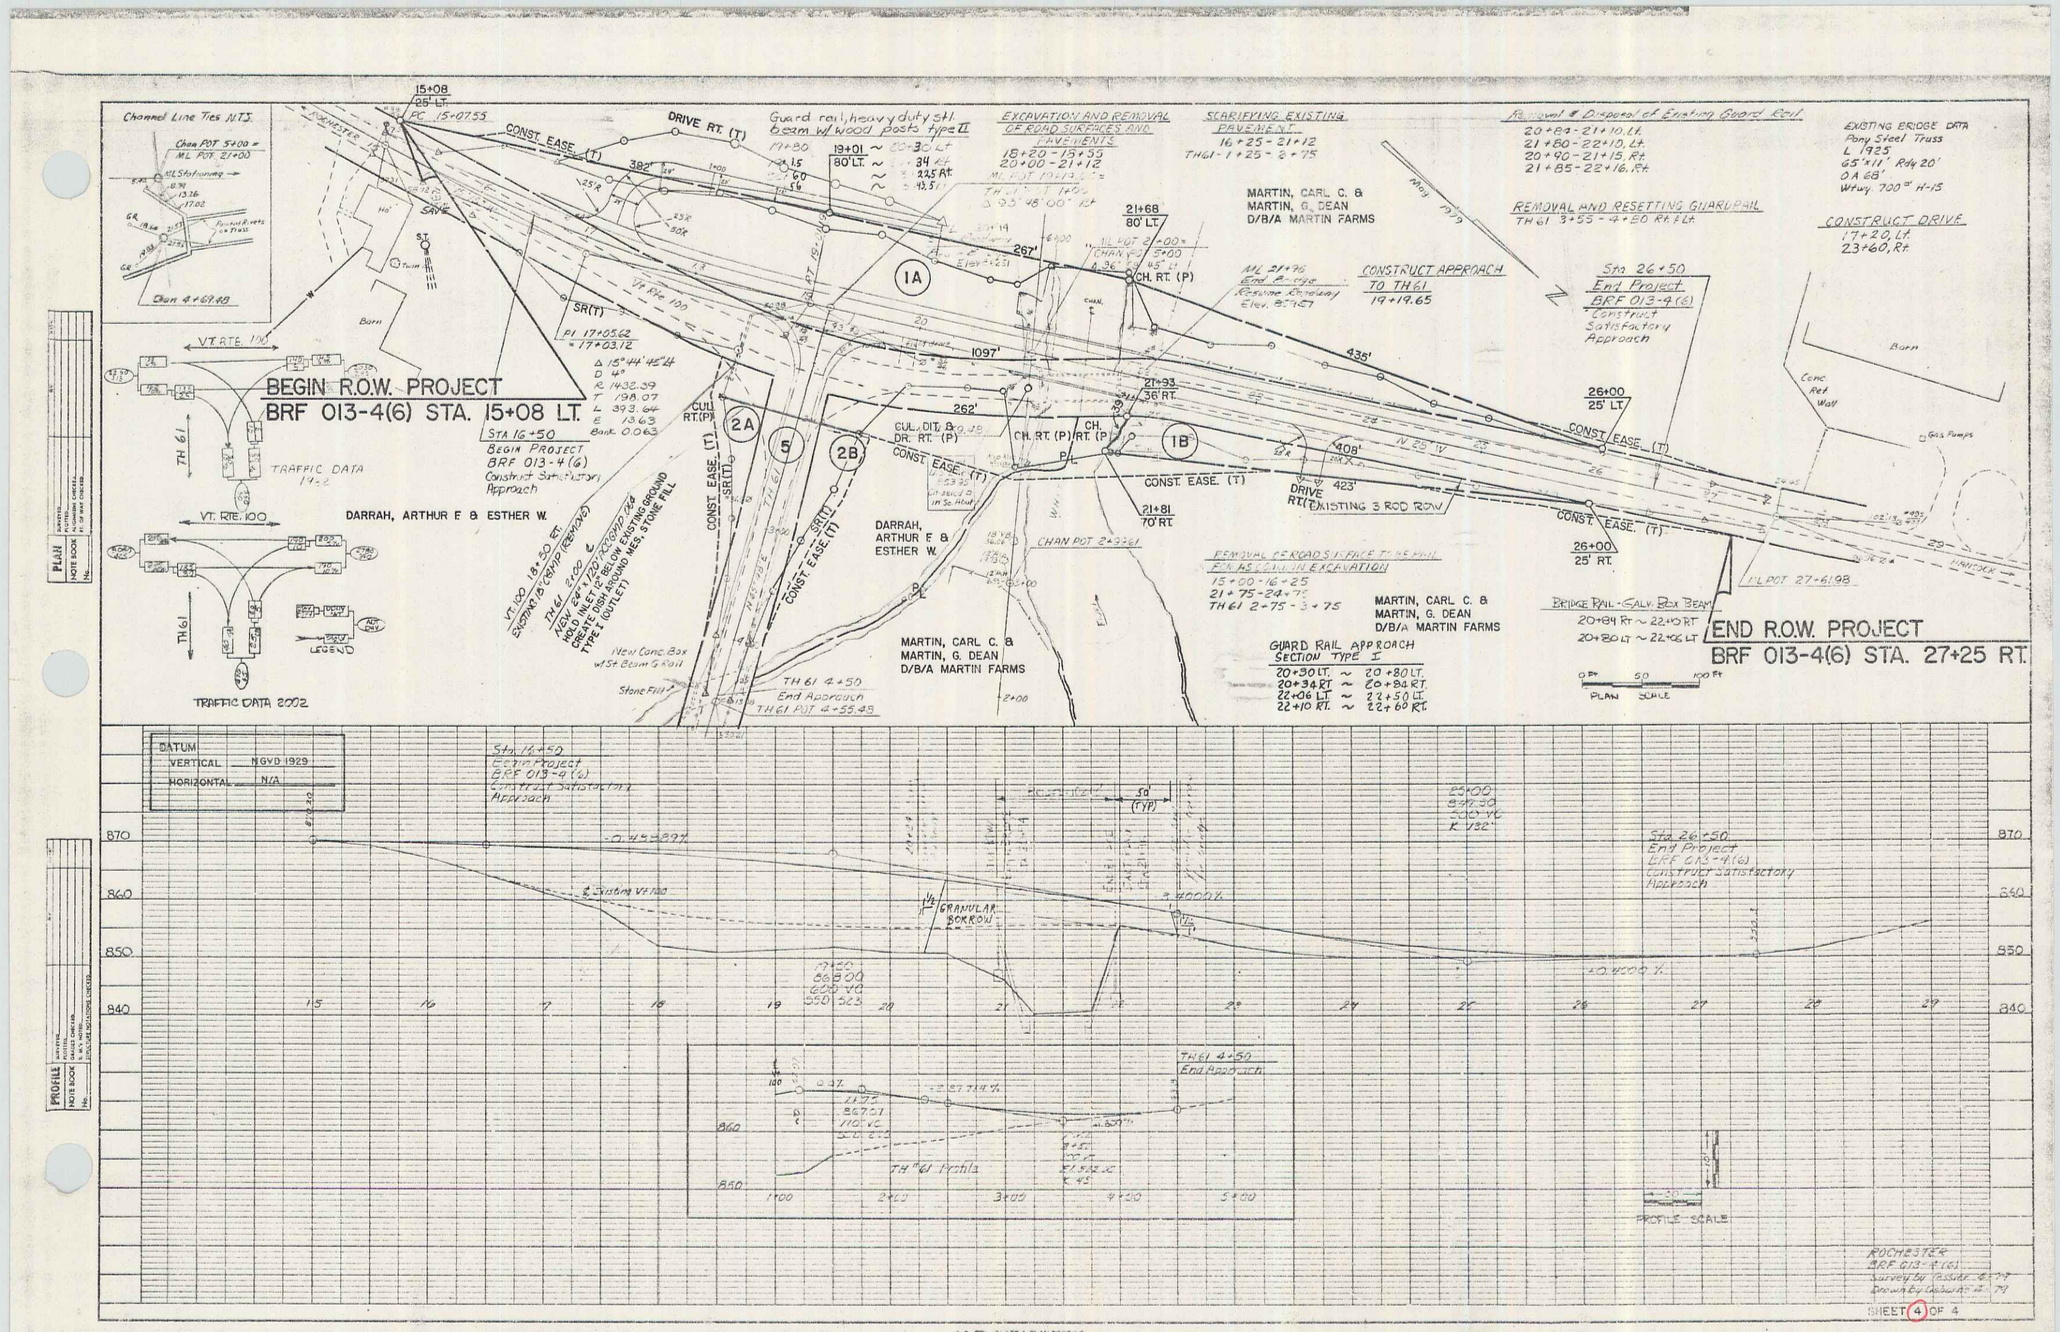
BEGIN R.O.W. PROJECT
BRF 013-4(6) STA. 15+08 LT.
END R.O.W. PROJECT
BRF 013-4(6) STA. 27+25 RT.
DARRAH, ARTHUR F & ESTHER W.
MARTIN, CARL C. & MARTIN, G. DEAN D/B/A MARTIN FARMS
TRAFFIC DATA 2002
TRAFFIC DATA 14-2
LEGEND
PLAN SCALE
PROFILE SCALE
TH 61 Profile
DATUM
VERTICAL NGVD 1929
HORIZONTAL N/A
ROCHESTER
BRF 013-4(6)
SHEET 4 OF 4