POOR ORIGINAL COPY

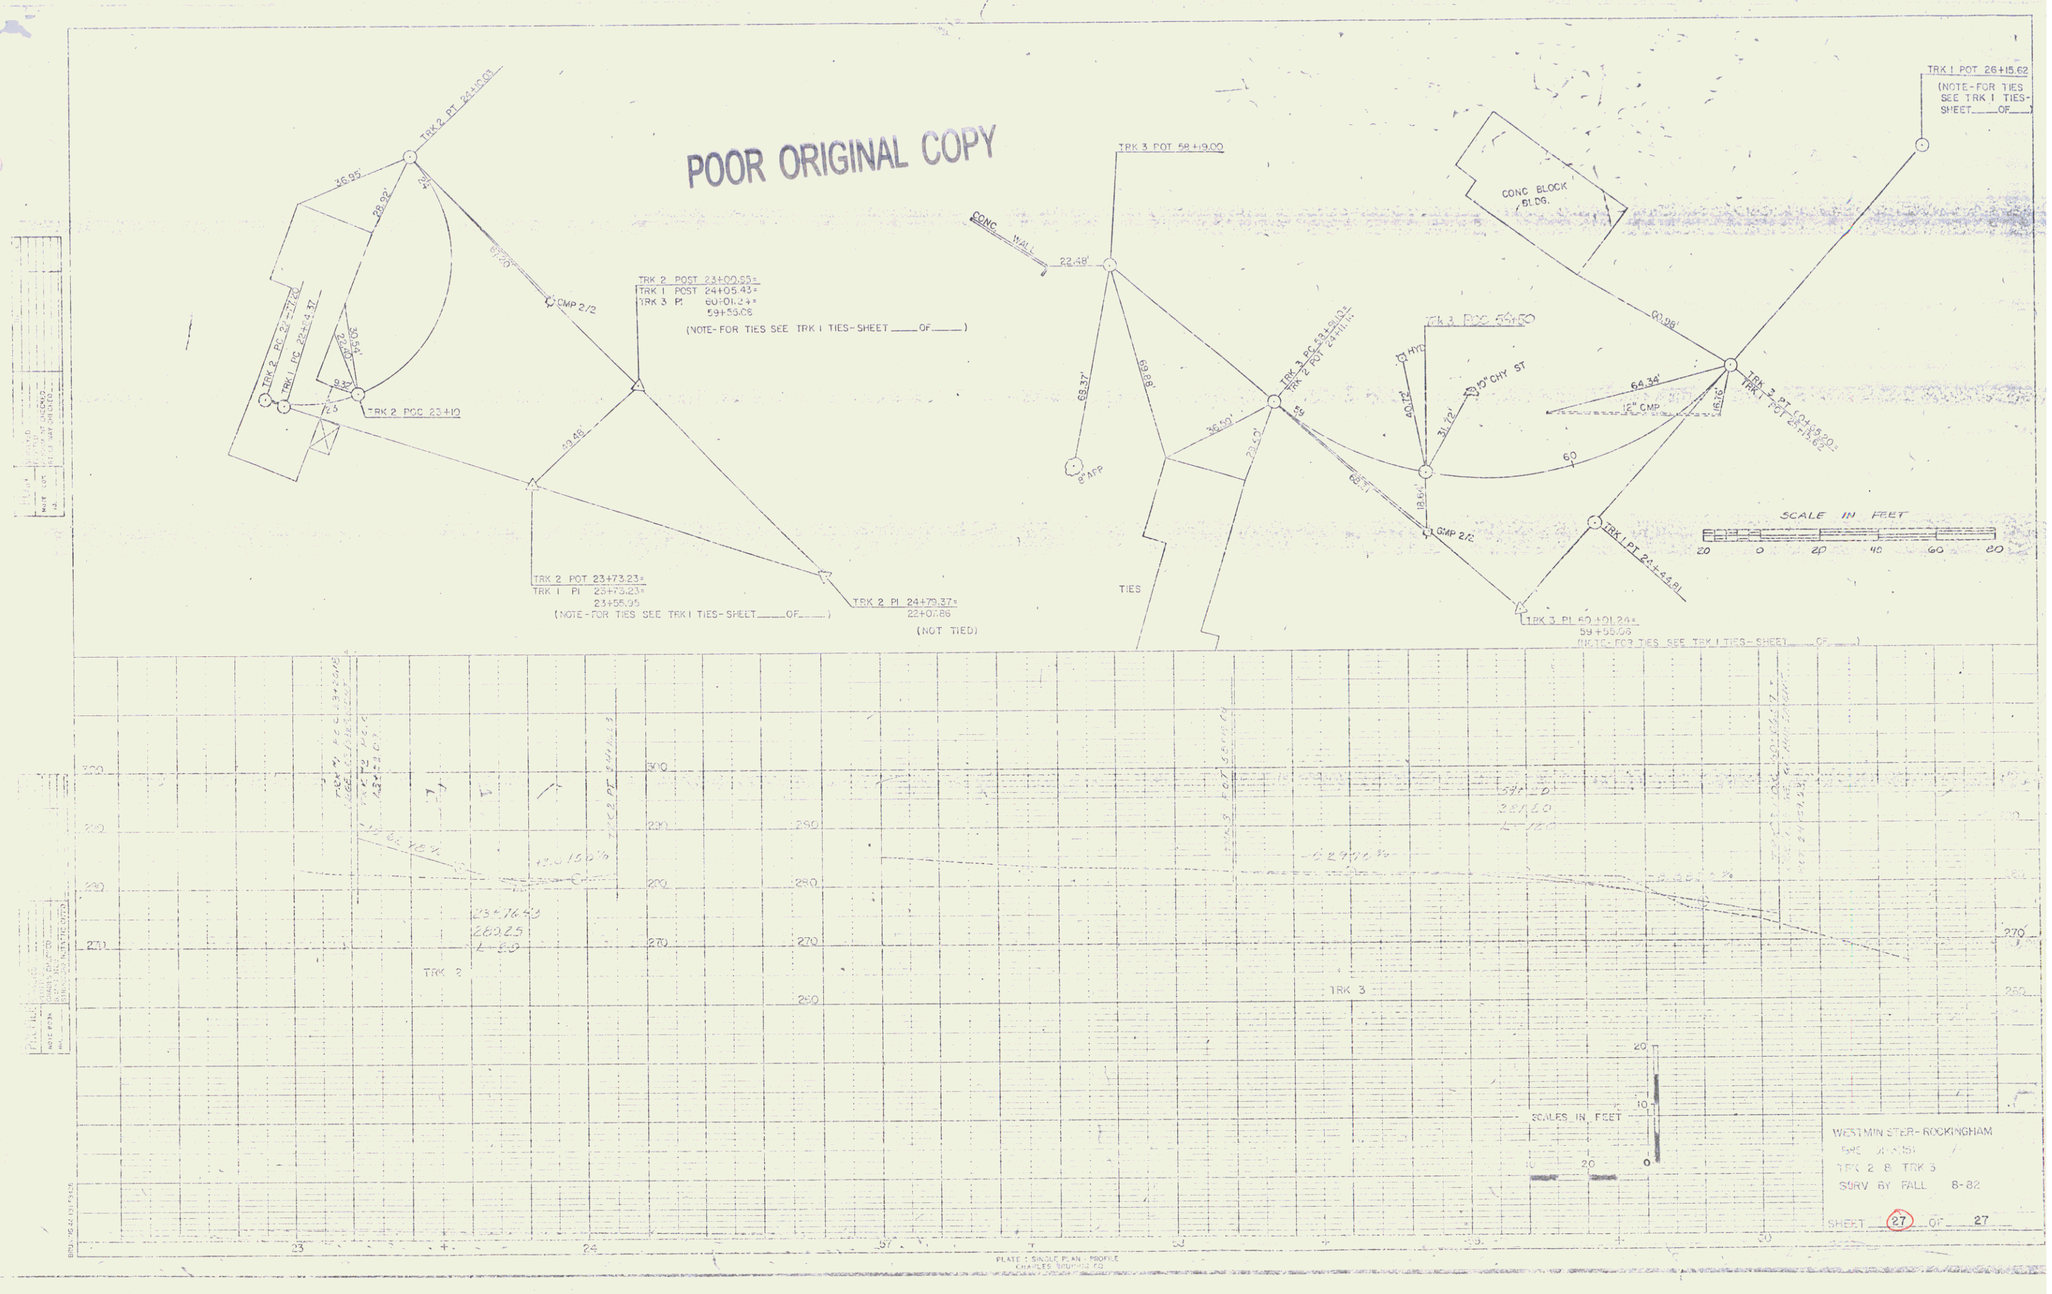

27