


CONSTRUCT DRIVE
STA 364+50 LT (GRAVEL)

REMOVAL AND DISPOSAL OF
EXISTING GUARD RAIL
364+38 ~ 364+77 RT.
364+60 ~ 364+81 LT.
365+21 ~ 365+60 LT.
365+30 ~ 365+70 LT.

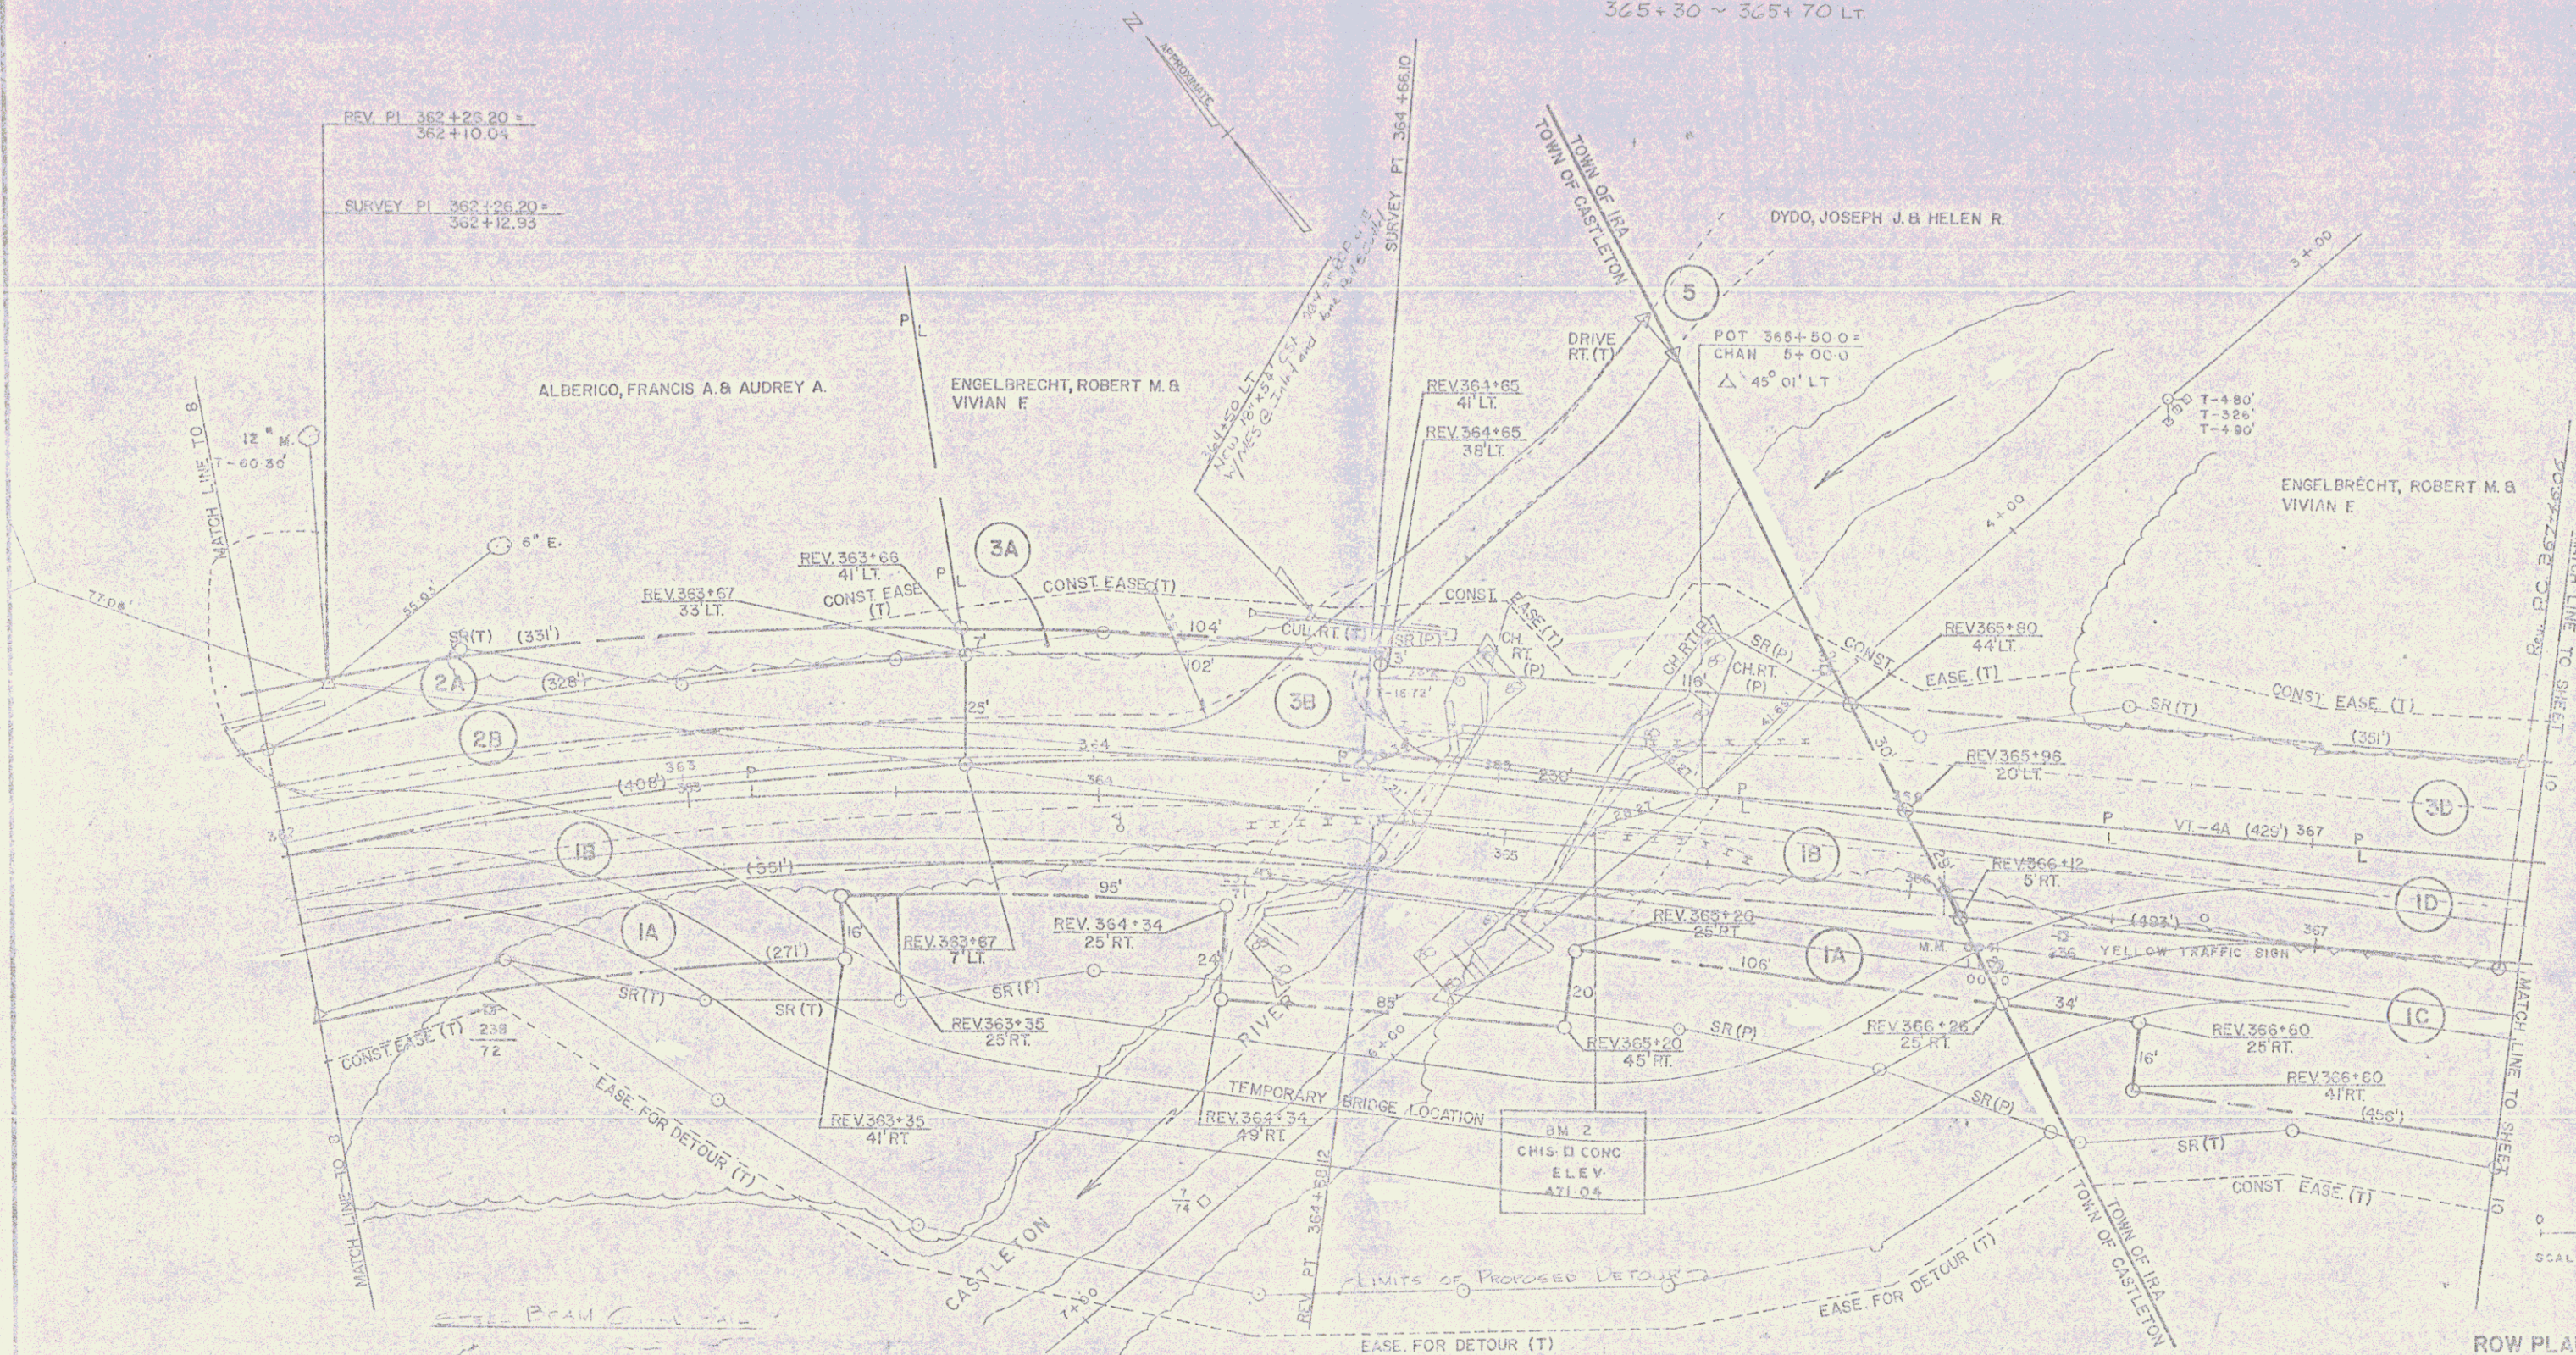

DATUM
VERTICAL NSVD 1929
HORIZONTAL N/A

BIRD M1 RESORT CORP.

ROW PLANS
362+00 ~ 367+50

SURVEYED BY FANTONI DATE 5/81
DRAWN BY FITZGERALD DATE 12/81
TRACED BY FITZGERALD DATE 12/81

CASTLETON - IRA
RS 0142 (12)
SHEET 9 OF 10