

EXCAVATION & REMOVAL OF ROAD SURFACE & PAVEMENT  
126+00 LT ~ 126+50 LT

CONSTRUCT DRIVE  
127+10 RT (40' WIDE) PAVED  
128+00 RT (40' WIDE) PAVED


GRANITE SLOPE EDGING  
STA STA  
126+76 ± RT ~ 126+90 ± RT  
127+30 ± RT ~ 127+80 ± RT  
128+20 ± RT ~ 129+50 ± RT

Guard Rail, Standard Steel Beam w/ Wood Posts, Type II  
126+00 RT ~ 126+27 RT

Breakaway Cable Terminal  
126+27 RT ~ 126+52 RT

DATE	
BY	
REVISION	
NO.	
DESCRIPTION	
DATE	

DATE	
BY	
REVISION	
NO.	
DESCRIPTION	
DATE	

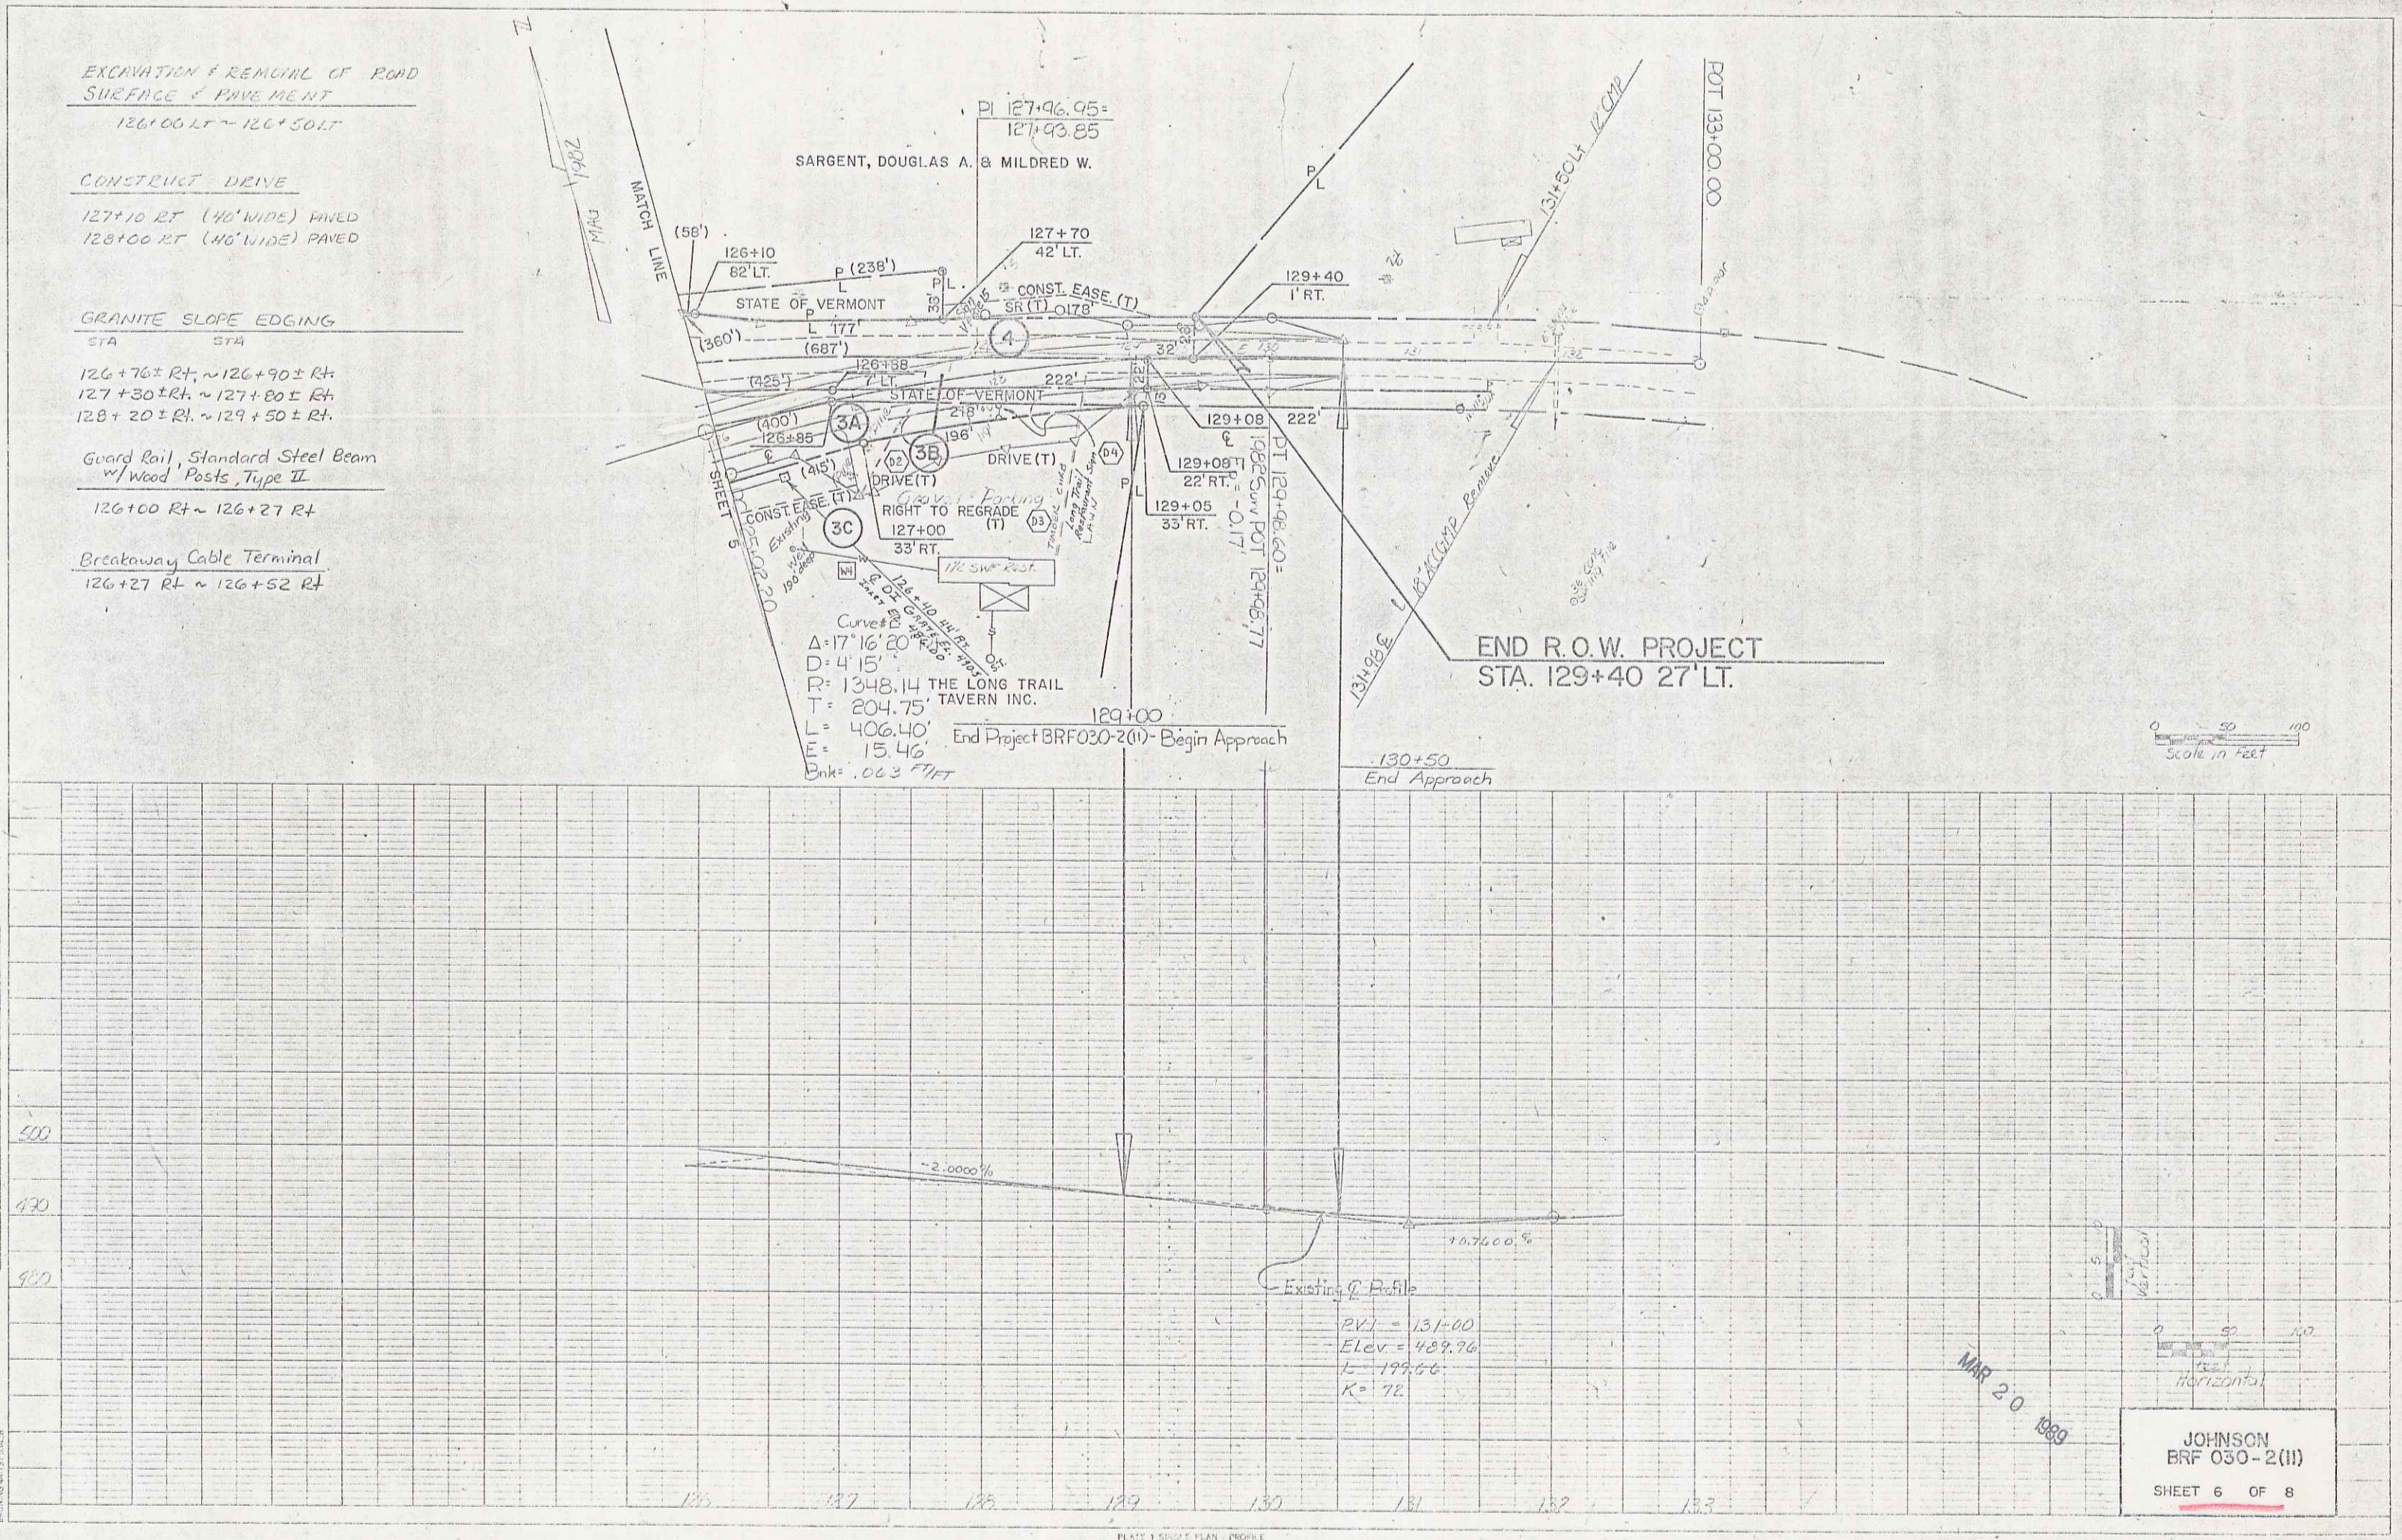

JOHNSON  
BRF 030-2(II)  
SHEET 6 OF 8

MAR 20 1989