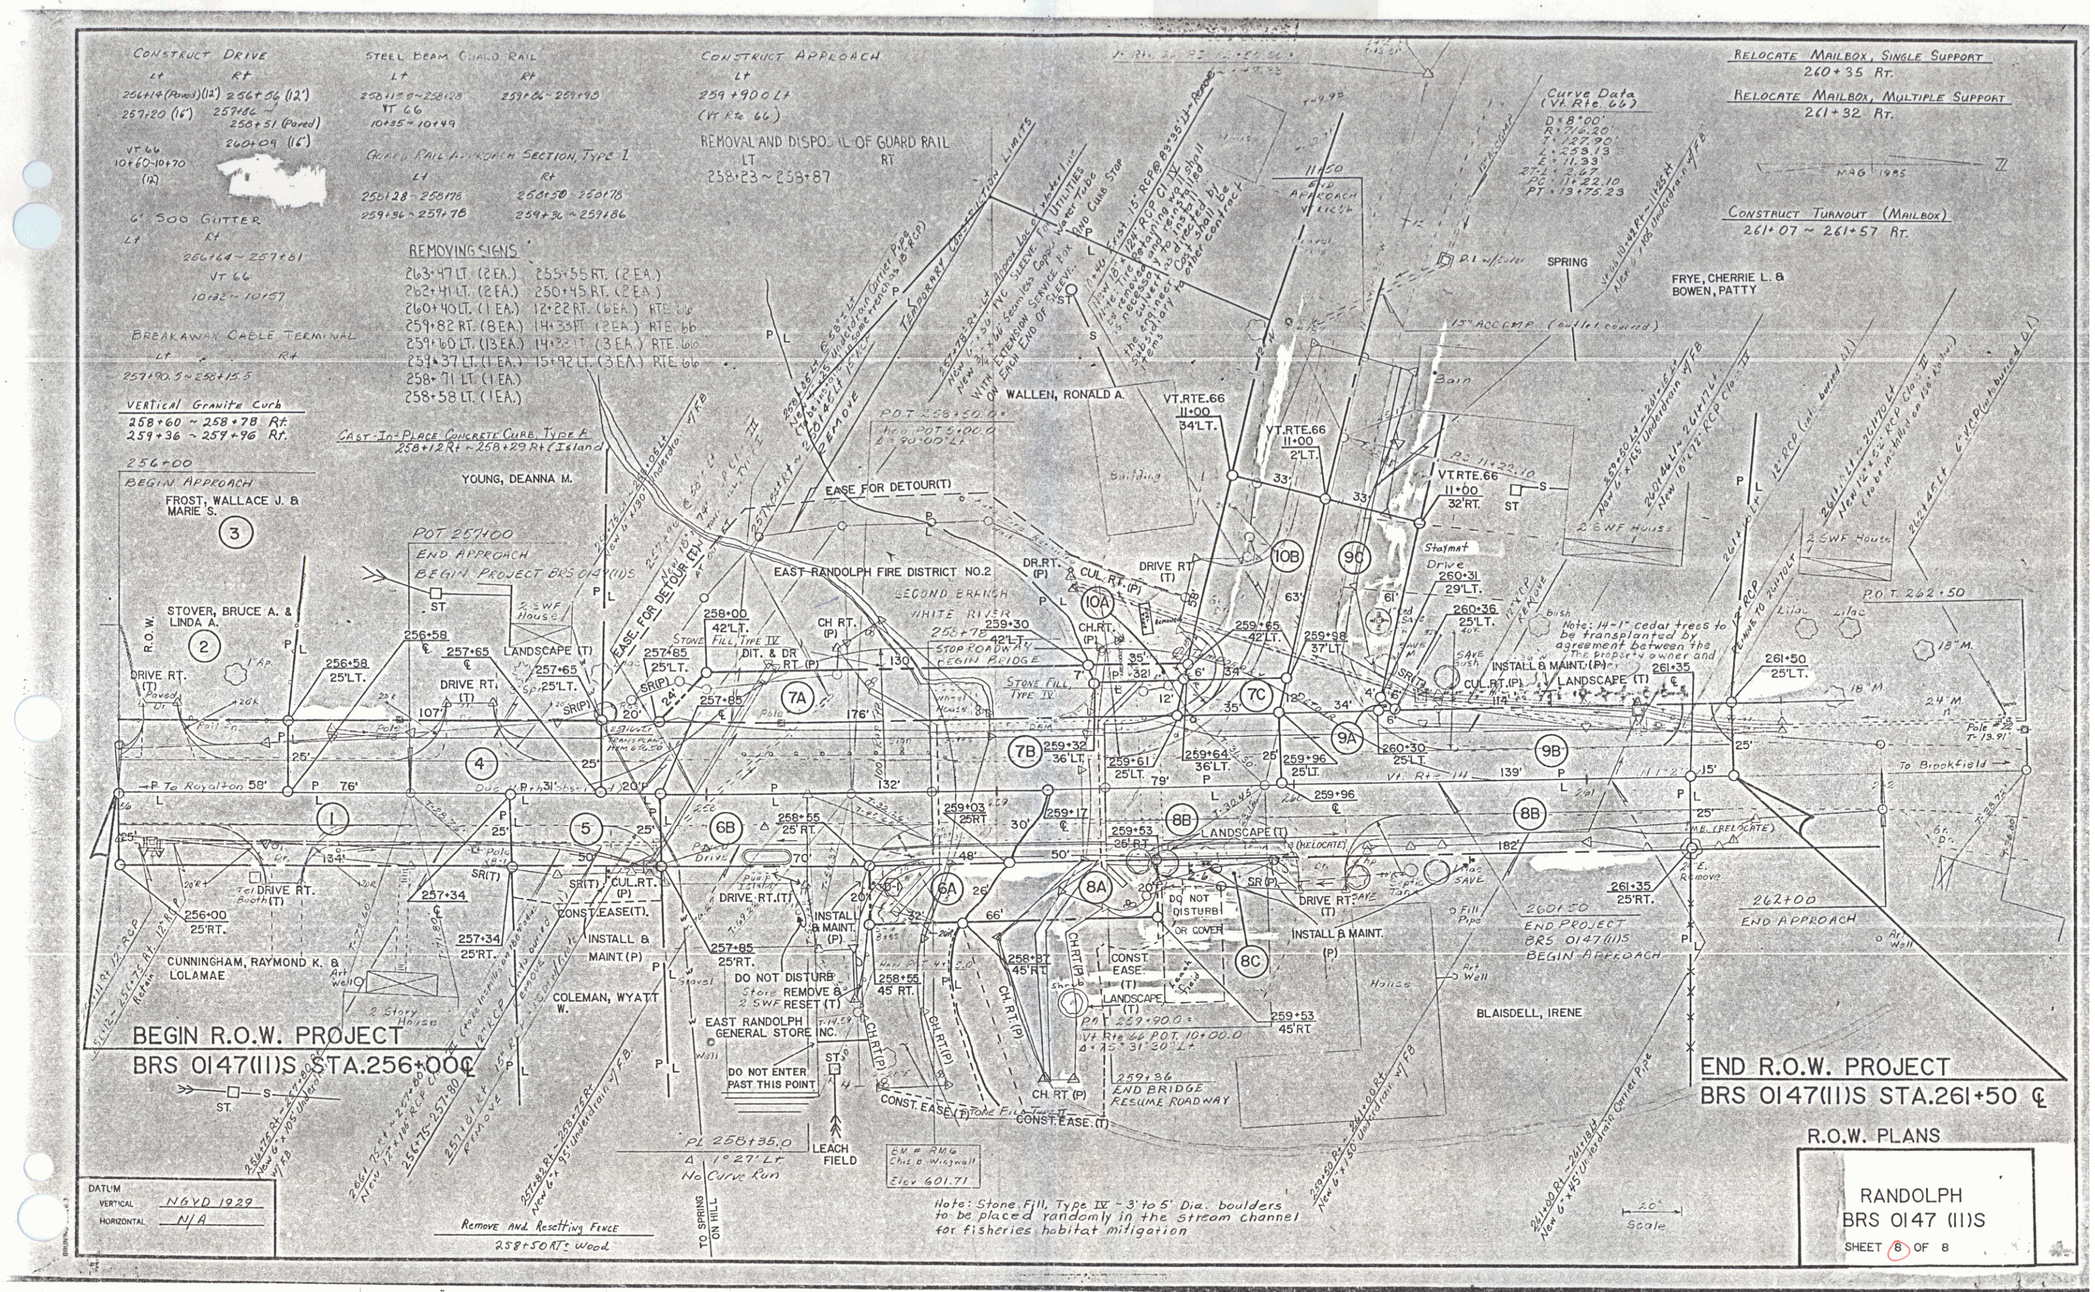

POOR ORIGINAL COPY

5