


DATE	
BY	
CHECKED	
DESIGNED	
APPROVED	
DATE	
BY	
CHECKED	
DESIGNED	
APPROVED	

DATE	
BY	
CHECKED	
DESIGNED	
APPROVED	
DATE	
BY	
CHECKED	
DESIGNED	
APPROVED	

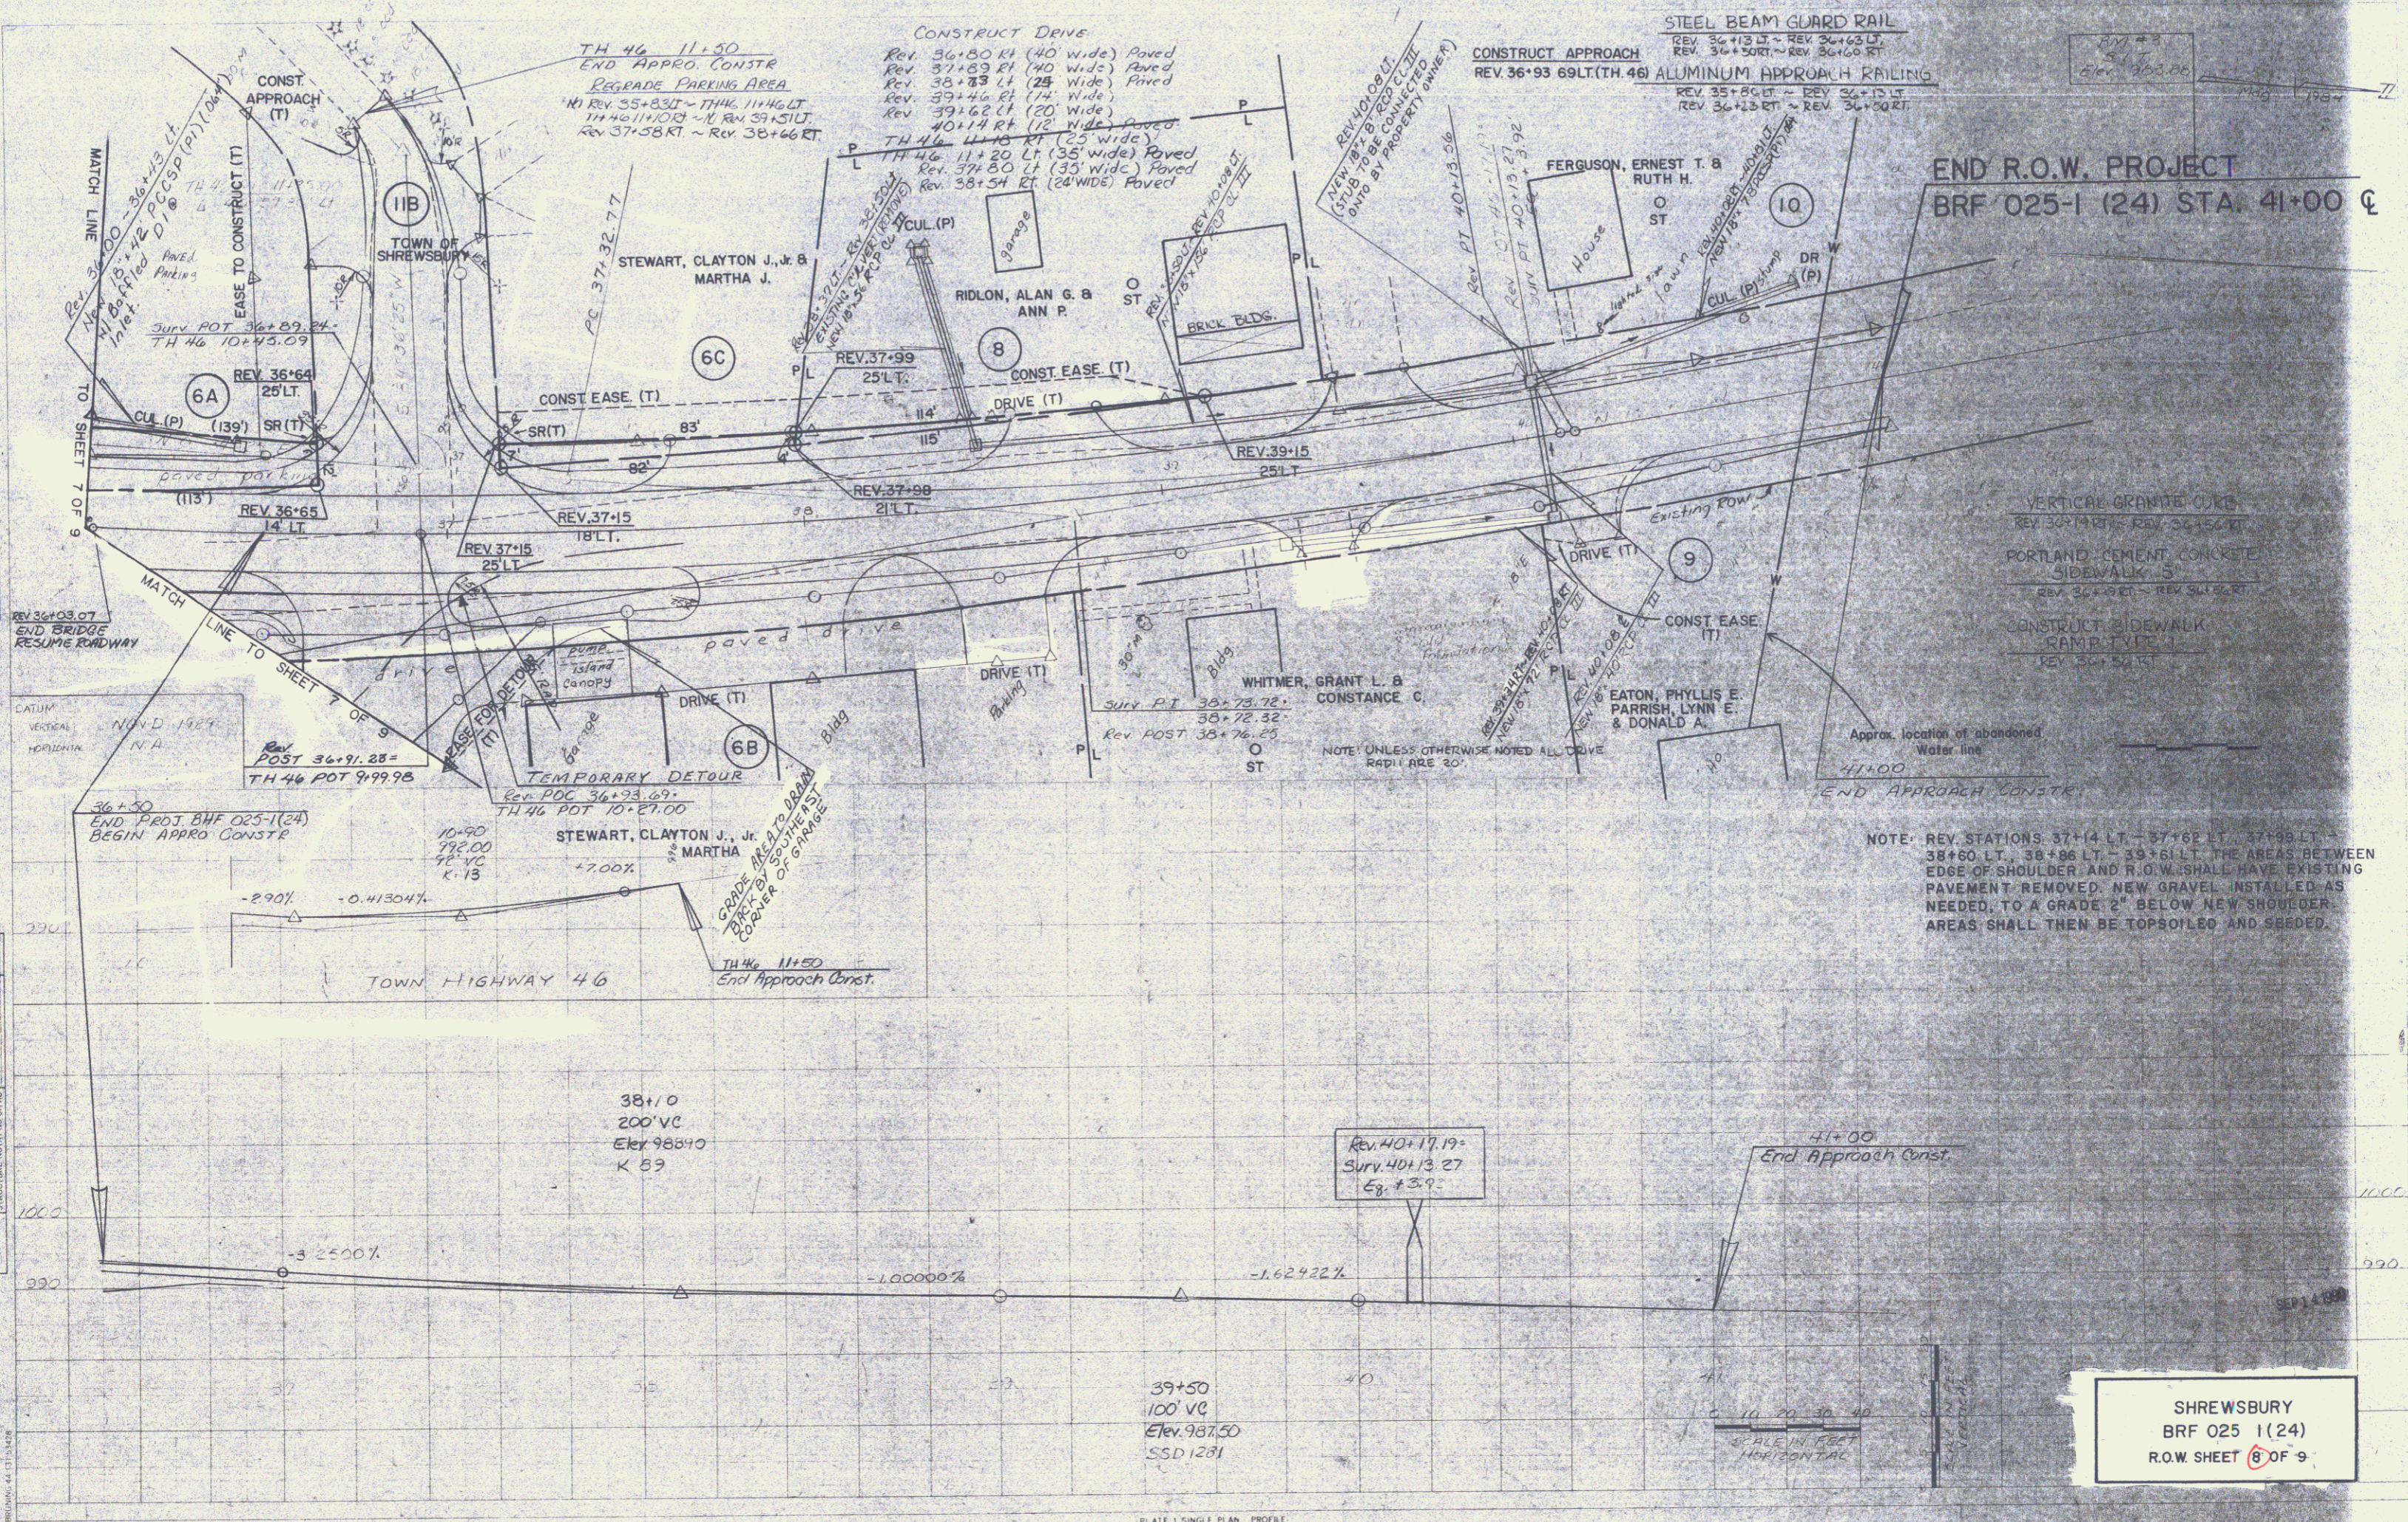

END R.O.W. PROJECT  
BRF 025-1 (24) STA. 41+00 ±

- VERTICAL GRANITE CURB  
REV. 36+14 RT - REV. 36+15 RT
- PORTLAND CEMENT CONCRETE  
SIDEWALK 5"  
REV. 36+00 RT - REV. 36+00 RT
- CONSTRUCT SIDEWALK  
RAMP 1/2" x 4"  
REV. 36+15 RT

NOTE: REV. STATIONS: 37+14 LT - 37+62 LT, 37+99 LT - 38+50 LT, 38+86 LT - 39+61 LT. THE AREAS BETWEEN EDGE OF SHOULDER AND R.O.W. SHALL HAVE EXISTING PAVEMENT REMOVED. NEW GRAVEL INSTALLED AS NEEDED TO A GRADE 2" BELOW NEW SHOULDER. AREAS SHALL THEN BE TOPSOILED AND SEED.

SHREWSBURY  
BRF 025 1(24)  
R.O.W. SHEET 6 OF 9

PLATE 1 SINGLE PLAN PROFILE  
PHARLES BRUNING CO.