


**BEGIN R.O.W. PROJECT**  
**F BR 031-1(9) STA. 120+50. 3' RT.**

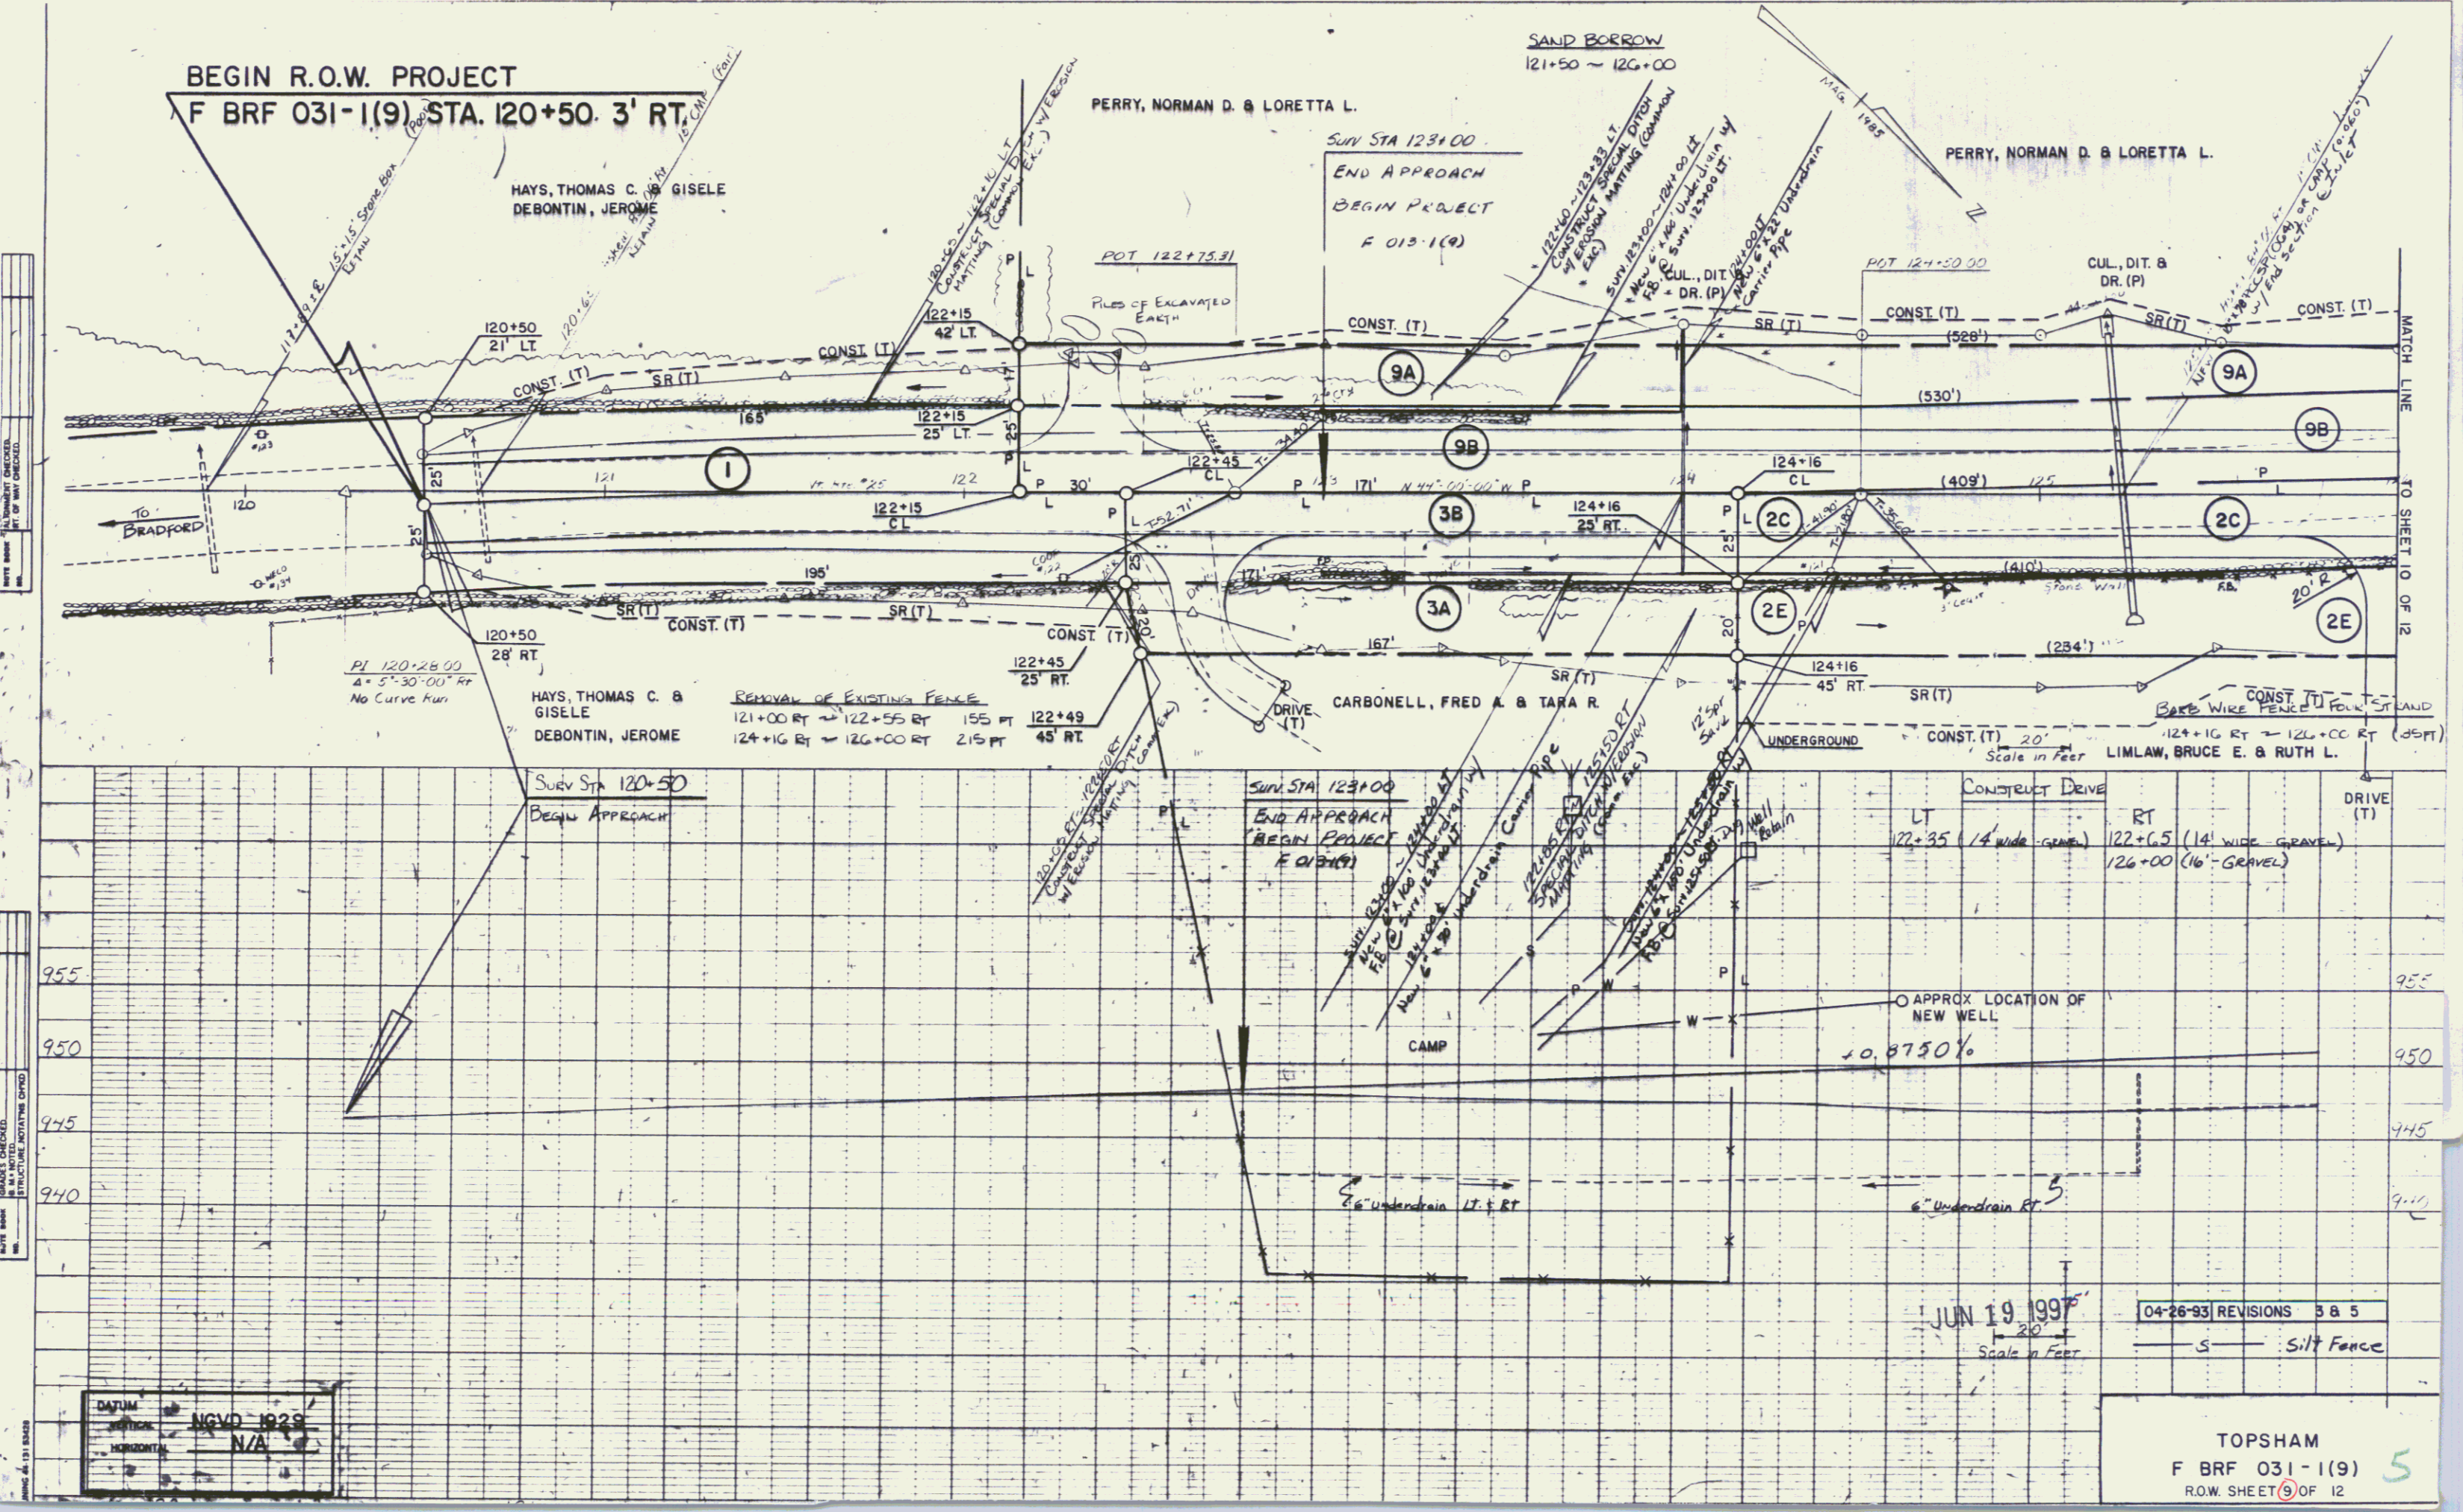



 HORIZONTAL: N/A

 Scale in Feet

04-26-93 REVISIONS 3 B 5  
 S Silt Fence

TOPSHAM  
 F BR 031-1(9) 5  
 R.O.W. SHEET 9 OF 12