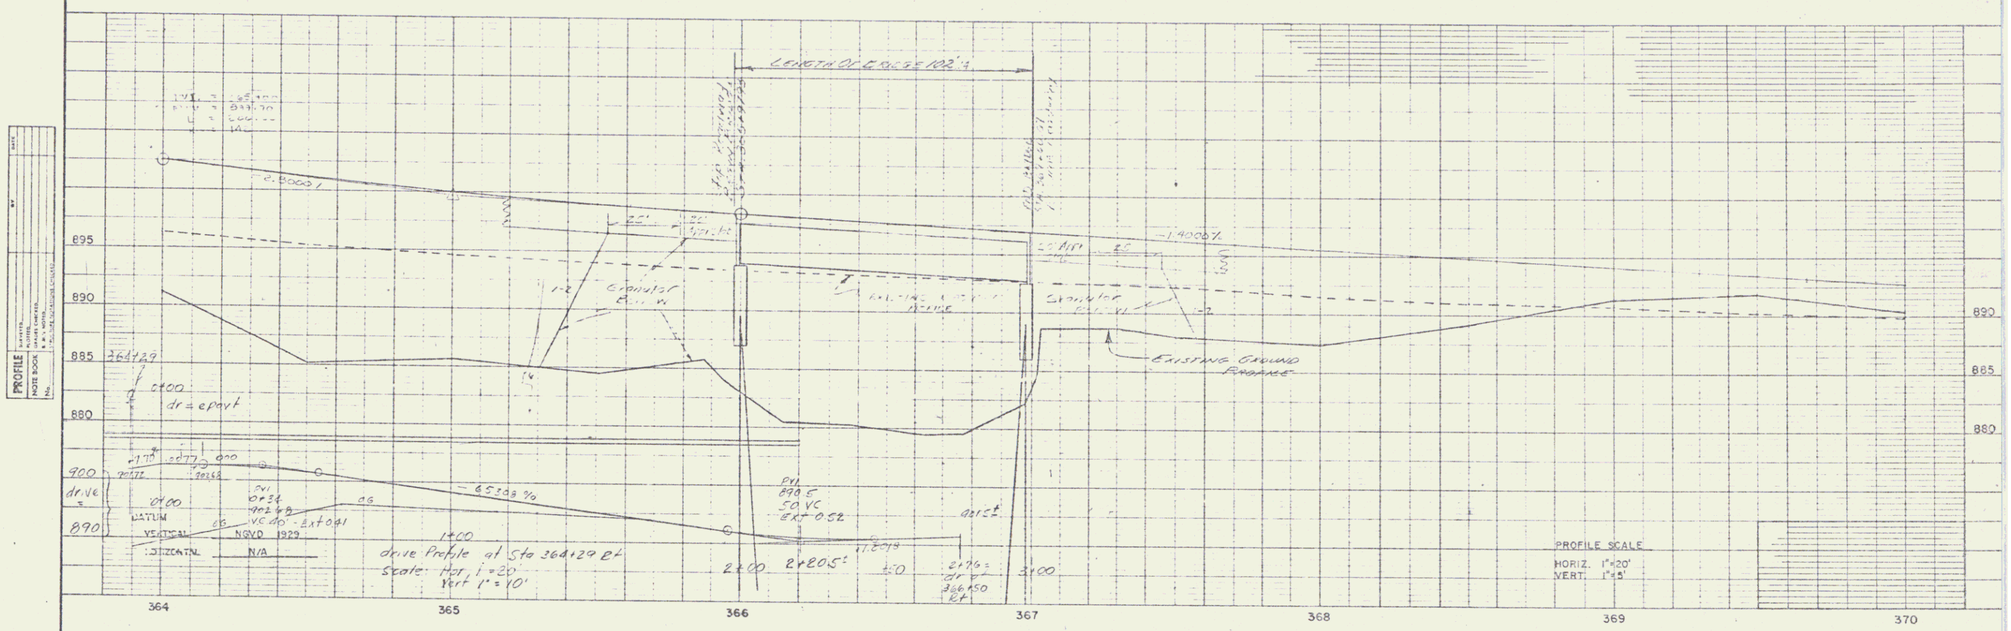

VT ROUTE 73

SURVEYED BY _____ DATE _____
DRAWN BY _____ DATE _____
TRACED BY _____ DATE _____

ROCHESTER

PROJ. FH-BRS NO. 0162(8) S

SHEET 8 OF 8

8