

Erosion Matting
94100 LT - 94105 LT

CONSTRUCT DRIVE
94+25 LT (16' PAVED)
95+50 RT (30' GRAVEL)
96+30 LT (16' GRAVEL)
98+00 LT (12' GRAVEL)


Removal of Existing Guard Rail
95+87 RT - 97+00 RT

Breakaway Cable Terminal
95+51 LT - 95+82 LT

Steel Beam Guards
95+82 LT - 97+00 RT

4' Island w/ Granite Slope Edging
94+00 ~ 95+35 RT
Note: Slope Edging to be
Set with a 4" Reveal

CURVE DATA
D 1' 30"
T 138.39'
L 276.67'
F 2.51'

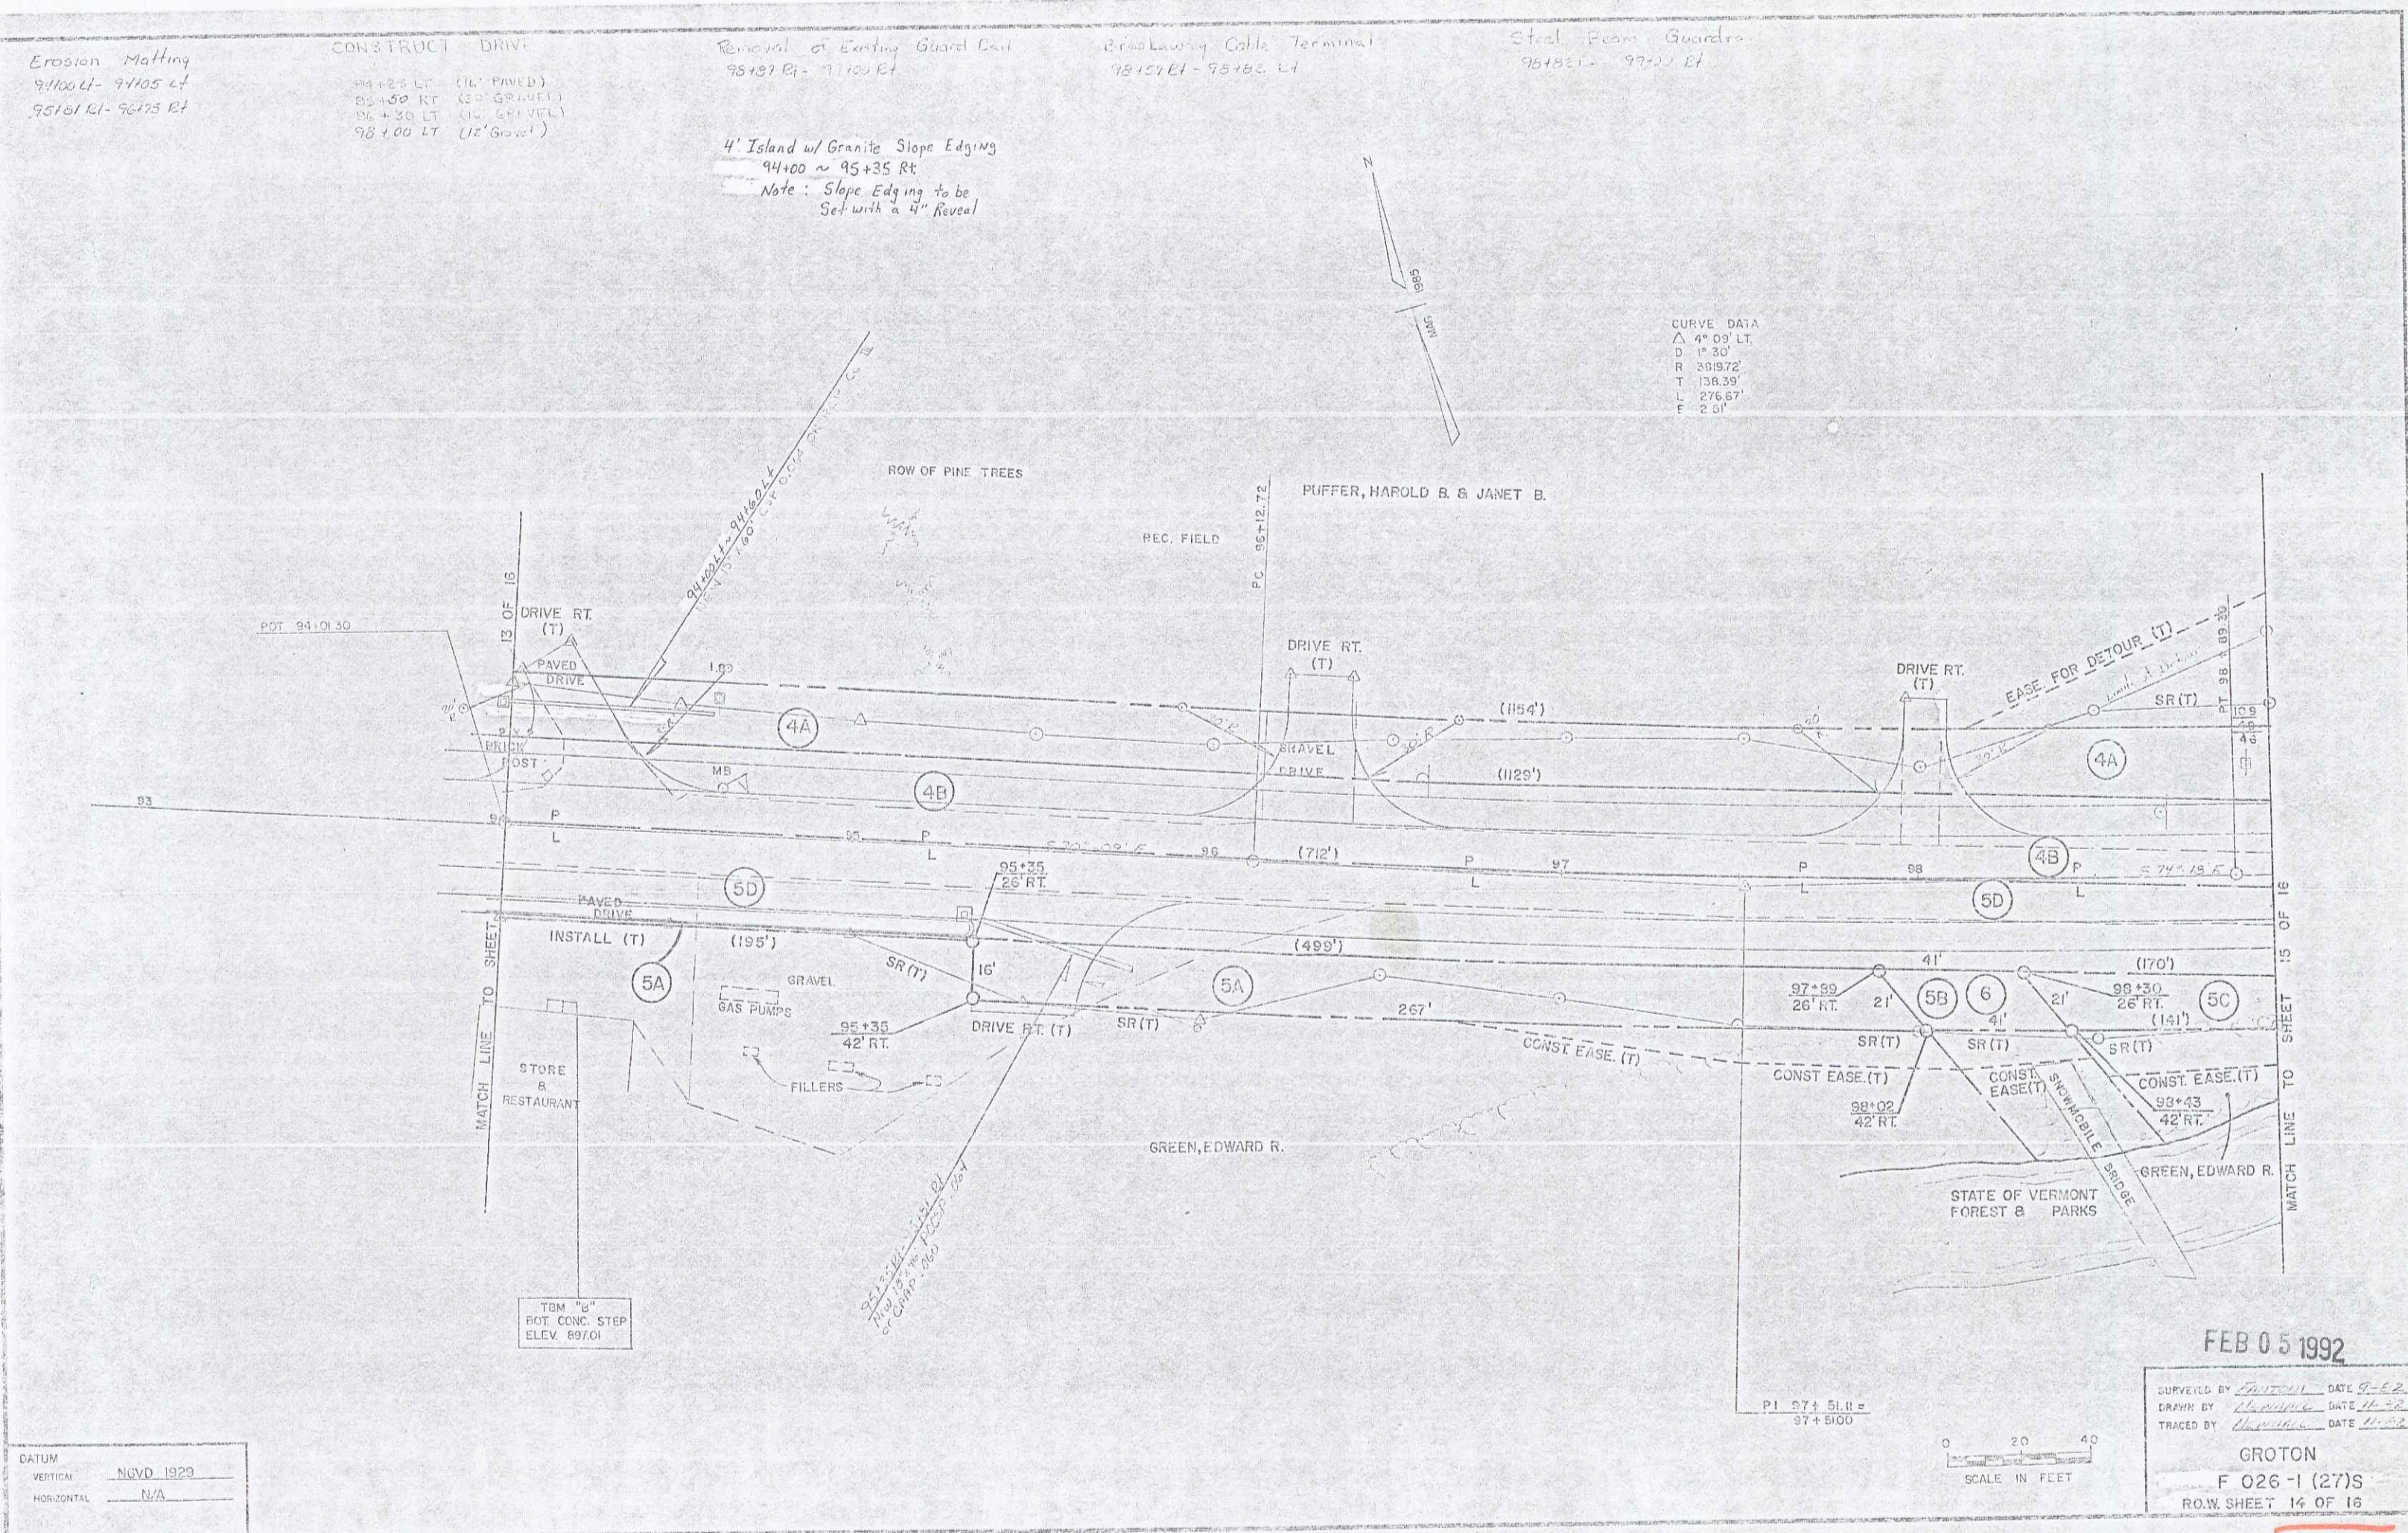

DATUM
VERTICAL NGVD 1929
HORIZONTAL N/A


SCALE IN FEET
0 20 40

FEB 05 1992
GROTON
F 026-1 (27)S
R.O.W. SHEET 14 OF 16