Original Drawing – Ink on Polyester film meeting the requirements of 27 V.S.A. § 1403

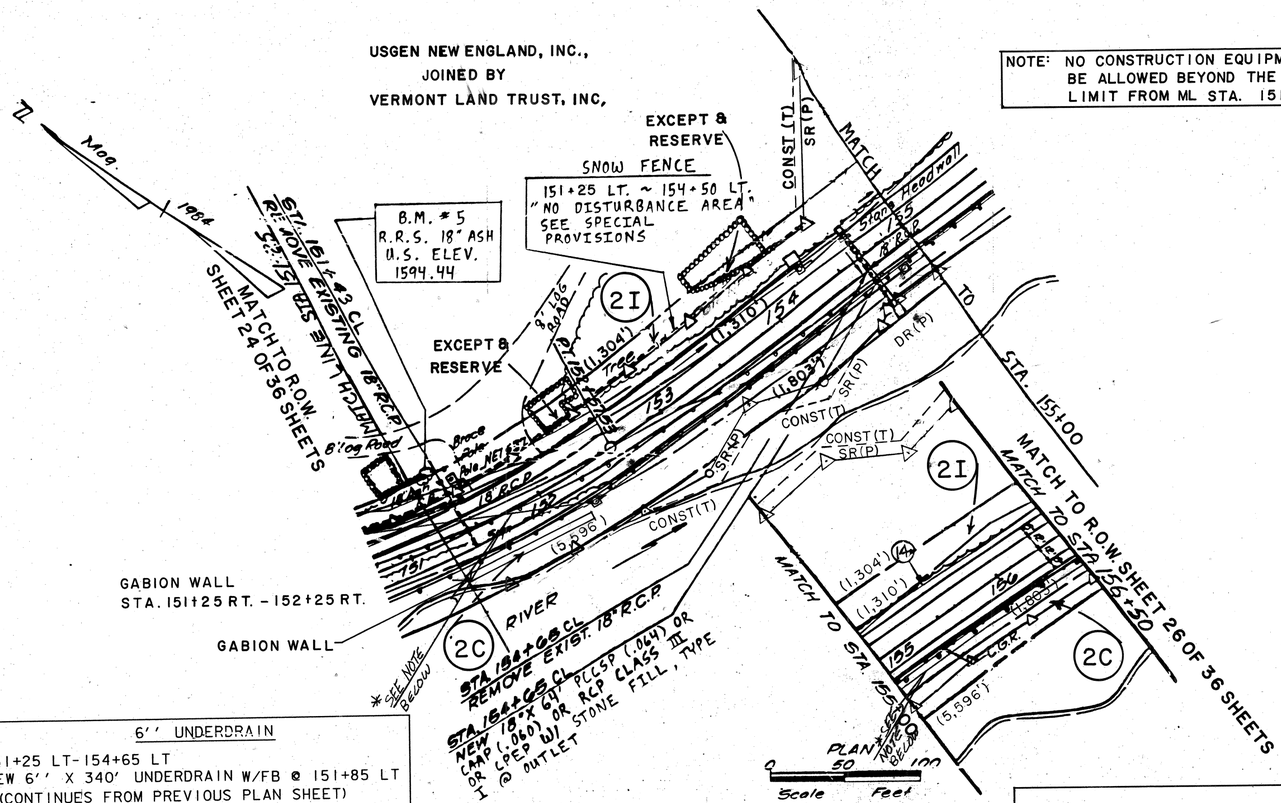

NOTE: NO CONSTRUCTION EQUIPMENT SHALL BE ALLOWED BEYOND THE TOE OF SLOPE LIMIT FROM ML STA. 151+25 LT-154+50 LT.

6'' UNDERDRAIN

⑬ 151+25 LT- 154+65 LT
NEW 6'' X 340' UNDERDRAIN W/FB @ 151+85 LT
(CONTINUES FROM PREVIOUS PLAN SHEET)

⑭ 154+70 LT- 157+00LT
NEW 6'' X 230' UNDERDRAIN W/FB @ 154+70 LT

NOTE: ON NEXT PLAN SHEET THE UNDERDRAIN NUMBERING SKIPS ⑮ AND ⑯ AND RESUMES WITH ⑰

USGEN NEW ENGLAND, INC.,
JOINED BY
VERMONT LAND TRUST, INC.

*NOTE: APPROX. AERIAL RELOC. ROUTE BY GMP, NEES, NET, HYPERION

LINES SHOWN ON THIS PLAN AS EXISTING PROPERTY LINES (P/L) ARE BELIEVED TO BE ACCURATE BUT SHOULD NOT BE RELIED UPON FOR PURPOSES UNRELATED TO THE STATE OF VERMONT'S ACQUISITION OF LAND AND RIGHTS FOR THIS PROJECT.

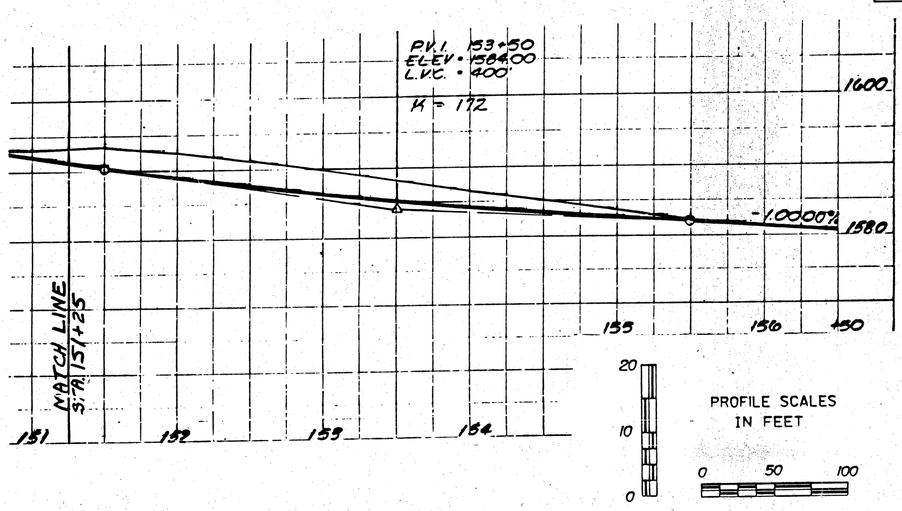

REVISED

PROJECT NAME: SEARSBURG - WILMINGTON
PROJECT NUMBER: NHF 010-1(18)

PLOT FILE NAME: DD096L05
PROJECT LEADER: DELLA SANTA
DESIGN FILE: 78D096/DESIGN/DD096CBR.DGN
PLOT DATE: 07-OCT-2000
DRAWN BY: SQUAD B

ROW SHEET 25 OF 36