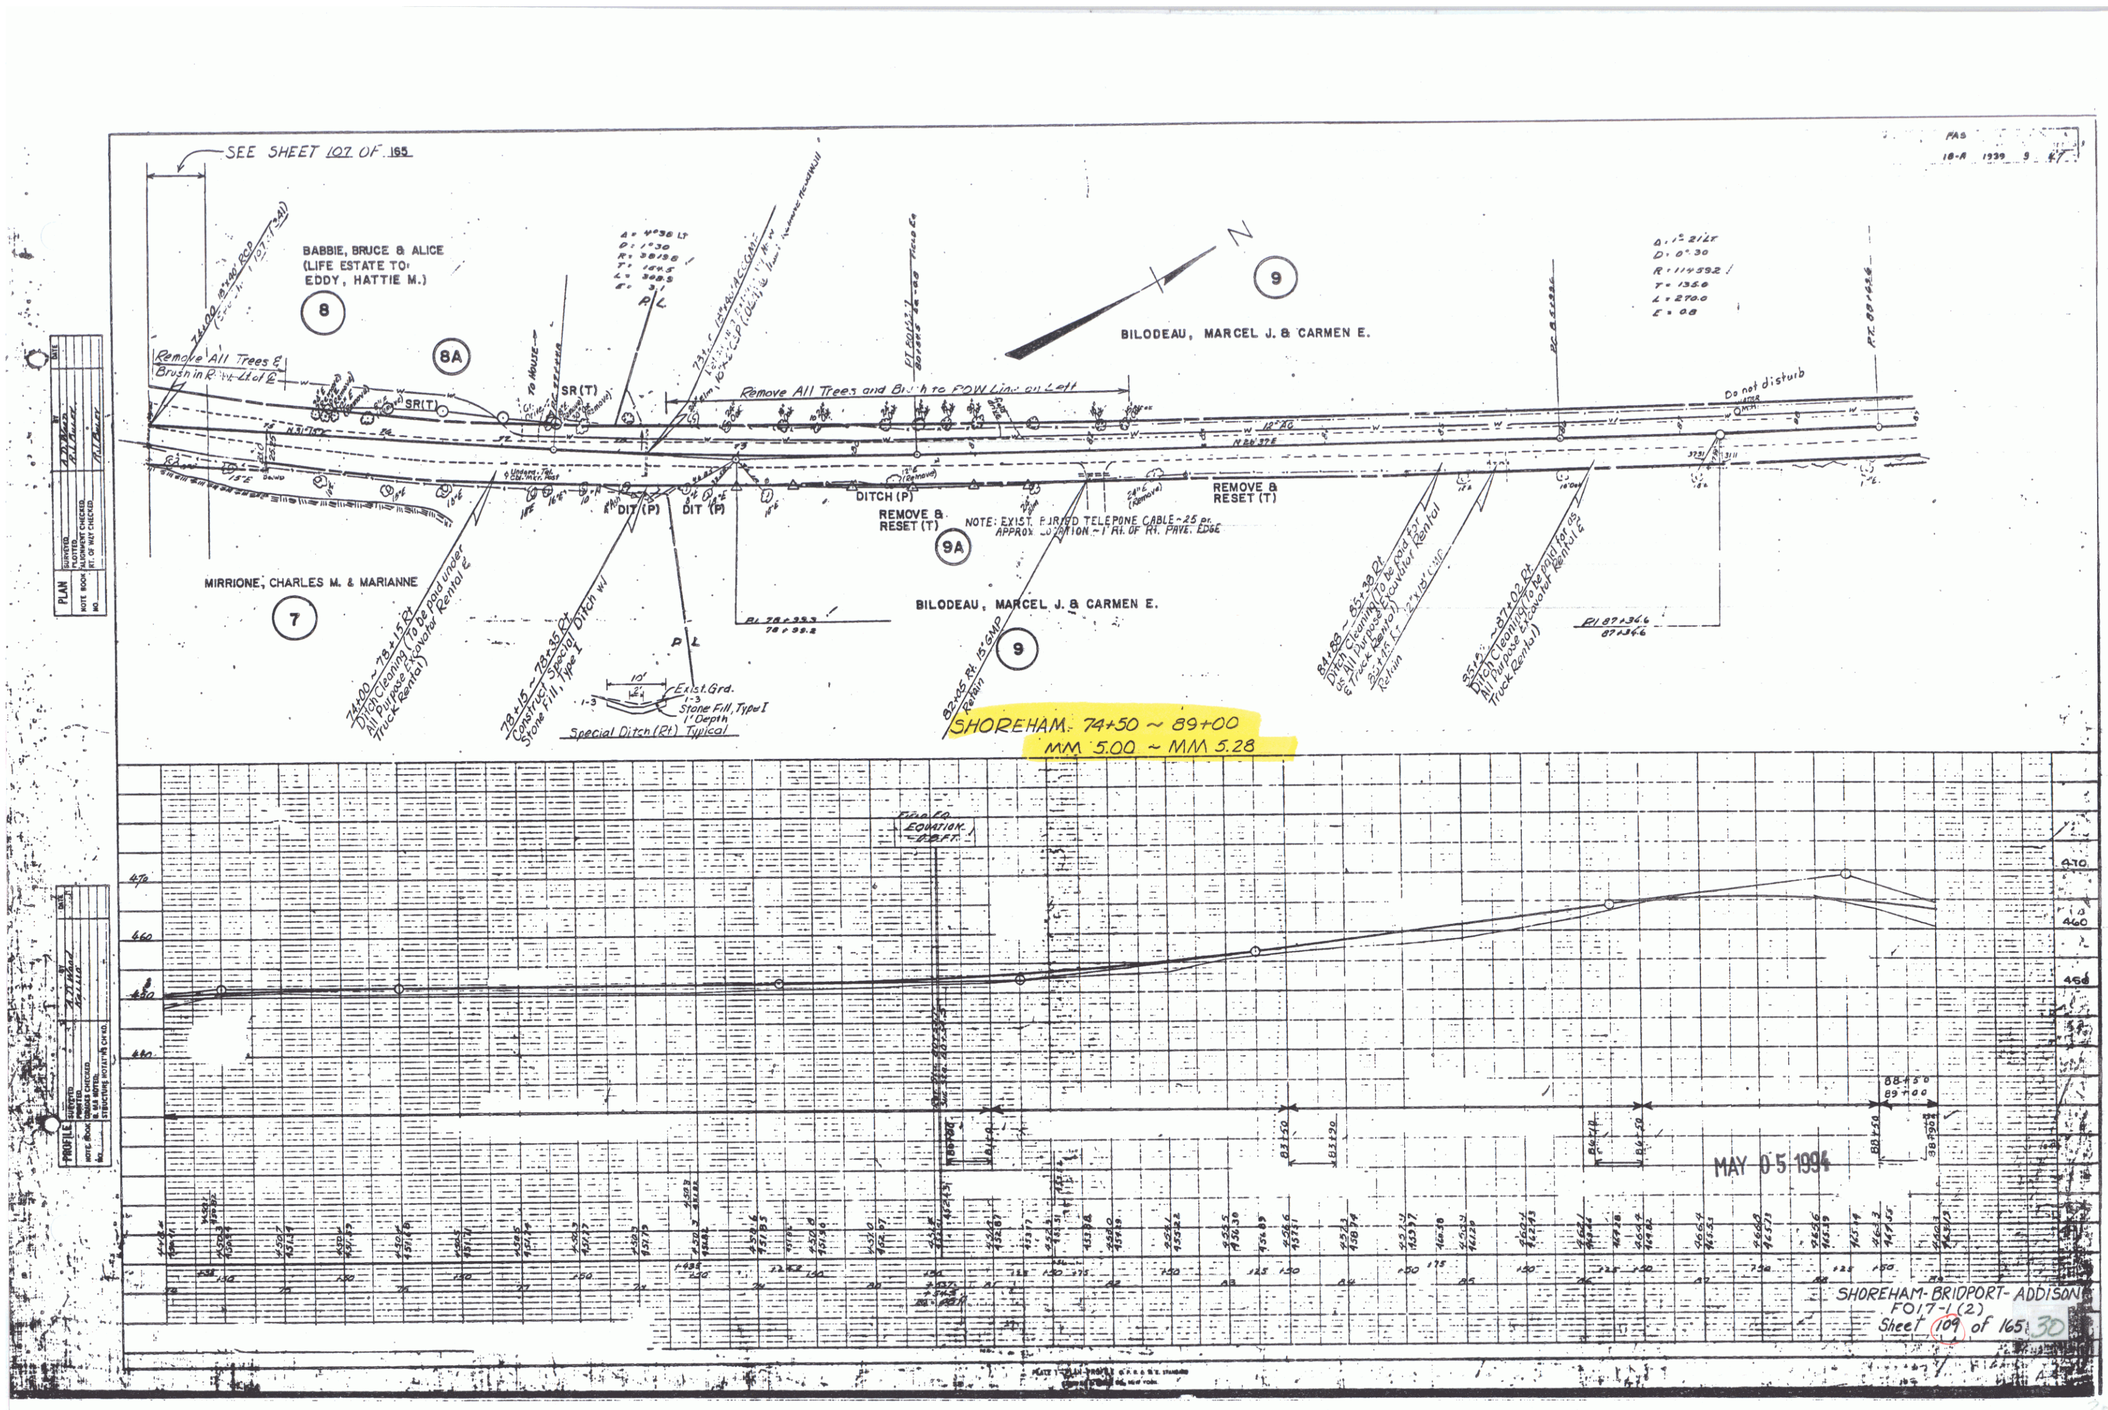
SEE SHEET 107 OF 165
BABBIE, BRUCE & ALICE
(LIFE ESTATE TO
EDDY, HATTIE M.)
8
8A
Remove All Trees & Brush in R. to Left of ℄
SR(T)
Remove All Trees and Brush to ROW Line on Left
BILODEAU, MARCEL J. & CARMEN E.
9
Do not disturb
DITCH (P)
REMOVE & RESET (T)
9A
NOTE: EXIST. BURIED TELEPONE CABLE ~25 pr.
APPROX. LOCATION ~1' Rt. OF Rt. PAVE. EDGE
MIRRIONE, CHARLES M. & MARIANNE
7
74+00 ~ 78+15 Rt.
Ditch Cleaning (To be paid under All Purpose Excavator Rental & Truck Rental)
78+15 ~ 78+35 Rt.
Construct Special Ditch w/ Stone Fill, Type I
Special Ditch (Rt) Typical
Exist. Grd.
Stone Fill, Type I
1' Depth
82+05 ~ 84+50 Rt. 15" CMP
Remove
84+53 ~ 85+38 Rt.
Ditch Cleaning (To be paid for by All Purpose Excavator Rental & Truck Rental)
85+38 ~ 87+02 Rt.
Ditch Cleaning (To be paid for by All Purpose Excavator Rental & Truck Rental)
SHOREHAM: 74+50 ~ 89+00
MM 5.00 ~ MM 5.28
PLAN
PROFILE
MAY 05 1994
SHOREHAM-BRIDPORT-ADDISON
F017-1(2)
Sheet 109 of 165
30