F.A.S.
18-80(1940) a. 67

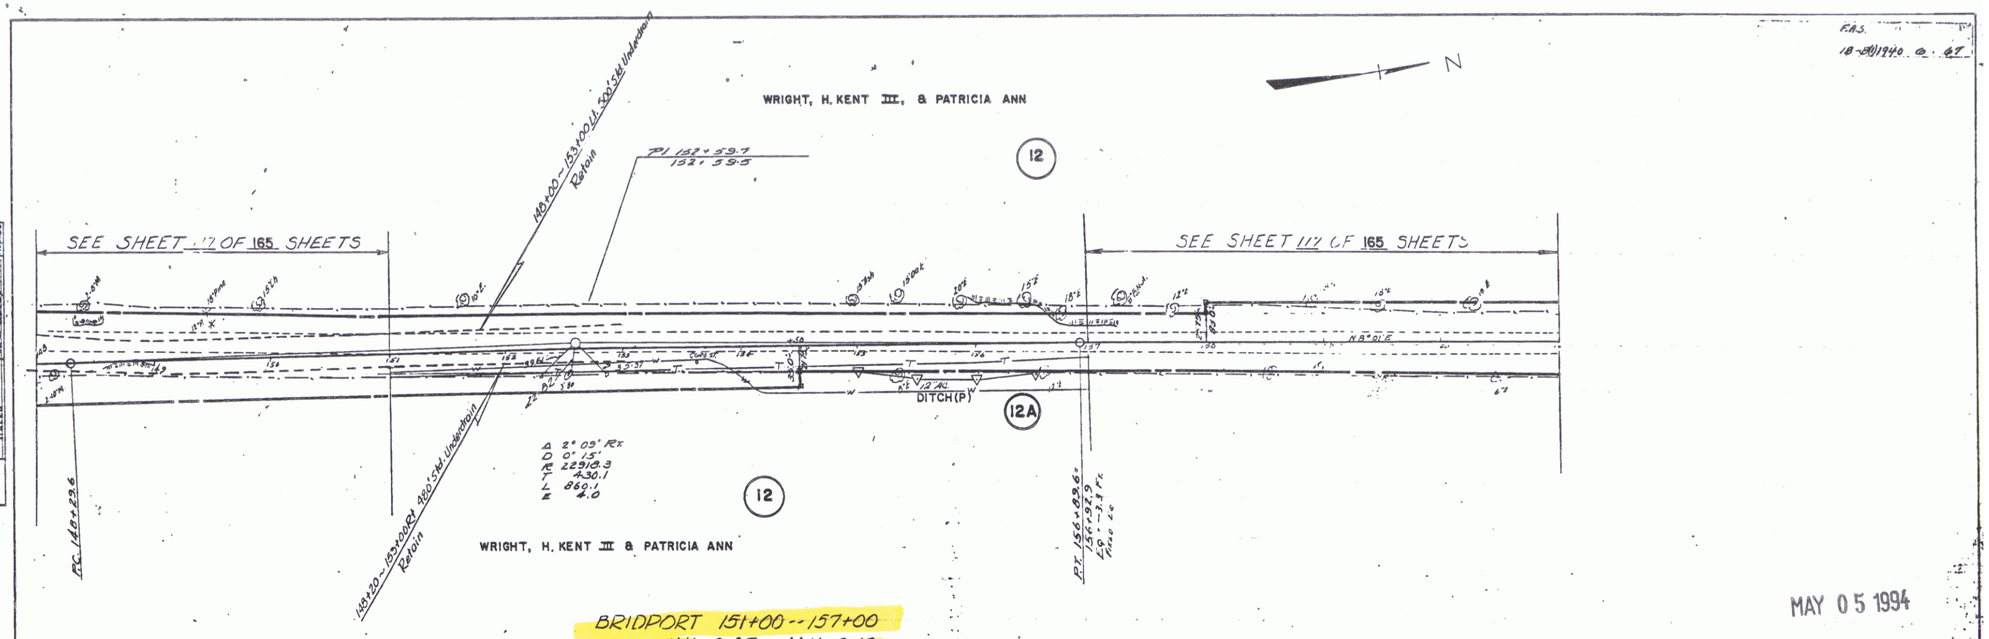


MAY 05 1994

BRIDPORT 151+00--157+00
MM 0.07 ~ MM 0.18

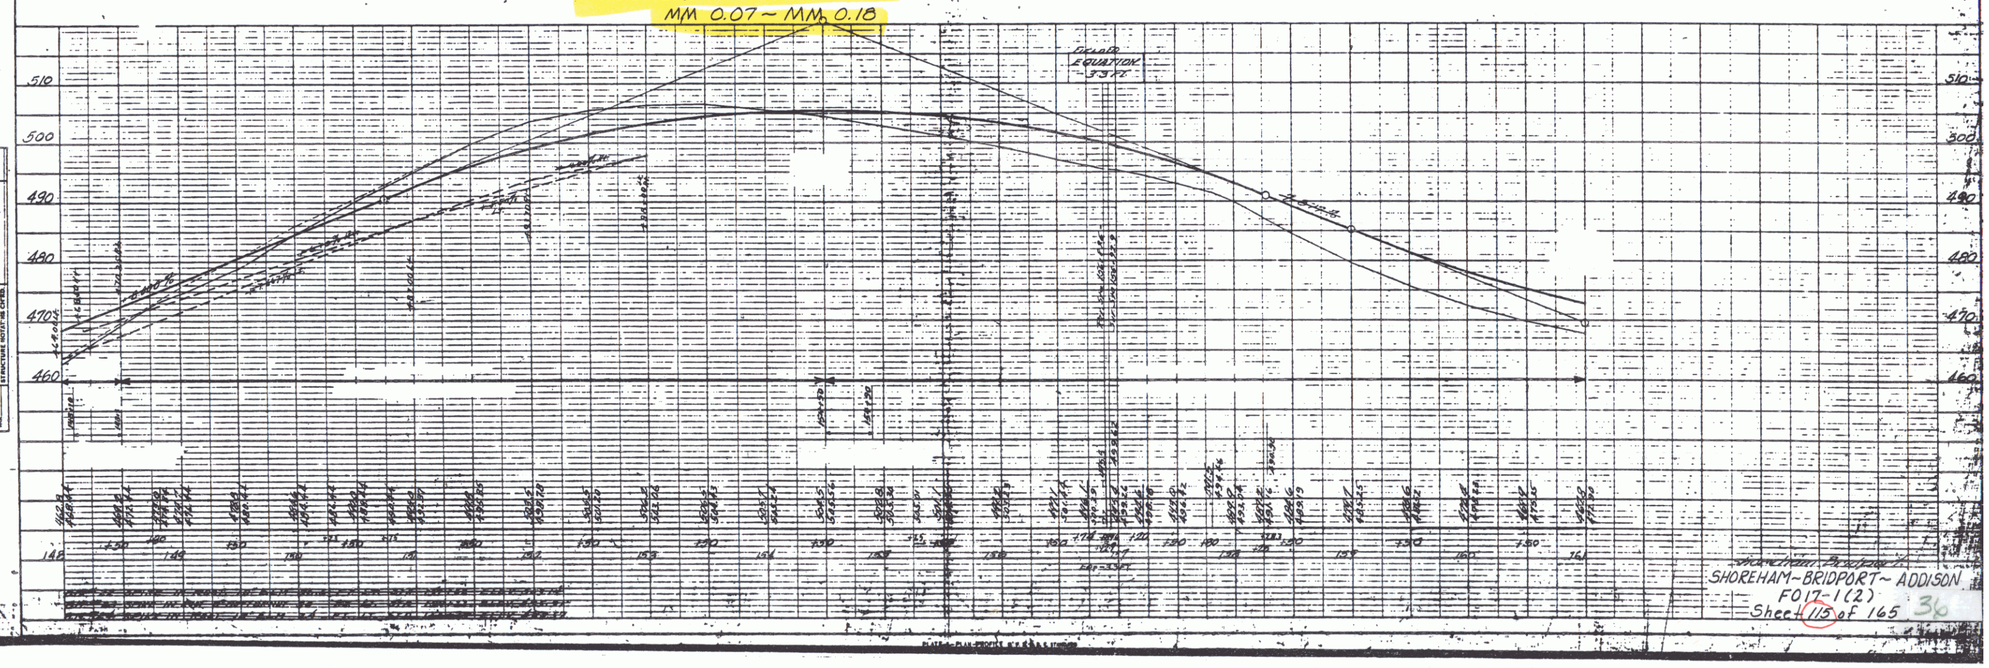


SHOREHAM-BRIDPORT~ ADDISON
F017-1(2)
Sheet 115 of 165