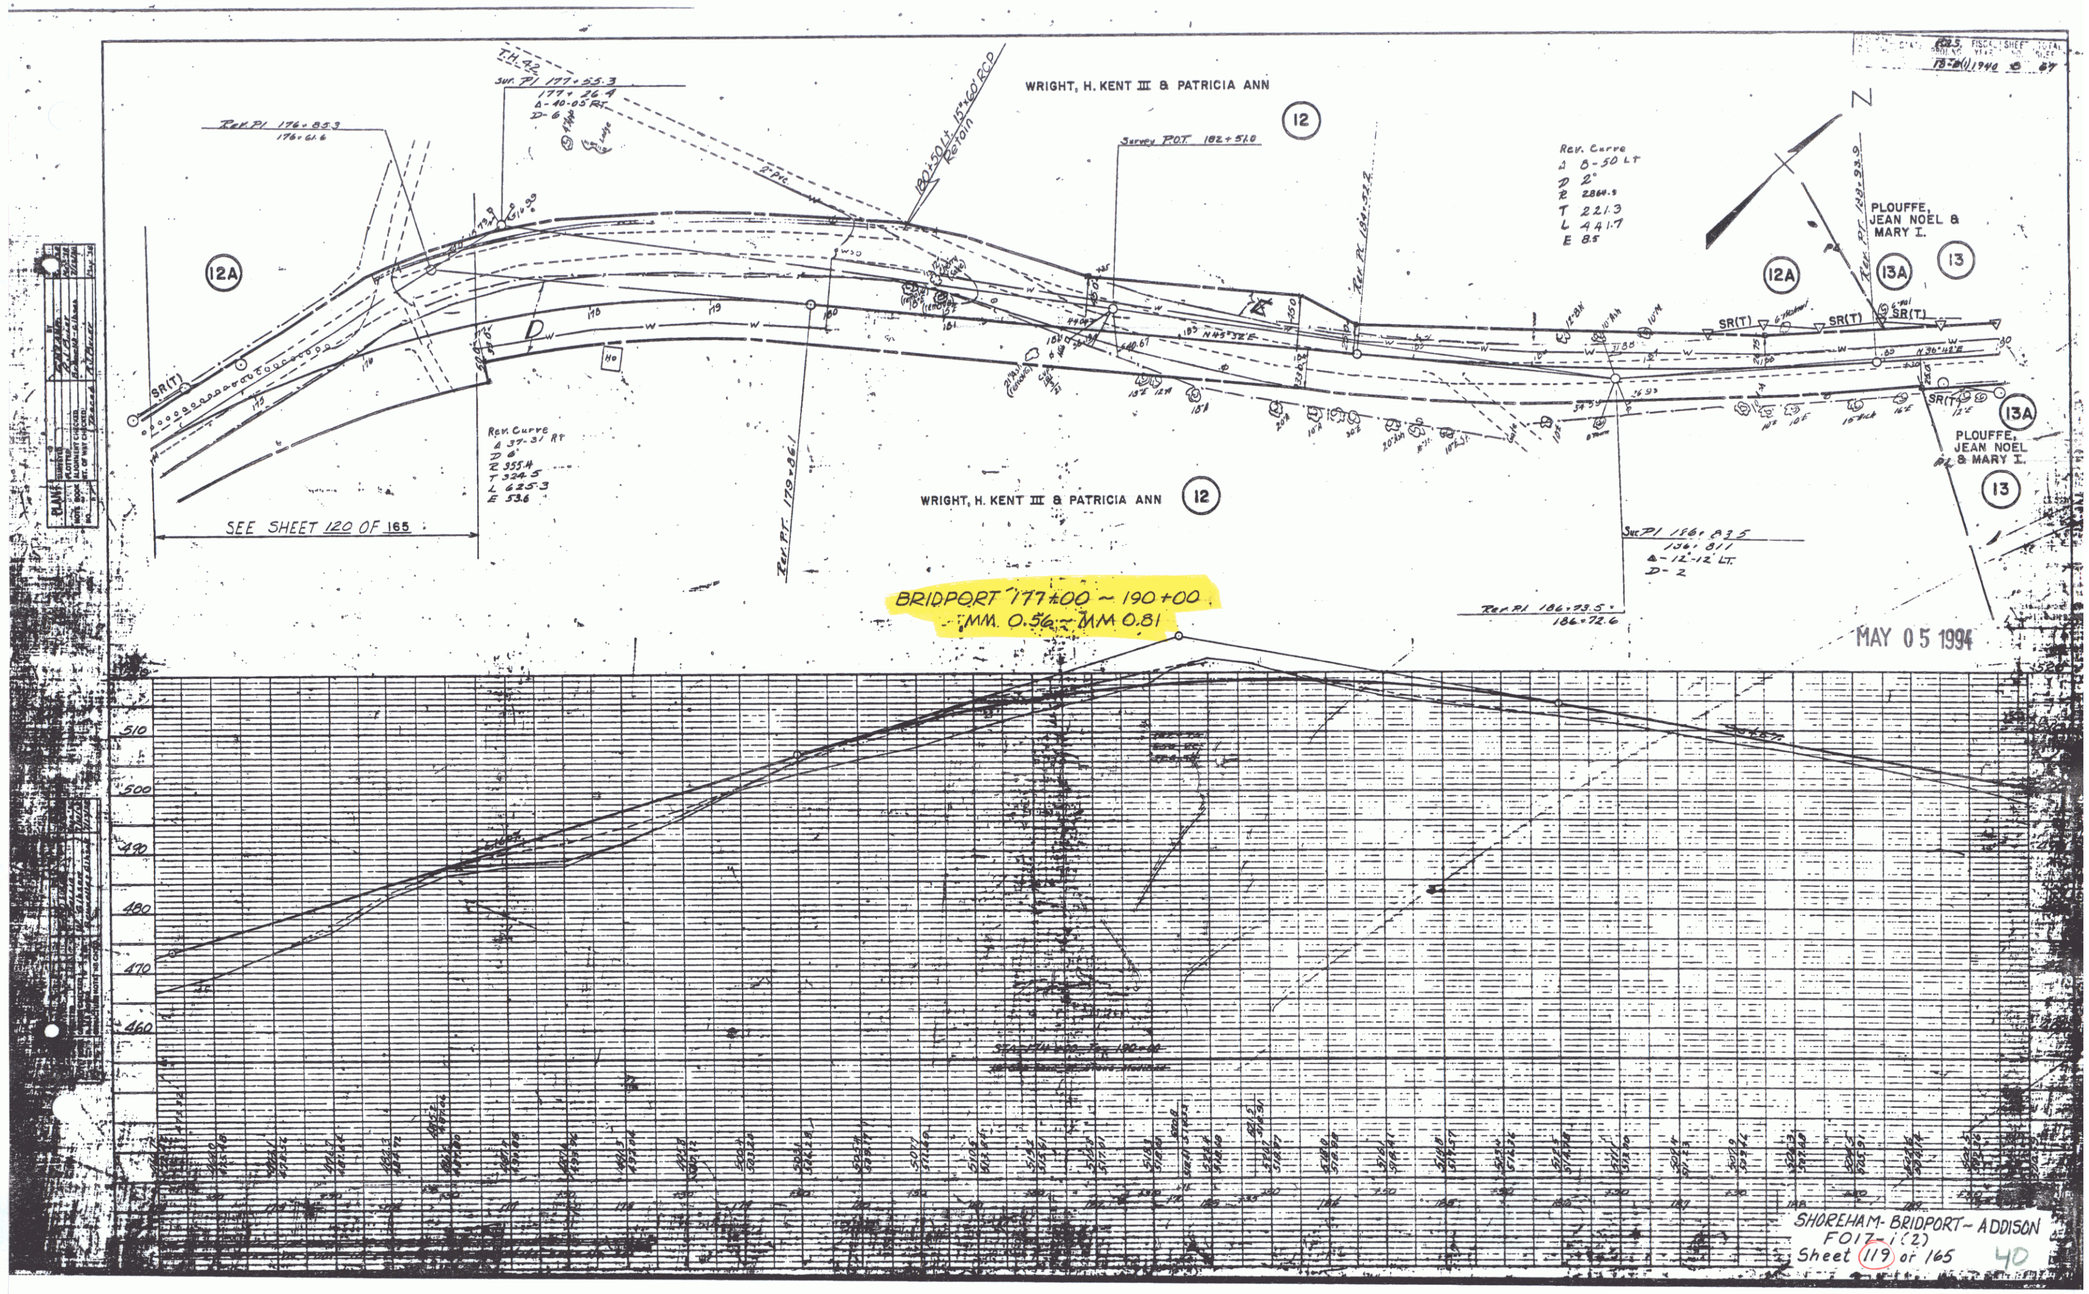
WRIGHT, H. KENT III & PATRICIA ANN
12
12A
PLOUFFE, JEAN NOEL & MARY I.
13
13A
SR(T)
SEE SHEET 120 OF 165
BRIDPORT 177+00 ~ 190+00
MM. 0.56 ~ MM 0.81
MAY 05 1994
SHOREHAM-BRIDPORT-ADDISON
F017-1(2)
Sheet 119 of 165
40