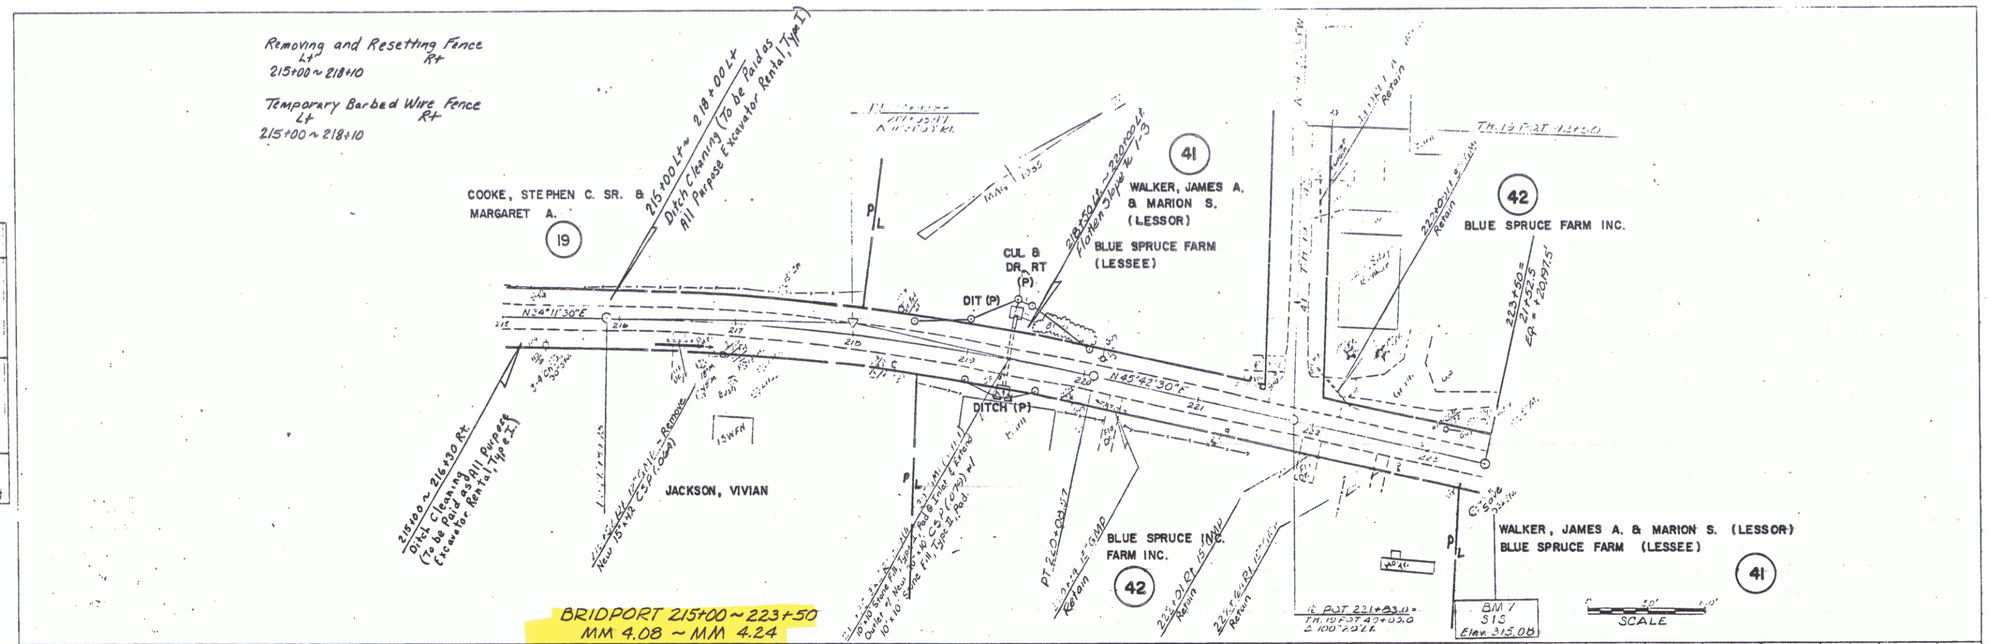

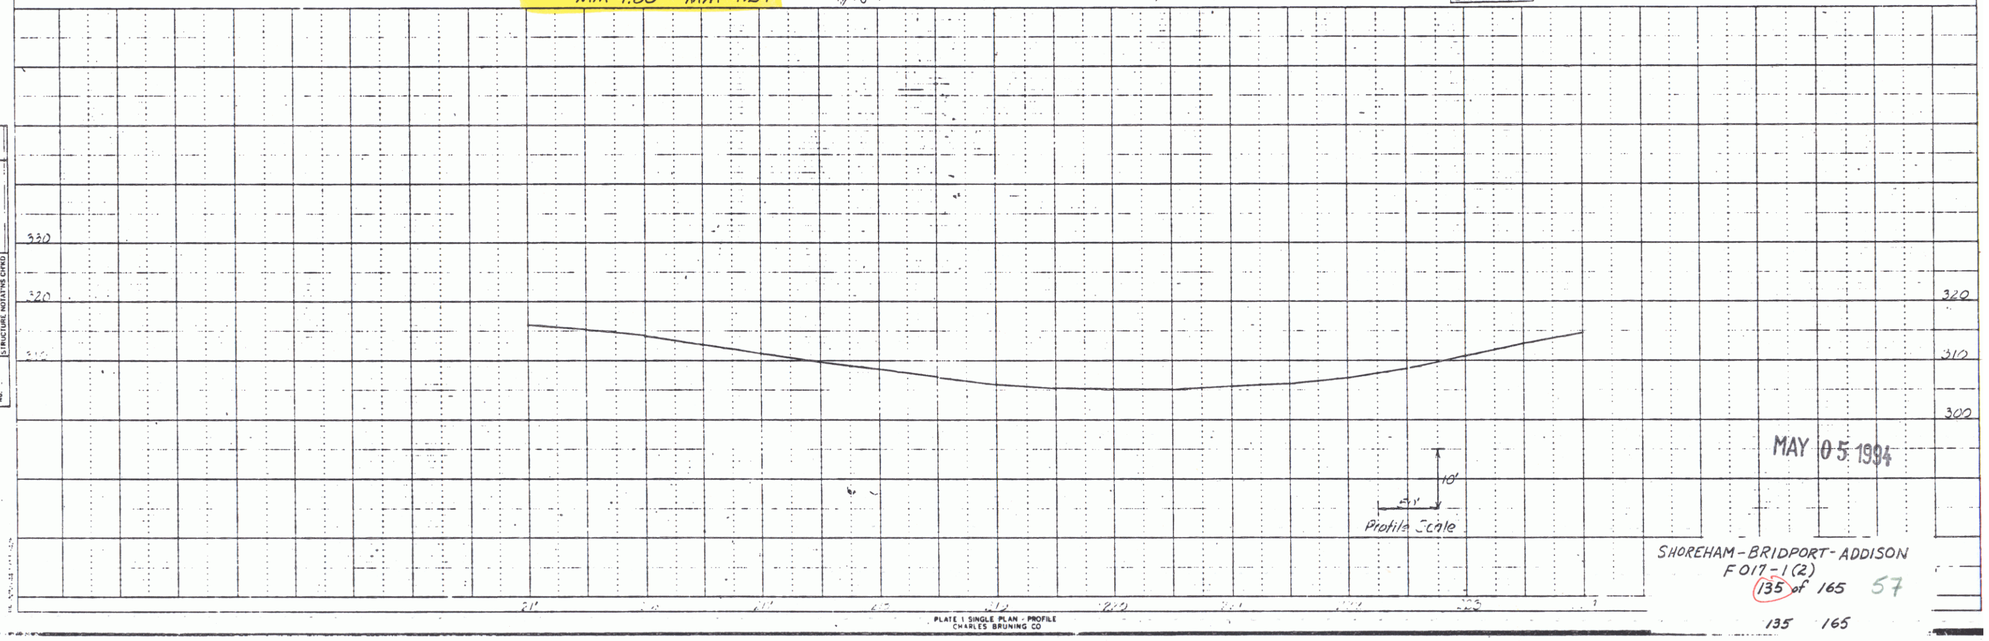

MAY 05 1994

SHOREHAM-BRIDPORT-ADDISON
F017-1(2)
135 of 165 57

135 165

PLATE 1 SINGLE PLAN - PROFILE
CHARLES BRUNING CO.