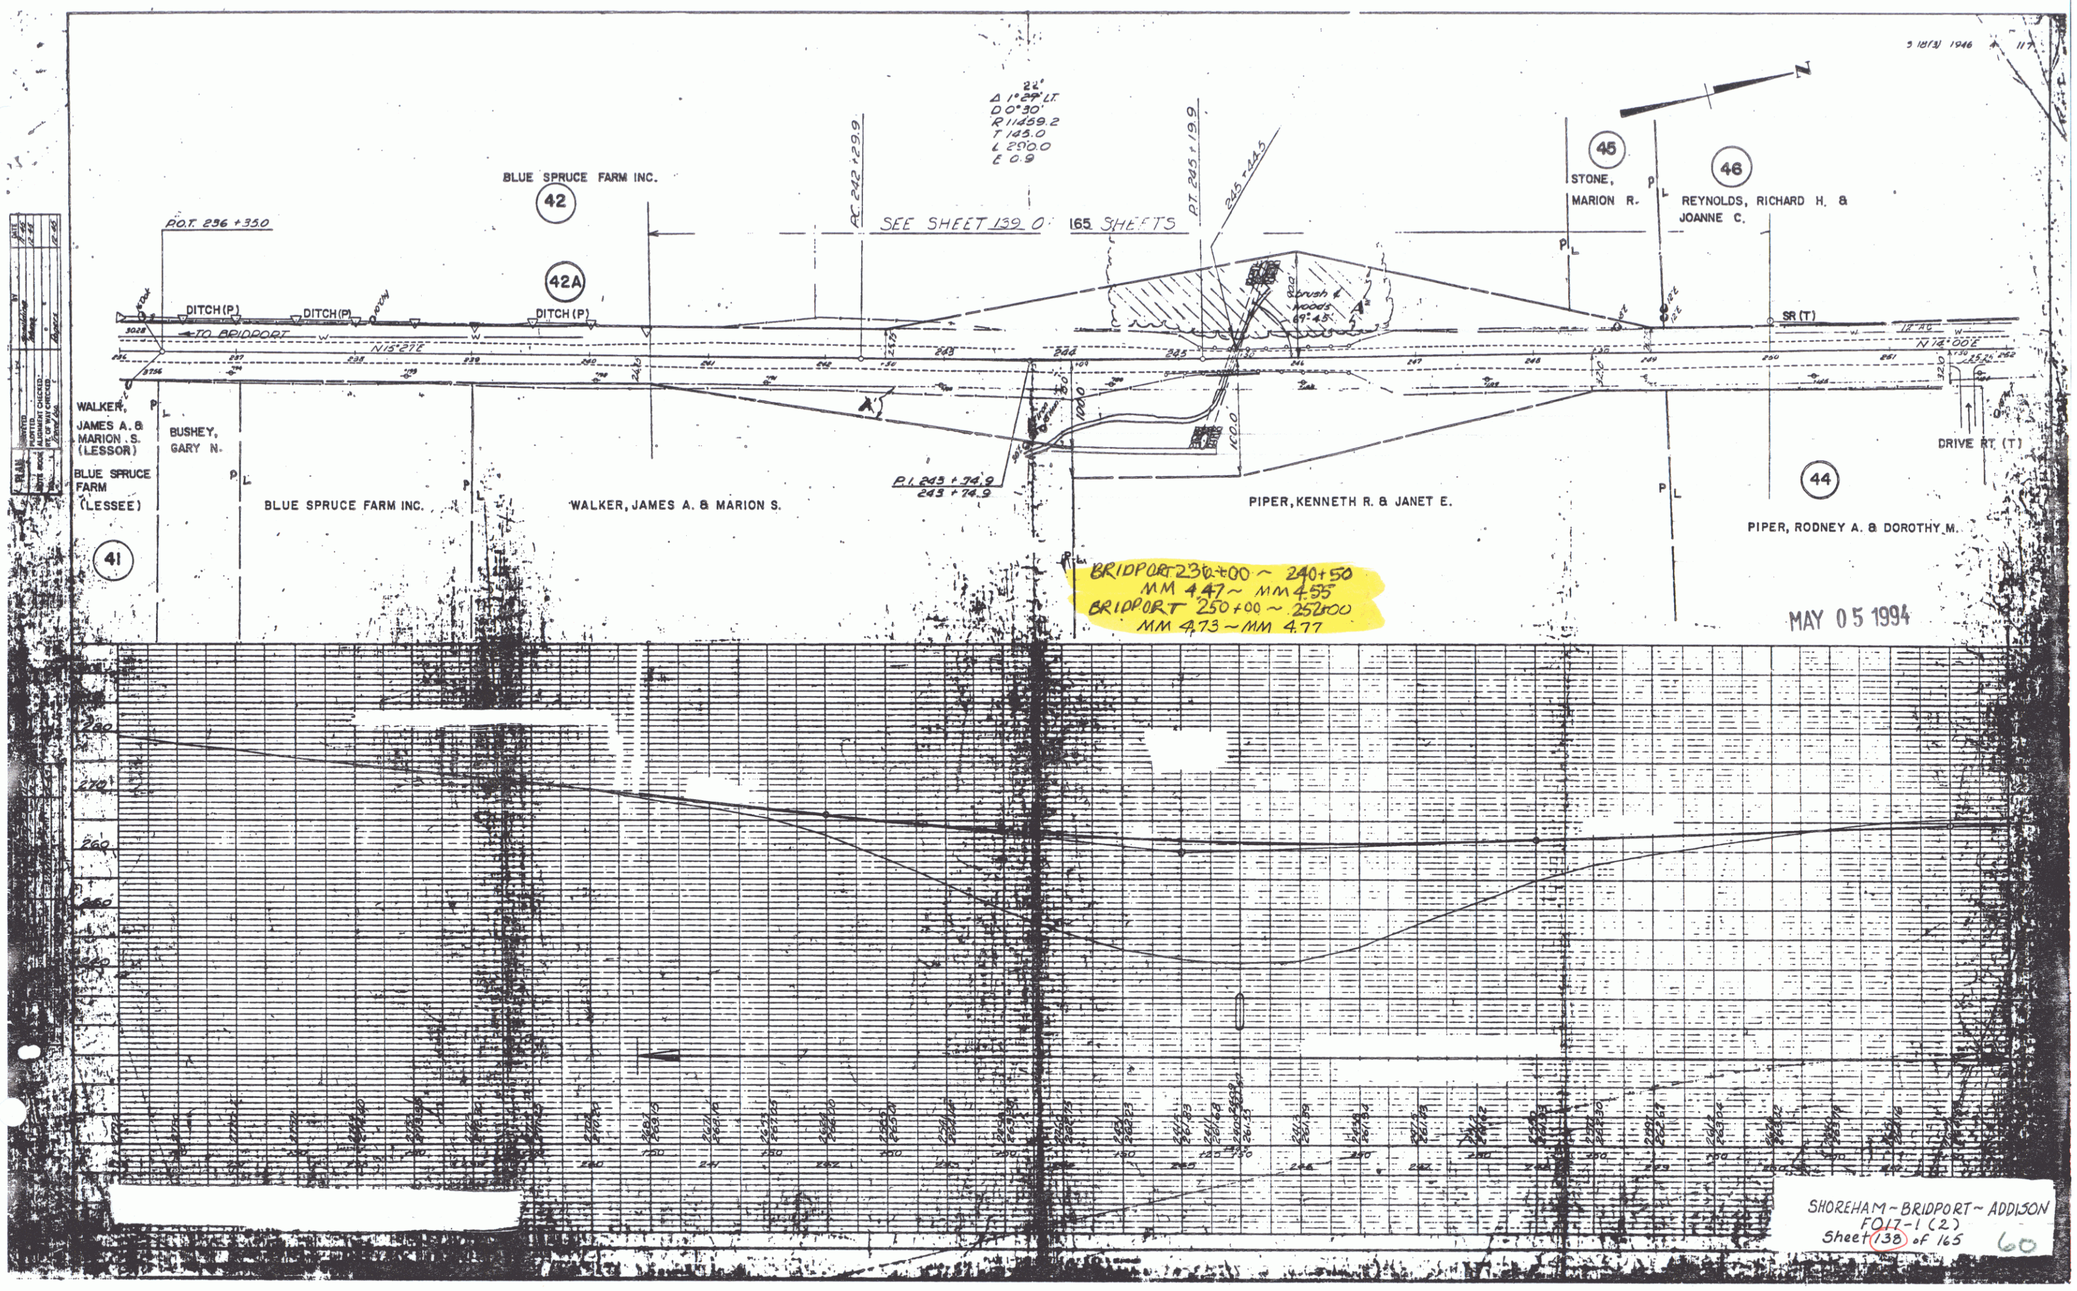
BLUE SPRUCE FARM INC.
42
42A
P.O.T. 236 + 35.0
DITCH (P)
DITCH (P)
DITCH (P)
TO BRIDPORT
N15°27'E
PC 242 + 29.9
Δ 1°29' LT.
D 0°30'
R 11459.2
T 145.0
L 290.0
E 0.9
SEE SHEET 139 OF 165 SHEETS
PT 245 + 19.9
245 + 44.5
45
STONE, MARION R.
46
REYNOLDS, RICHARD H. & JOANNE C.
N
SR (T)
N 14°00'E
DRIVE PT. (T)
WALKER, JAMES A. & MARION S. (LESSOR)
BLUE SPRUCE FARM (LESSEE)
BUSHEY, GARY N.
41
BLUE SPRUCE FARM INC.
WALKER, JAMES A. & MARION S.
P.I. 245 + 74.9
245 + 74.9
PIPER, KENNETH R. & JANET E.
44
PIPER, RODNEY A. & DOROTHY M.
BRIDPORT 230+00 ~ 240+50
MM 4.47 ~ MM 4.55
BRIDPORT 250+00 ~ 252+00
MM 4.73 ~ MM 4.77
MAY 05 1994
SHOREHAM ~ BRIDPORT ~ ADDISON
FO17-1 (2)
Sheet 138 of 165
60