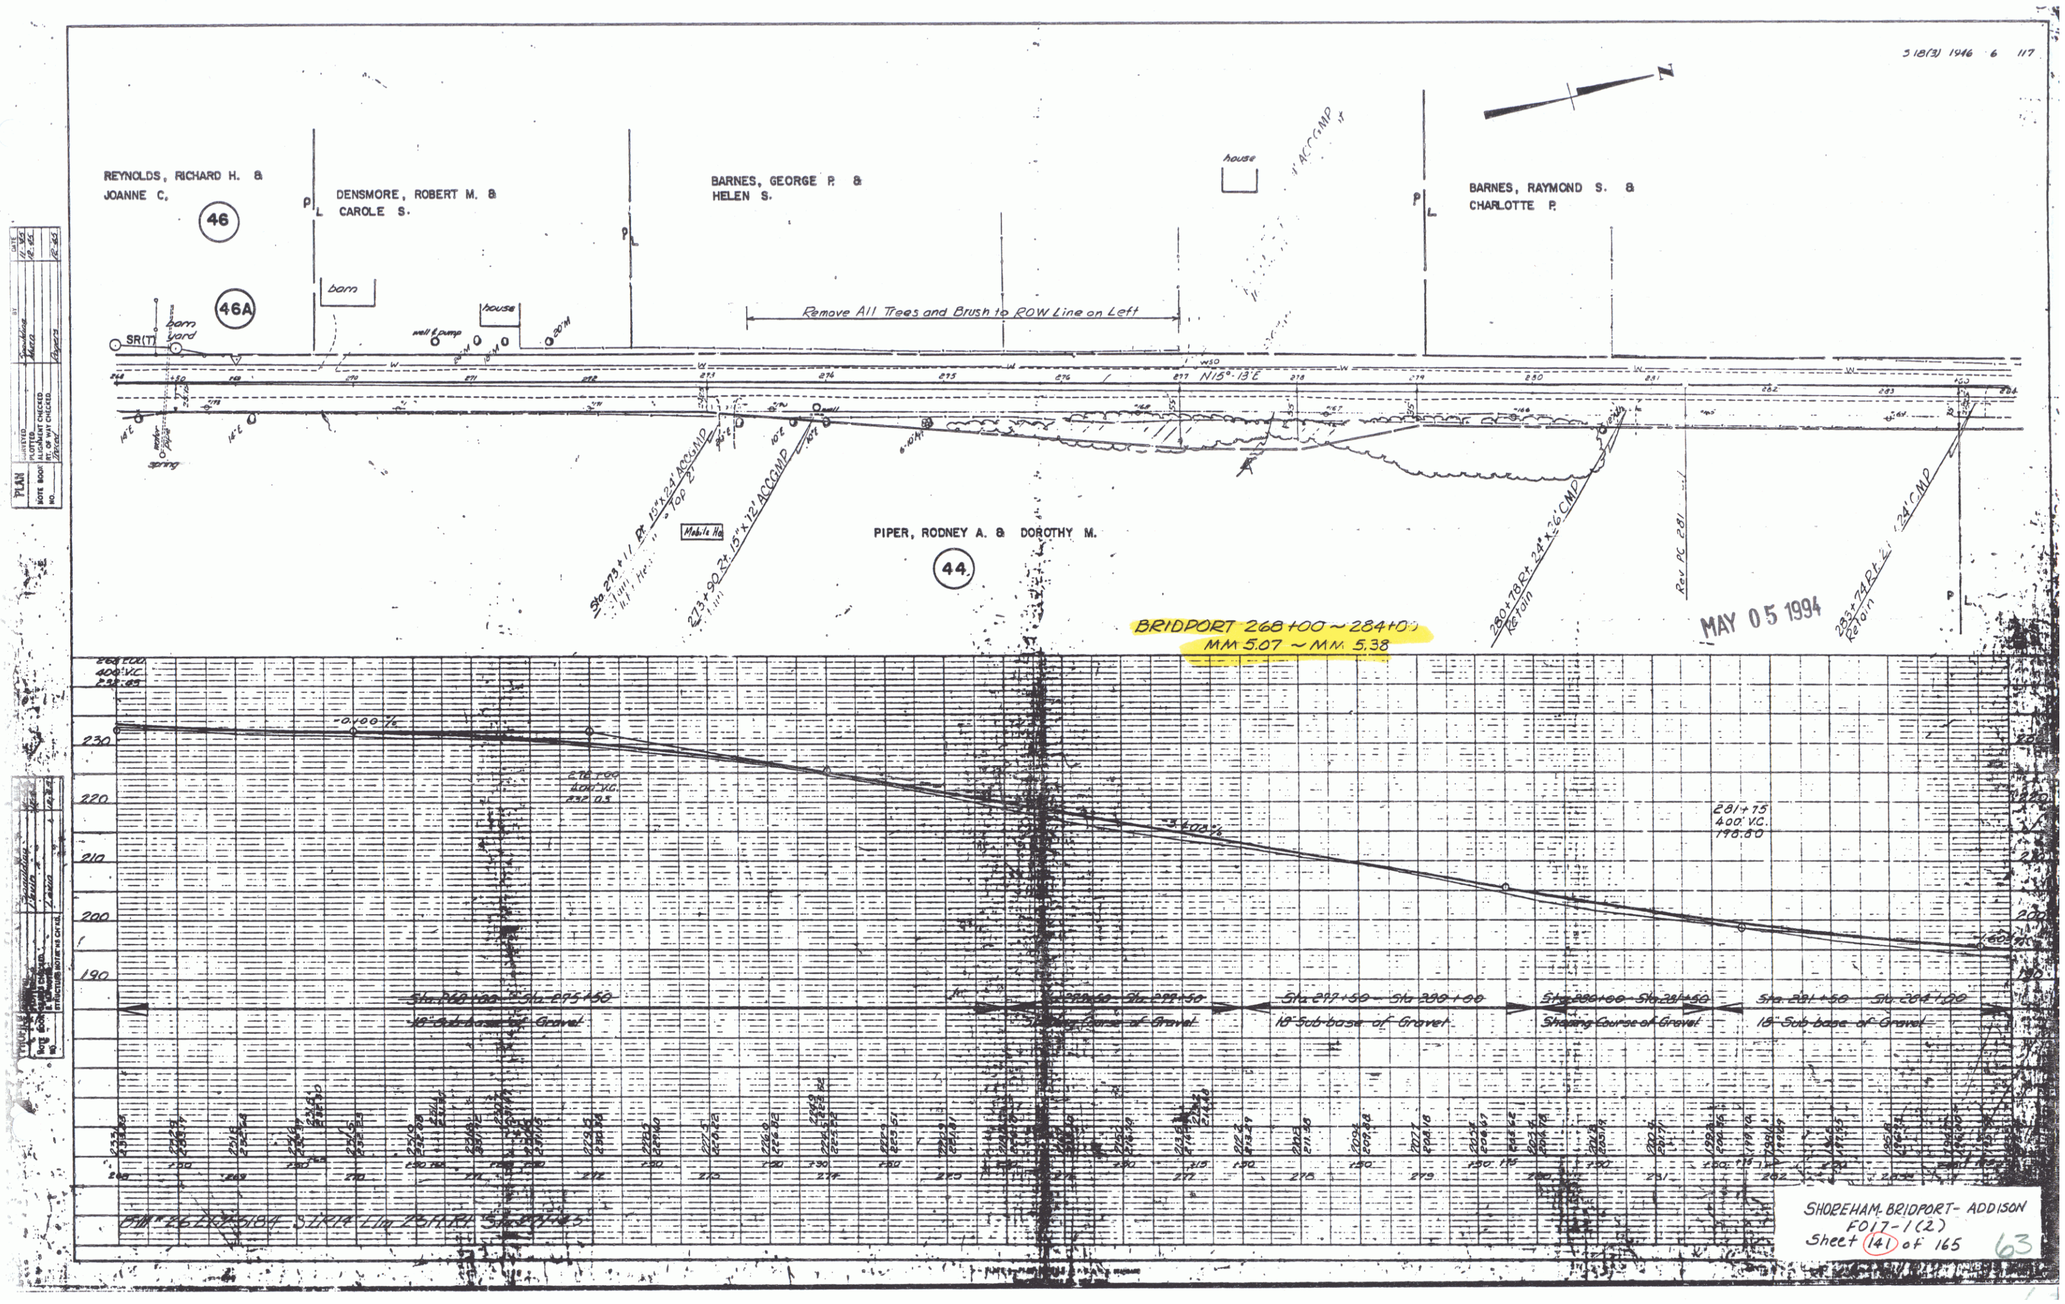
3 18(3) 1946 6 117
REYNOLDS, RICHARD H. & JOANNE C.
46
46A
DENSMORE, ROBERT M. & CAROLE S.
barn
house
well & pump
barn yard
SR(T)
BARNES, GEORGE P. & HELEN S.
house
BARNES, RAYMOND S. & CHARLOTTE P.
Remove All Trees and Brush to ROW Line on Left
N15°-13'E
PIPER, RODNEY A. & DOROTHY M.
44
Sta 273+11 Rt 15"x24' ACCMP
273+90 Rt 15"x12' ACCCMP
280+78 Rt 24"x36' CMP
Rev PC 281
233+74 Rt 24" CMP
BRIDPORT 268+00 ~ 284+00
MM 5.07 ~ MM 5.38
MAY 05 1994
-0.00%
+3.00%
281+75
400' VC.
196.80
Sta. 268+00 to Sta. 275+50
18" Sub-base of Gravel
Sta. 277+50 to Sta. 280+50
Sta. 280+00 to Sta. 281+50
Sta. 281+50 to Sta. 284+00
18" Sub-base of Gravel
Shoring Course of Gravel
18" Sub-base of Gravel
SHOREHAM-BRIDPORT-ADDISON
F017-1(2)
Sheet 141 of 165
63