STEEL BEAM GUARD RAIL

LT. 344+14 ~ 347+14

RT. 343+14 ~ 346+14

BREAKAWAY CABLE TERMINAL

LT. 343+89 ~ 344+14, 347+14 ~ 347+39

RT. 342+89 ~ 343+14, 346+14 ~ 346+39

REMOVAL AND DISPOSAL OF GUARD RAIL

LT. 343+51 ~ 348+21

RT. 343+23 ~ 347+91

CLEARING & GRUBBING

Lt. Rt. 343+28 ~ 347+00 (to const. Limits)

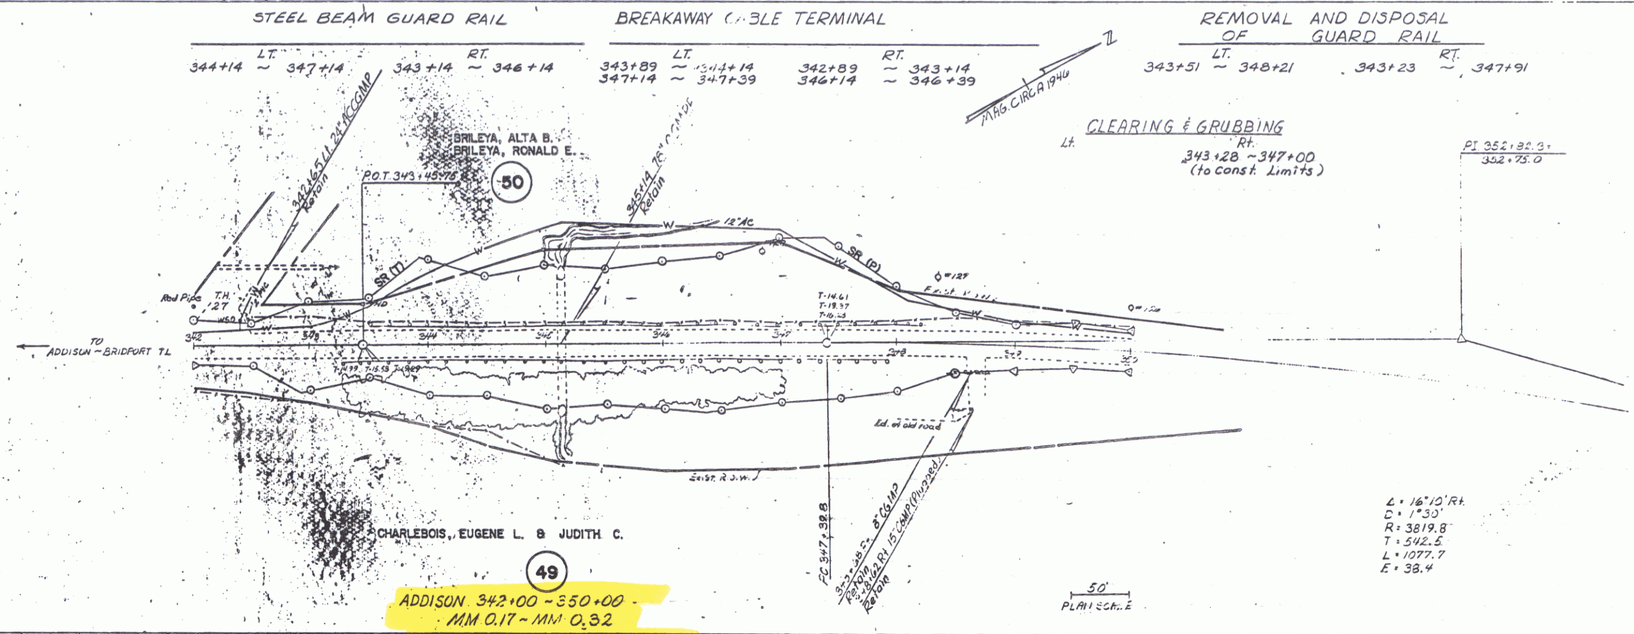

ADDISON 342+00 ~ 350+00
MM 0.17 ~ MM 0.32

MAY 05 1994

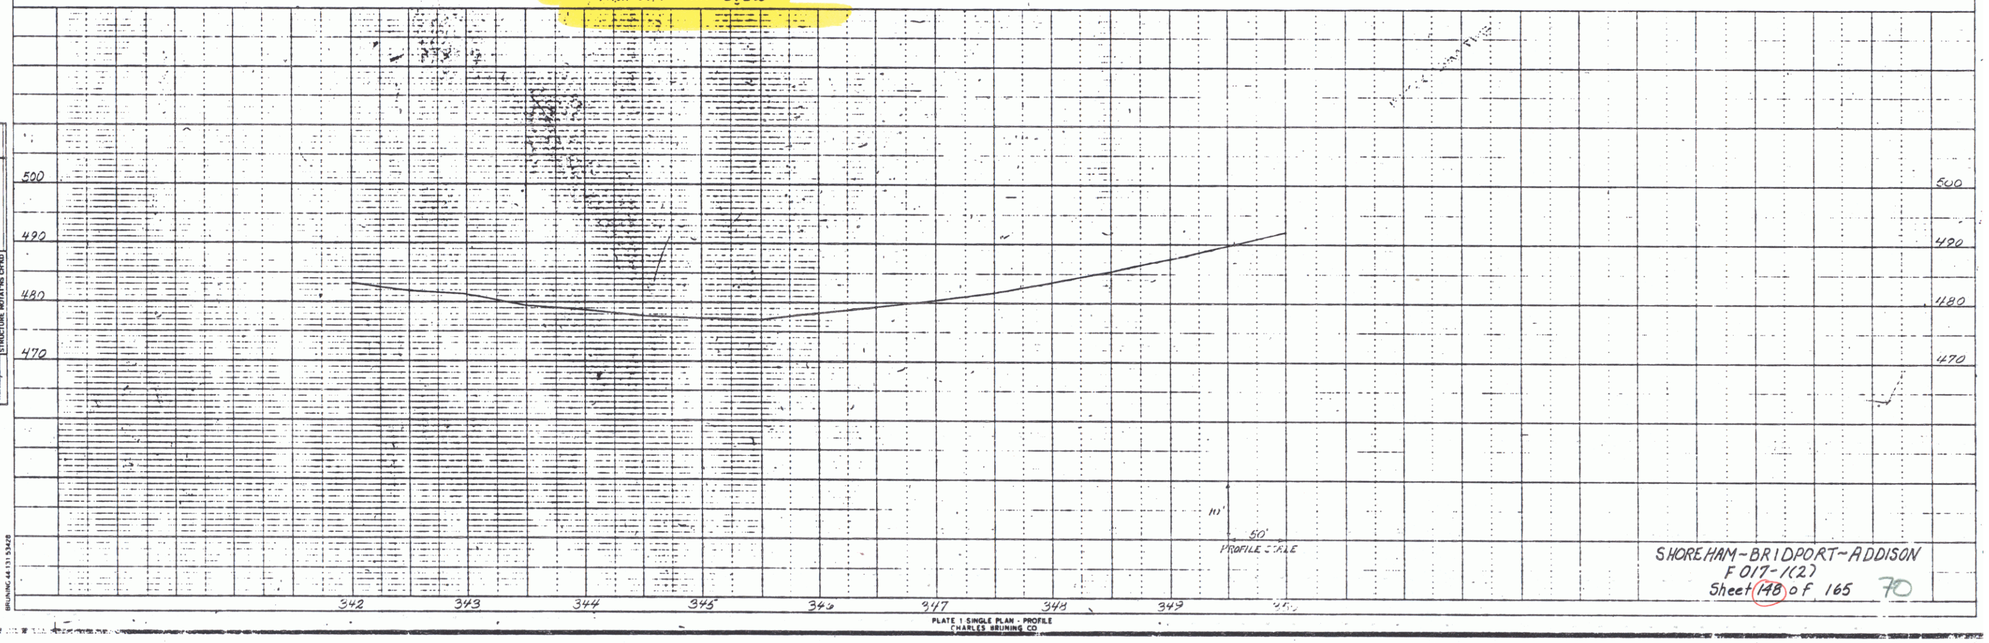

SHOREHAM-BRIDPORT-ADDISON
F 017-1(2)
Sheet 14B of F. 165 70

PLAN
SURVEYED
PLOTTED
NOTES CHECKED
ALIGNMENT CHECKED
PLOT MAP CHECKED
NOTE BOOK NO. 4
BY
DATE 2-24-94

PROFILE
SURVEYED
PLOTTED
GRADES CHECKED
S.M. NOTES
ELEVATIONS MOTATYNG CHKD
NOTE BOOK NO. 4
BY
DATE 2-24-94

BRUNING 44 131 3 94 20

PLATE 1 SINGLE PLAN - PROFILE
CHARLES BRUNING CO.