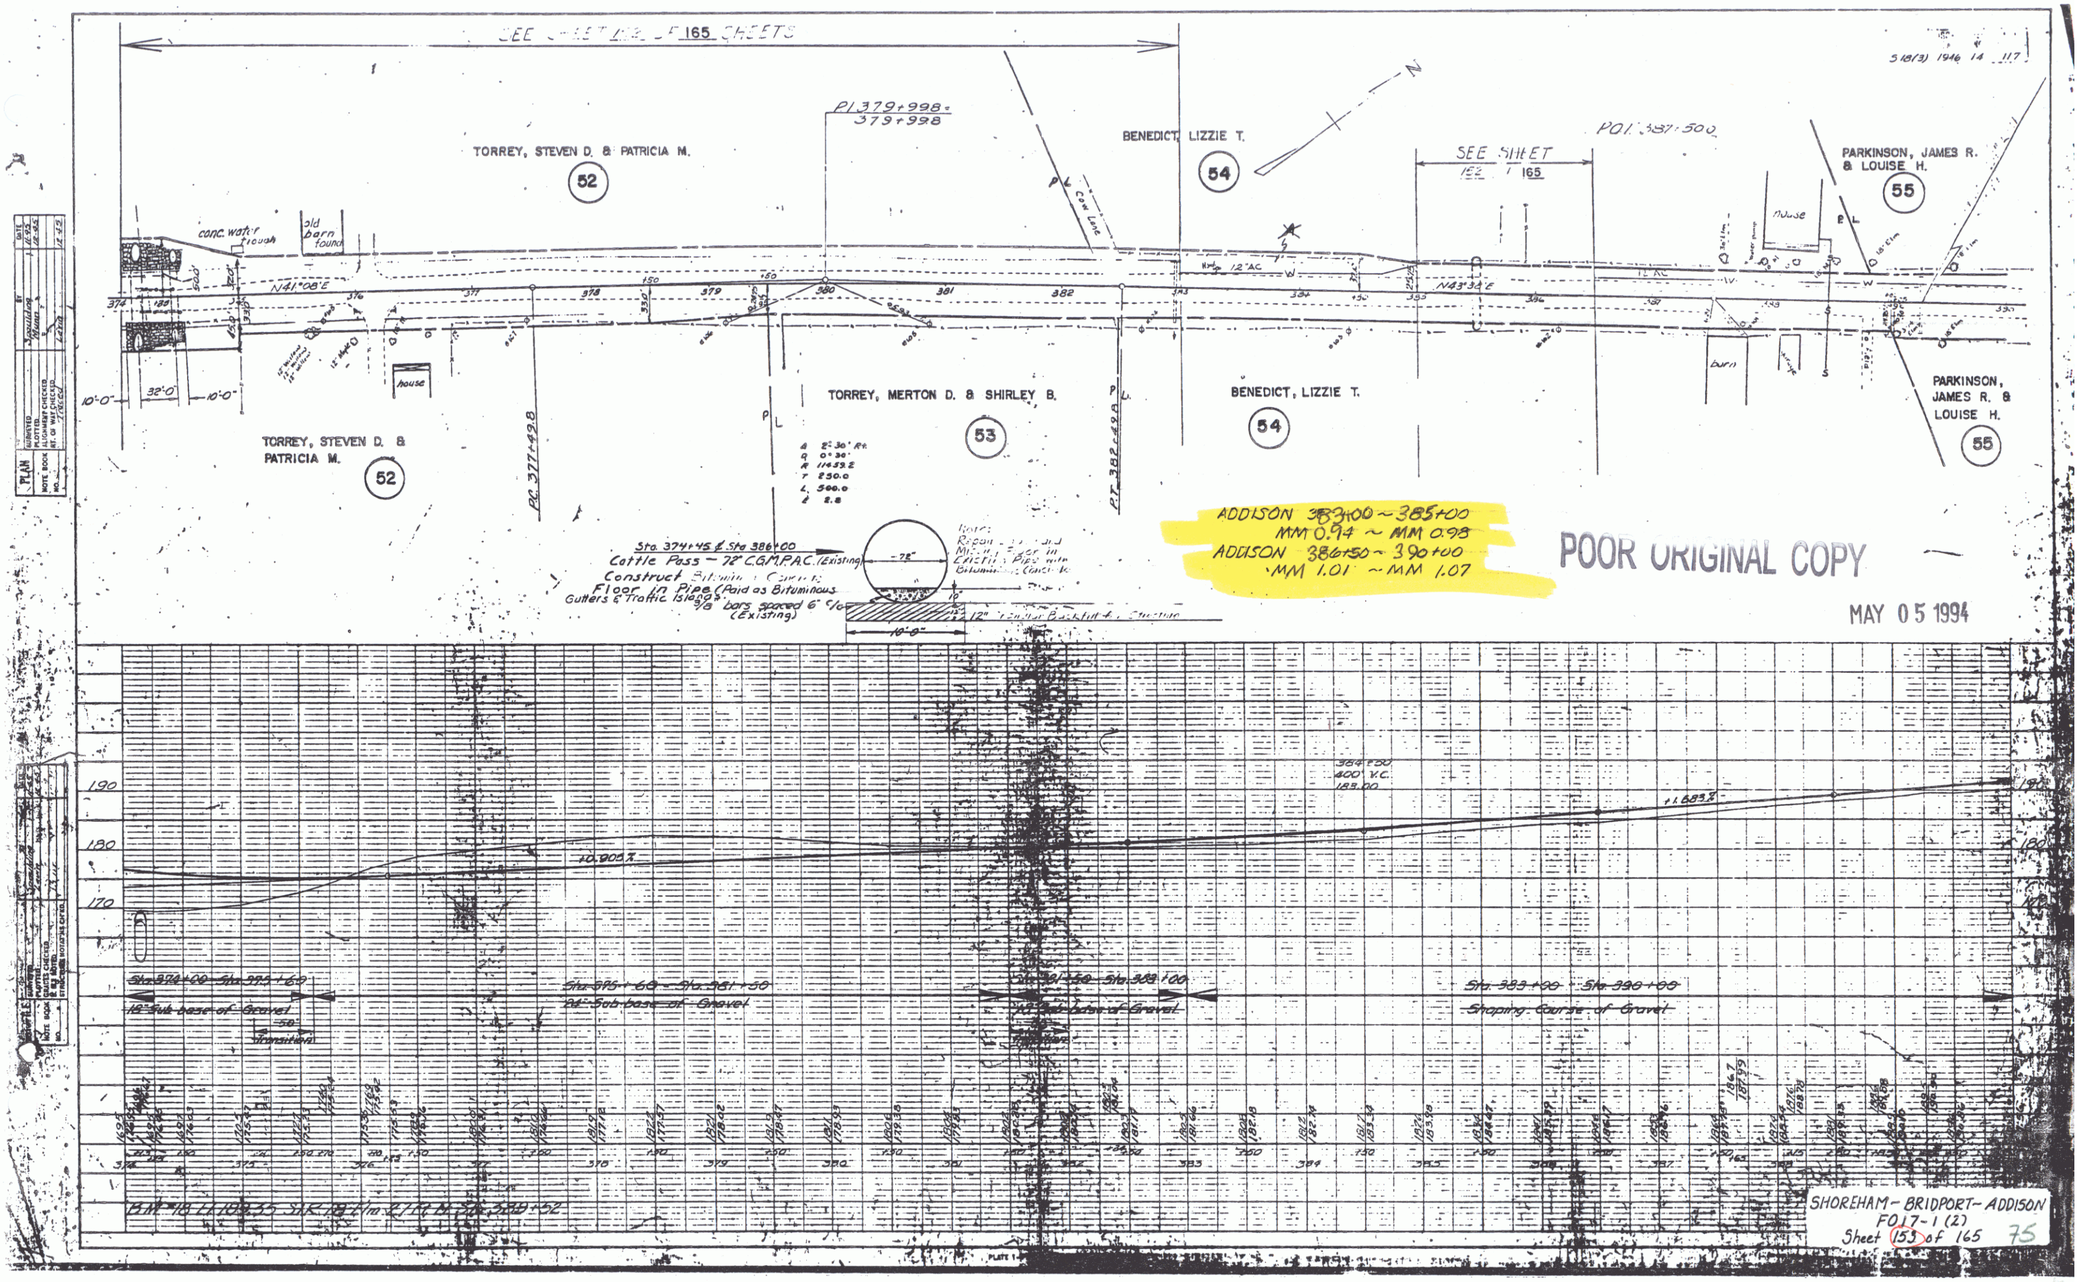
SEE SHEET 1 OF 165 SHEETS
TORREY, STEVEN D. & PATRICIA M.
52
PI 379+998 = 379+998
BENEDICT, LIZZIE T.
54
SEE SHEET 165
PI 387+500
PARKINSON, JAMES R. & LOUISE H.
55
conc. water trough
old barn found
house
N41°08'E
N43°34'E
TORREY, MERTON D. & SHIRLEY B.
53
PC 377+49.8
PT 382+49.8
Sta. 374+45 & Sta. 386+00
Cattle Pass - 72" C.G.M.P.A.C. (Existing)
Construct Bituminous Concrete Floor in Pipe (Paid as Bituminous Gutters & Traffic Islands)
3/8" bars spaced 6" c/c (Existing)
ADDISON 383+00 ~ 385+00
MM 0.94 ~ MM 0.98
ADDISON 386+50 ~ 390+00
MM 1.01 ~ MM 1.07
POOR ORIGINAL COPY
MAY 05 1994
barn
+10.905%
+1.685%
384+50
400' V.C.
185.00
Sta. 374+00 - Sta. 375+60
18" Sub base of Gravel
50' Transitional
Sta. 375+60 - Sta. 381+50
24" Sub base of Gravel
Sta. 381+50 - Sta. 383+00
18" Sub base of Gravel
Sta. 383+00 - Sta. 390+00
Shaping Course of Gravel
SHOREHAM - BRIDPORT - ADDISON
F017-1 (2)
Sheet 153 of 165
75