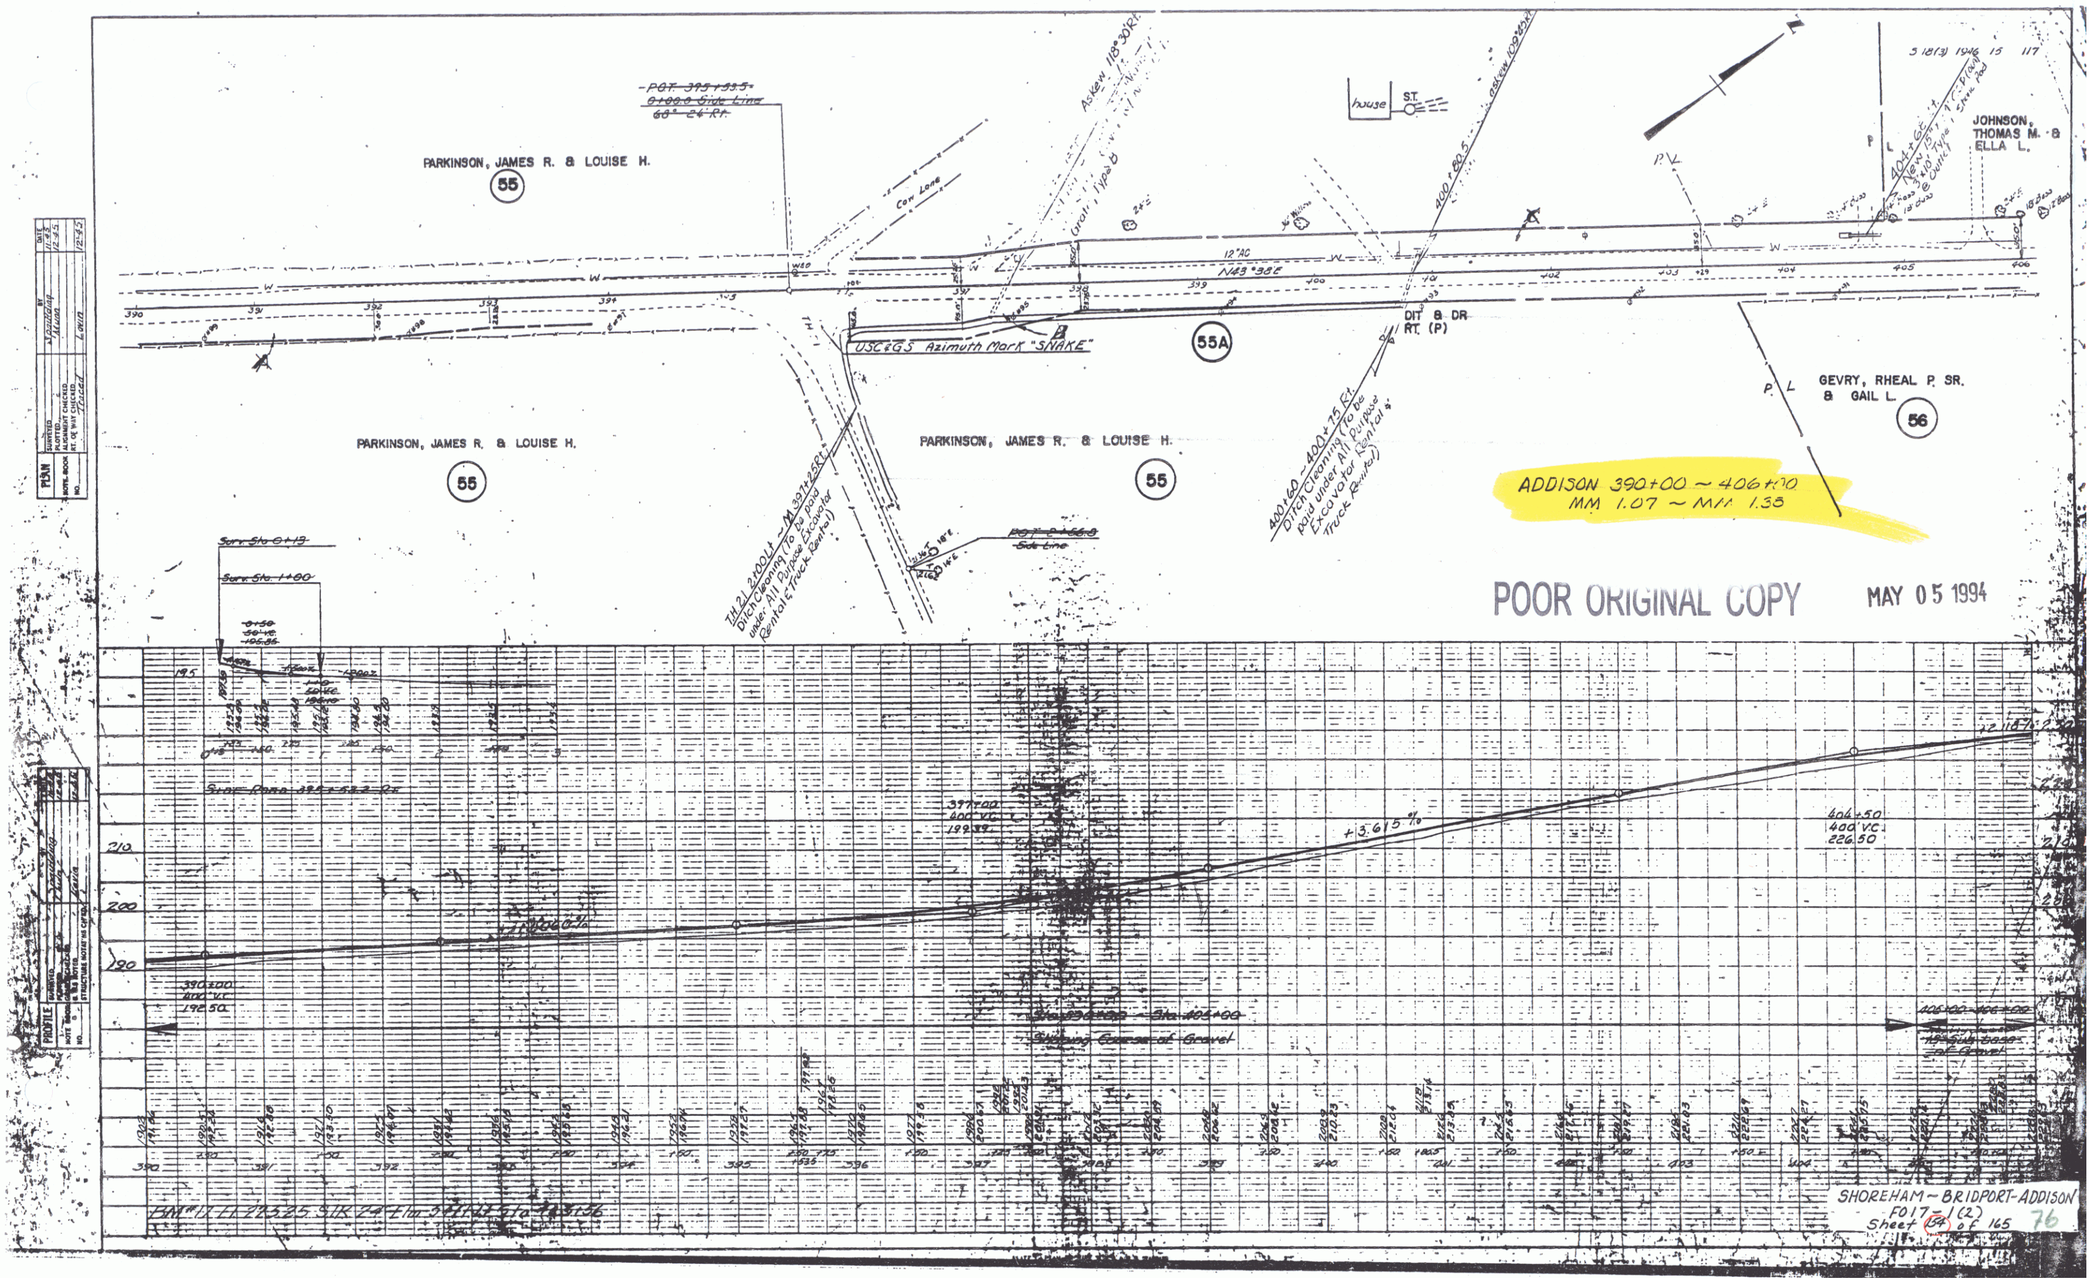
PARKINSON, JAMES R. & LOUISE H.
55
PARKINSON, JAMES R. & LOUISE H.
55
PARKINSON, JAMES R. & LOUISE H.
55
55A
USC&GS Azimuth Mark "SNAKE"
house
ST.
DIT & DR
RT. (P)
JOHNSON, THOMAS M. & ELLA L.
GEVRY, RHEAL P. SR. & GAIL L.
56
ADDISON 390+00 ~ 406+00
MM 1.07 ~ MM 1.38
POOR ORIGINAL COPY
MAY 05 1994
+3.615 %
SHOREHAM - BRIDPORT-ADDISON
F017-1(2)
Sheet 64 of 165
76