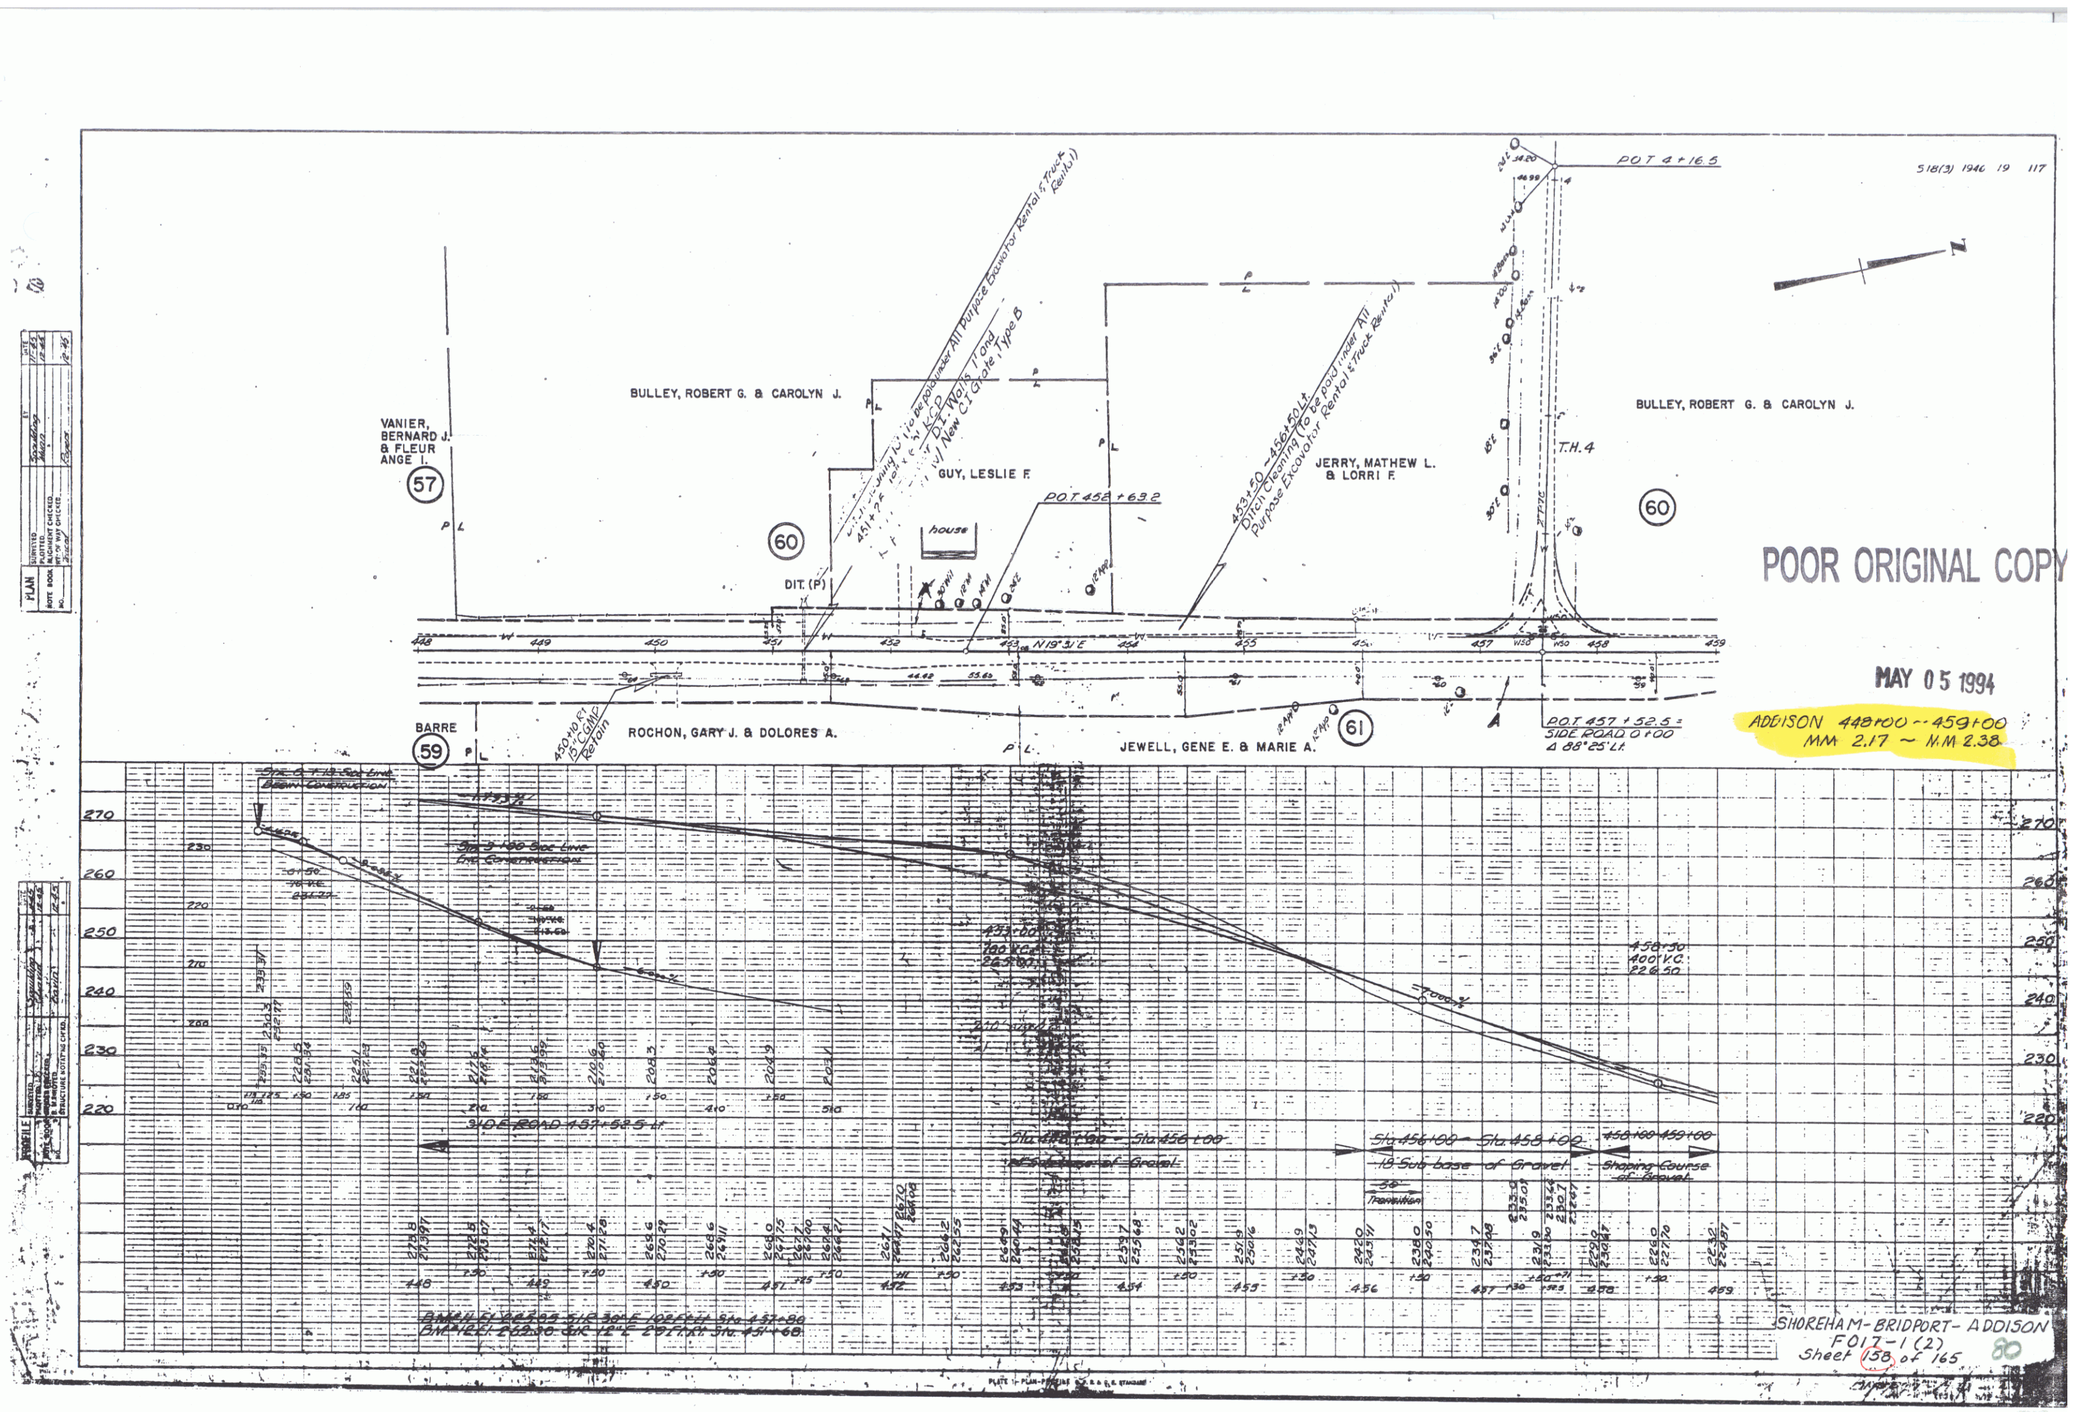

POOR ORIGINAL COPY

MAY 05 1994

ADDISON 448+00 -- 459+00
MM 2.17 ~ M.M 2.38