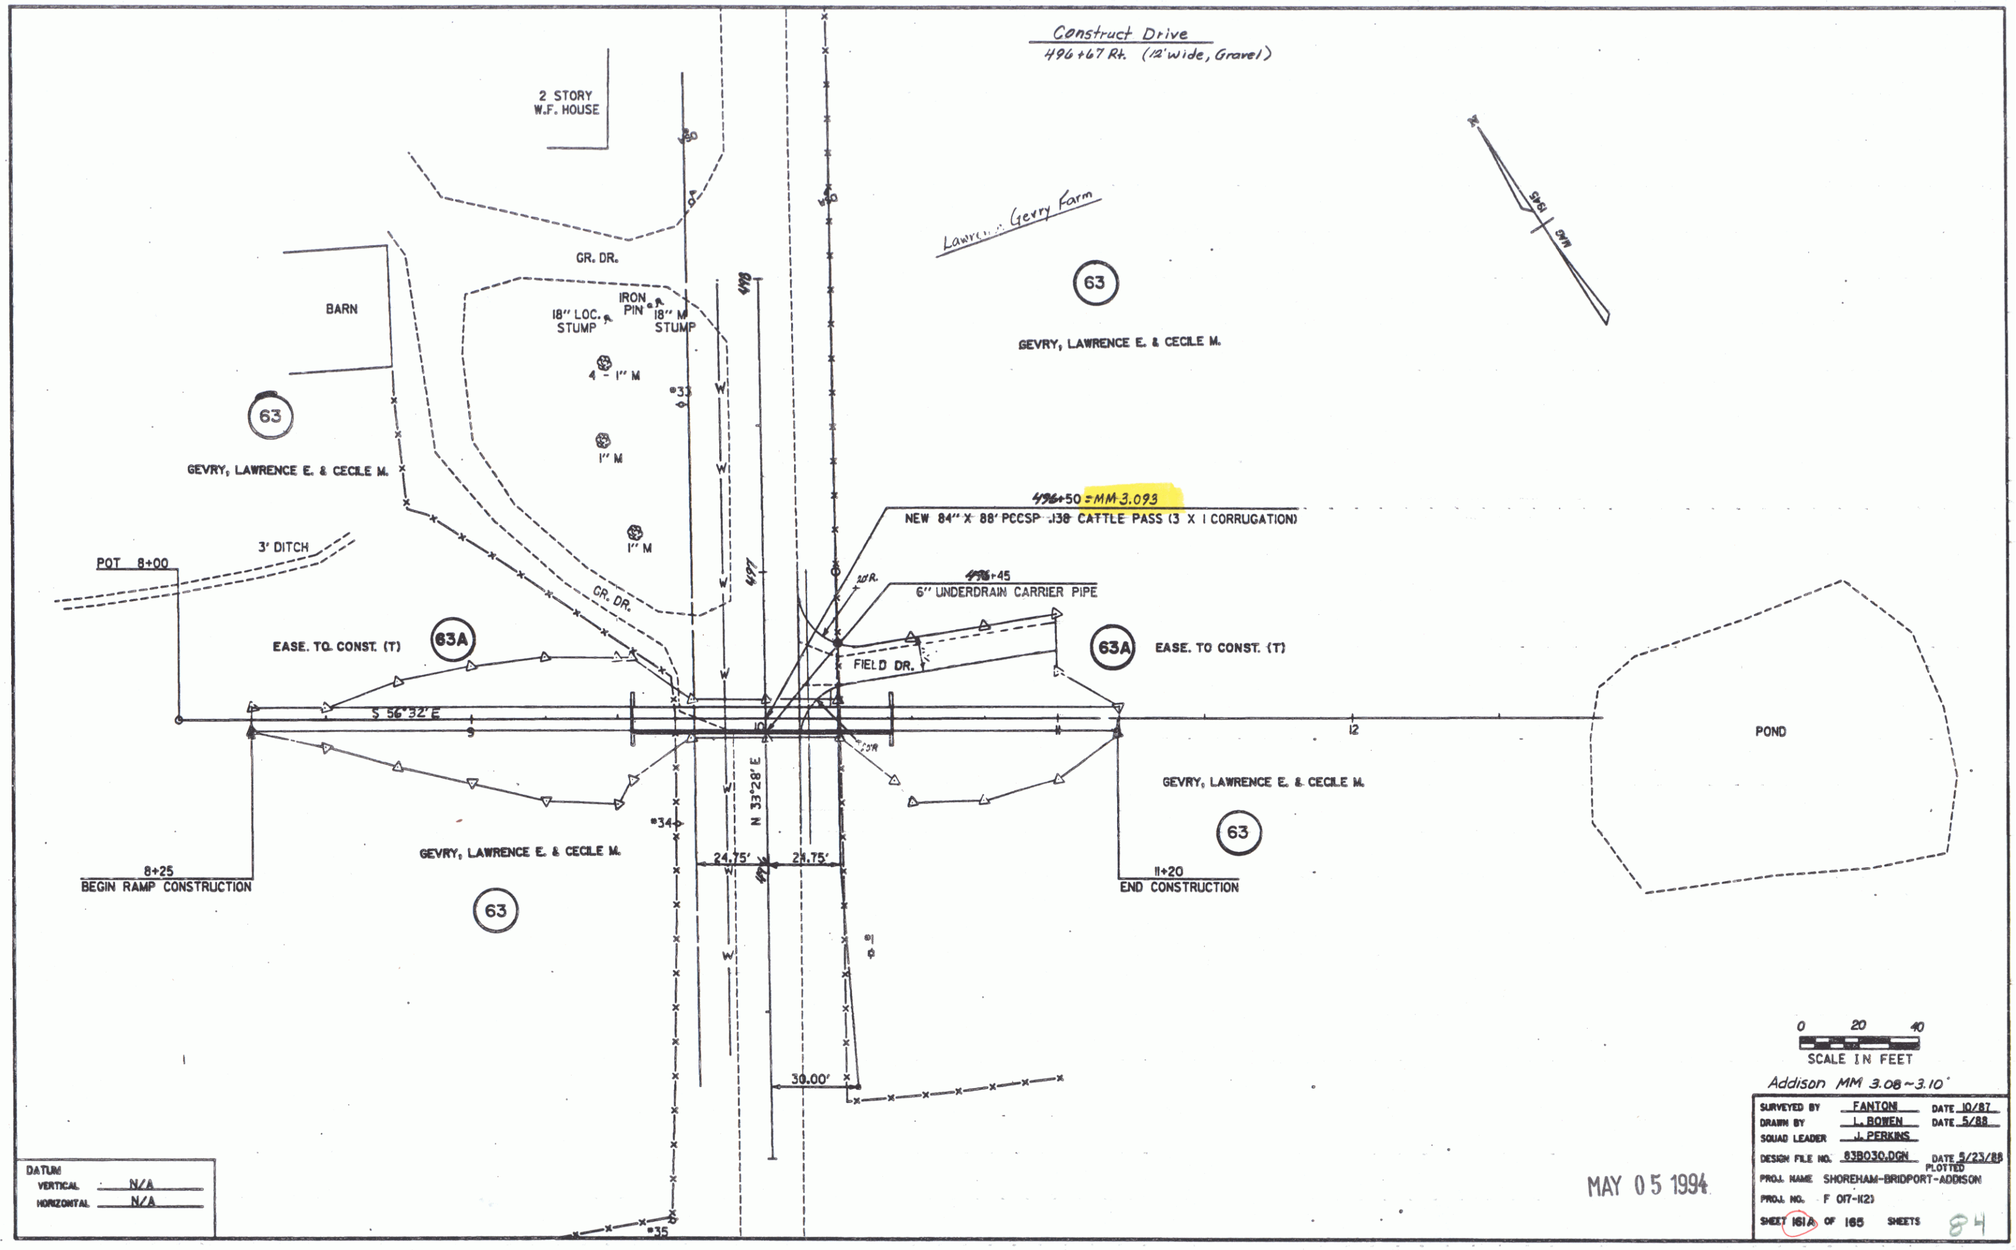
Construct Drive
496+67 Rt. (12' wide, Gravel)
Lawrence Gevry Farm
2 STORY
W.F. HOUSE
GR. DR.
BARN
IRON PIN
18" LOC. STUMP
18" M STUMP
4 - 1" M
1" M
1" M
63
GEVRY, LAWRENCE E. & CECILE M.
3' DITCH
POT 8+00
CR. DR.
EASE. TO. CONST. (T)
63A
496+50 = MM 3.093
NEW 84" X 88' PCCSP .138 CATTLE PASS (3 X 1 CORRUGATION)
496+45
6" UNDERDRAIN CARRIER PIPE
FIELD DR.
EASE. TO CONST. (T)
S 56°32' E
N 33°28' E
24.75'
24.75'
30.00'
8+25
BEGIN RAMP CONSTRUCTION
11+20
END CONSTRUCTION
POND
SCALE IN FEET
0 20 40
Addison MM 3.08 ~ 3.10
DATUM
VERTICAL N/A
HORIZONTAL N/A
SURVEYED BY FANTONI DATE 10/87
DRAWN BY L. BOWEN DATE 5/88
SQUAD LEADER J. PERKINS
DESIGN FILE NO. 83B030.DGN DATE PLOTTED 5/23/88
PROJ. NAME SHOREHAM-BRIDPORT-ADDISON
PROJ. NO. F 017-1(2)
SHEET 161A OF 165 SHEETS
84
MAY 05 1994