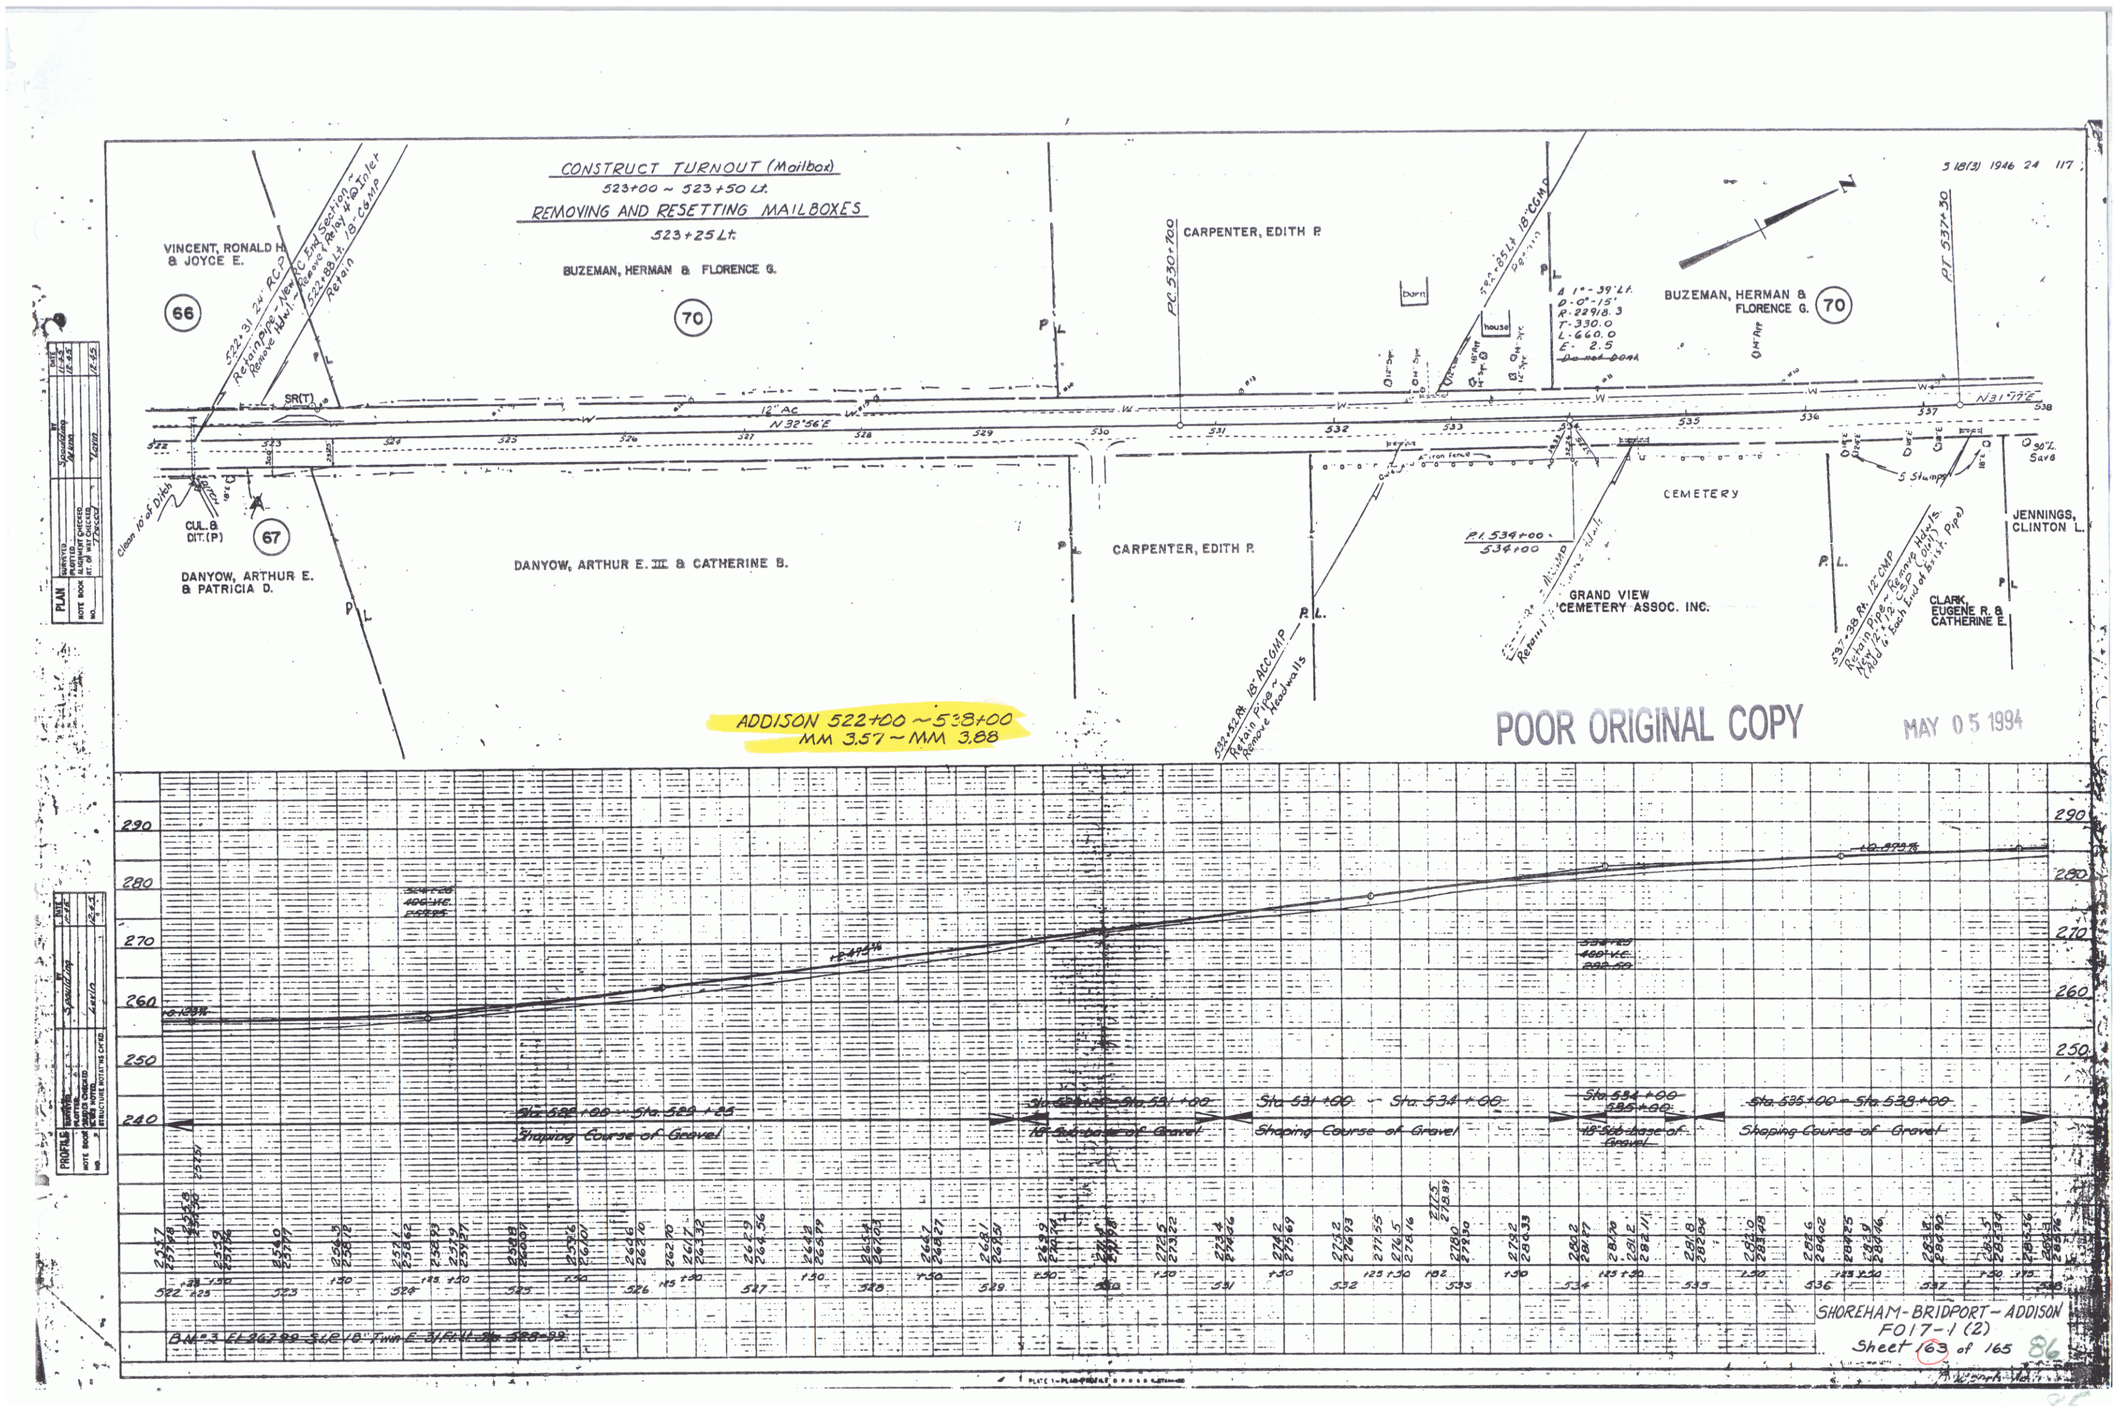
CONSTRUCT TURNOUT (Mailbox)
523+00 ~ 523+50 Lt.
REMOVING AND RESETTING MAILBOXES
523+25 Lt.
VINCENT, RONALD H. & JOYCE E.
66
BUZEMAN, HERMAN & FLORENCE G.
70
CARPENTER, EDITH P.
BUZEMAN, HERMAN & FLORENCE G.
70
CUL. & DIT. (P)
67
DANYOW, ARTHUR E. & PATRICIA D.
DANYOW, ARTHUR E. III & CATHERINE B.
CARPENTER, EDITH P.
CEMETERY
GRAND VIEW CEMETERY ASSOC. INC.
JENNINGS, CLINTON L.
CLARK, EUGENE R. & CATHERINE E.
PC 530+00
PT 537+30
PI 534+00
534+00
N 32°56'E
N 31°77'E
12" AC
ADDISON 522+00 ~ 538+00
MM 3.57 ~ MM 3.88
POOR ORIGINAL COPY
MAY 05 1994
PLAN
PROFILE
SHOREHAM-BRIDPORT-ADDISON
F017-1(2)
Sheet 163 of 165