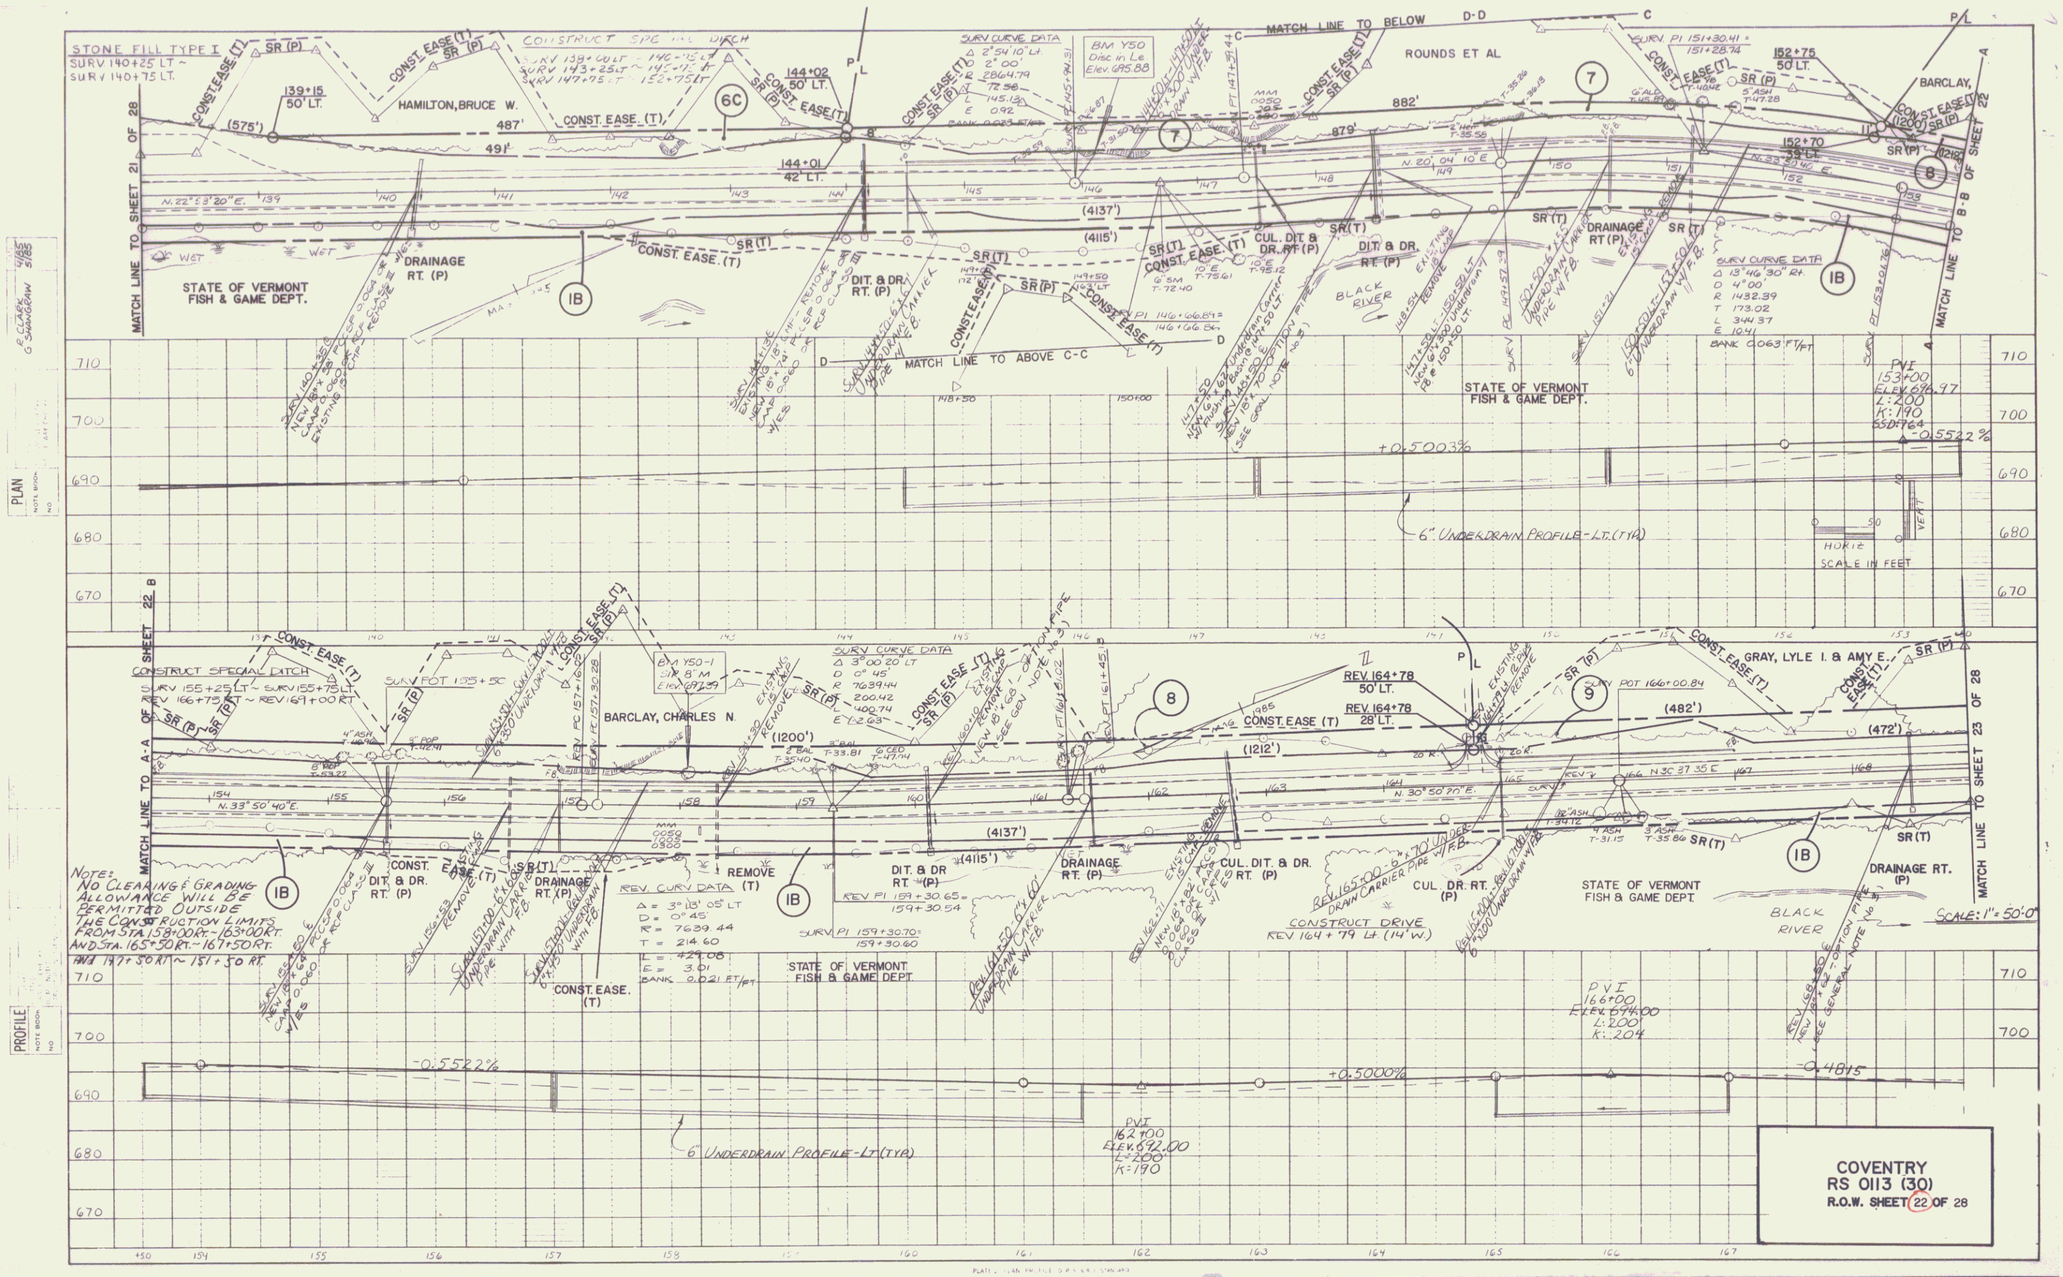
STONE FILL TYPE I
HAMILTON, BRUCE W.
STATE OF VERMONT FISH & GAME DEPT.
DRAINAGE RT. (P)
DIT. & DR. RT. (P)
CONST. EASE. (T)
MATCH LINE TO SHEET 21 OF 28
MATCH LINE TO ABOVE C-C
MATCH LINE TO BELOW
ROUNDS ET AL
BARCLAY,
BLACK RIVER
CUL. DIT. & DR. RT. (P)
CUL. DR. RT. (P)
MATCH LINE TO B-B OF SHEET 22
6" UNDERDRAIN PROFILE - LT. (TYP.)
HORIZ SCALE IN FEET
BARCLAY, CHARLES N.
GRAY, LYLE I. & AMY E.
CONSTRUCT DRIVE
REV. 164+78 50' LT.
REV. 164+78 28' LT.
MATCH LINE TO A-A OF SHEET 22 B
MATCH LINE TO SHEET 23 OF 28
SCALE: 1" = 50'-0"
NOTE: NO CLEARING & GRADING ALLOWANCE WILL BE PERMITTED OUTSIDE THE CONSTRUCTION LIMITS FROM STA. 158+00 RT. - 163+00 RT. AND STA. 165+50 RT. - 167+50 RT. AND 147+50 RT. ~ 151+50 RT.
PLAN
PROFILE
COVENTRY
RS 0113 (30)
R.O.W. SHEET 22 OF 28