UNCLASSIFIED CHANNEL EXCAVATION
RT
Rev
202+75 - 203+25

STONE FILL, TYPE II
RT
Rev
202+75 - 203+25

STEEL BEAM GUARD RAIL
RT
Rev
202+50 - 204+00

BREAKAWAY CABLE TERMINAL
RT
Rev
202+25 - 202+50

REV STA 197+86
BEGIN PROJECT
RS 0138 (8) C/I

REV CURVE DATA
Δ 70°47'30" LT
D 18°00'
R 318.31'
T 226.18'
L 393.29'
E 72.17'
BANK 0.077 ft/ft

WELCH, THOMAS J. & JULIE L.

1

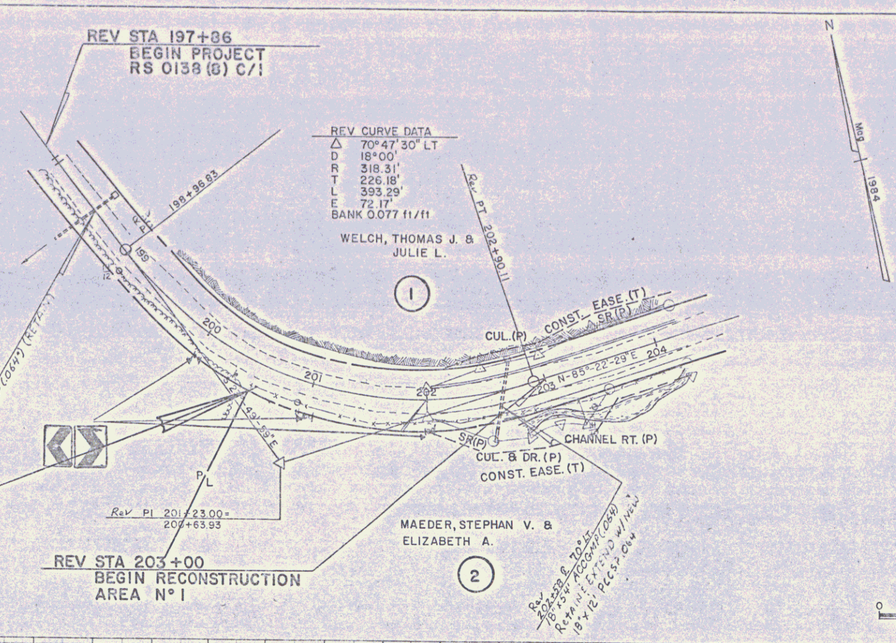

BEGIN R.O.W. PROJECT RS 0138 (8)
REV. STA. 200+52 25' RT.

REV STA 203+00
BEGIN RECONSTRUCTION
AREA N° 1

MAEDER, STEPHAN V. & ELIZABETH A.

2

N

M53
1984

TEMP. 4" WHITE LINE
197+86 - 204+00, 11' LT.
197+86 - 204+00, 11' RT.

TEMP. 4" YELLOW LINE
197+86 - 204+00 ℄ (DBL.)

GENERAL SIGN NOTE.

SIGN LOCATIONS SHOWN ARE APPROXIMATE. REFER TO SIGN SUMMARY SHEET FOR CORRECT STATIONS. OFFSETS ARE SHOWN IN THE STANDARD SHEETS.

0 50 100
SCALE IN FEET

DATUM
VERTICAL NGVD 1929
HORIZONTAL N/A

R.O.W. PLANS

WALLINGFORD & MT. HOLLY
RS 0138 (8)
SHEET 10 OF 22

PLOTTED
BOARD CHECKED
R.O.W. INSPECTOR
STRUCTURE INVOLVED CHKD
NOTE BOOK
NO.

DRAWING 44-1311-5428

PLATE 1 SINGLE PLAN - PROFILE
CHARLES BRUNNING CO.

10

MAR 19 1993