

**CONSTRUCT DRIVES**  
 560+13 RT 12' WIDE  
 570+15 RT 12' WIDE  
 570+45 LT 16' WIDE  
 571+18 RT 12' WIDE  
 574+01 LT 12' WIDE  
 576+45 LT 16' WIDE  
 577+68 LT 12' WIDE  
 579+07 RT 12' WIDE  
 TH-15: 10+38 12' WIDE  
 11+00 12' WIDE

NOTE: WATER MARKER POSTS ARE TO BE THE RESPONSIBILITY OF THE UTILITY.


SAND BORROW ITEM 203.3)  
 565+00 ~ 582+00

**SPECIAL DITCH**  
 571+02 RT ~ 578+51 RT  
 578+50 LT ~ 578+77 LT  
 TH-15: 10+50 LT ~ 11+00 LT

DATE	
BY	
PROJECT	
NO.	
SCALE	
DATE	
BY	
PROJECT	
NO.	
SCALE	

DATUM  
 VERTICAL - NGVD, 1929  
 HORIZONTAL - N/A

DATE	
BY	
PROJECT	
NO.	
SCALE	
DATE	
BY	
PROJECT	
NO.	
SCALE	

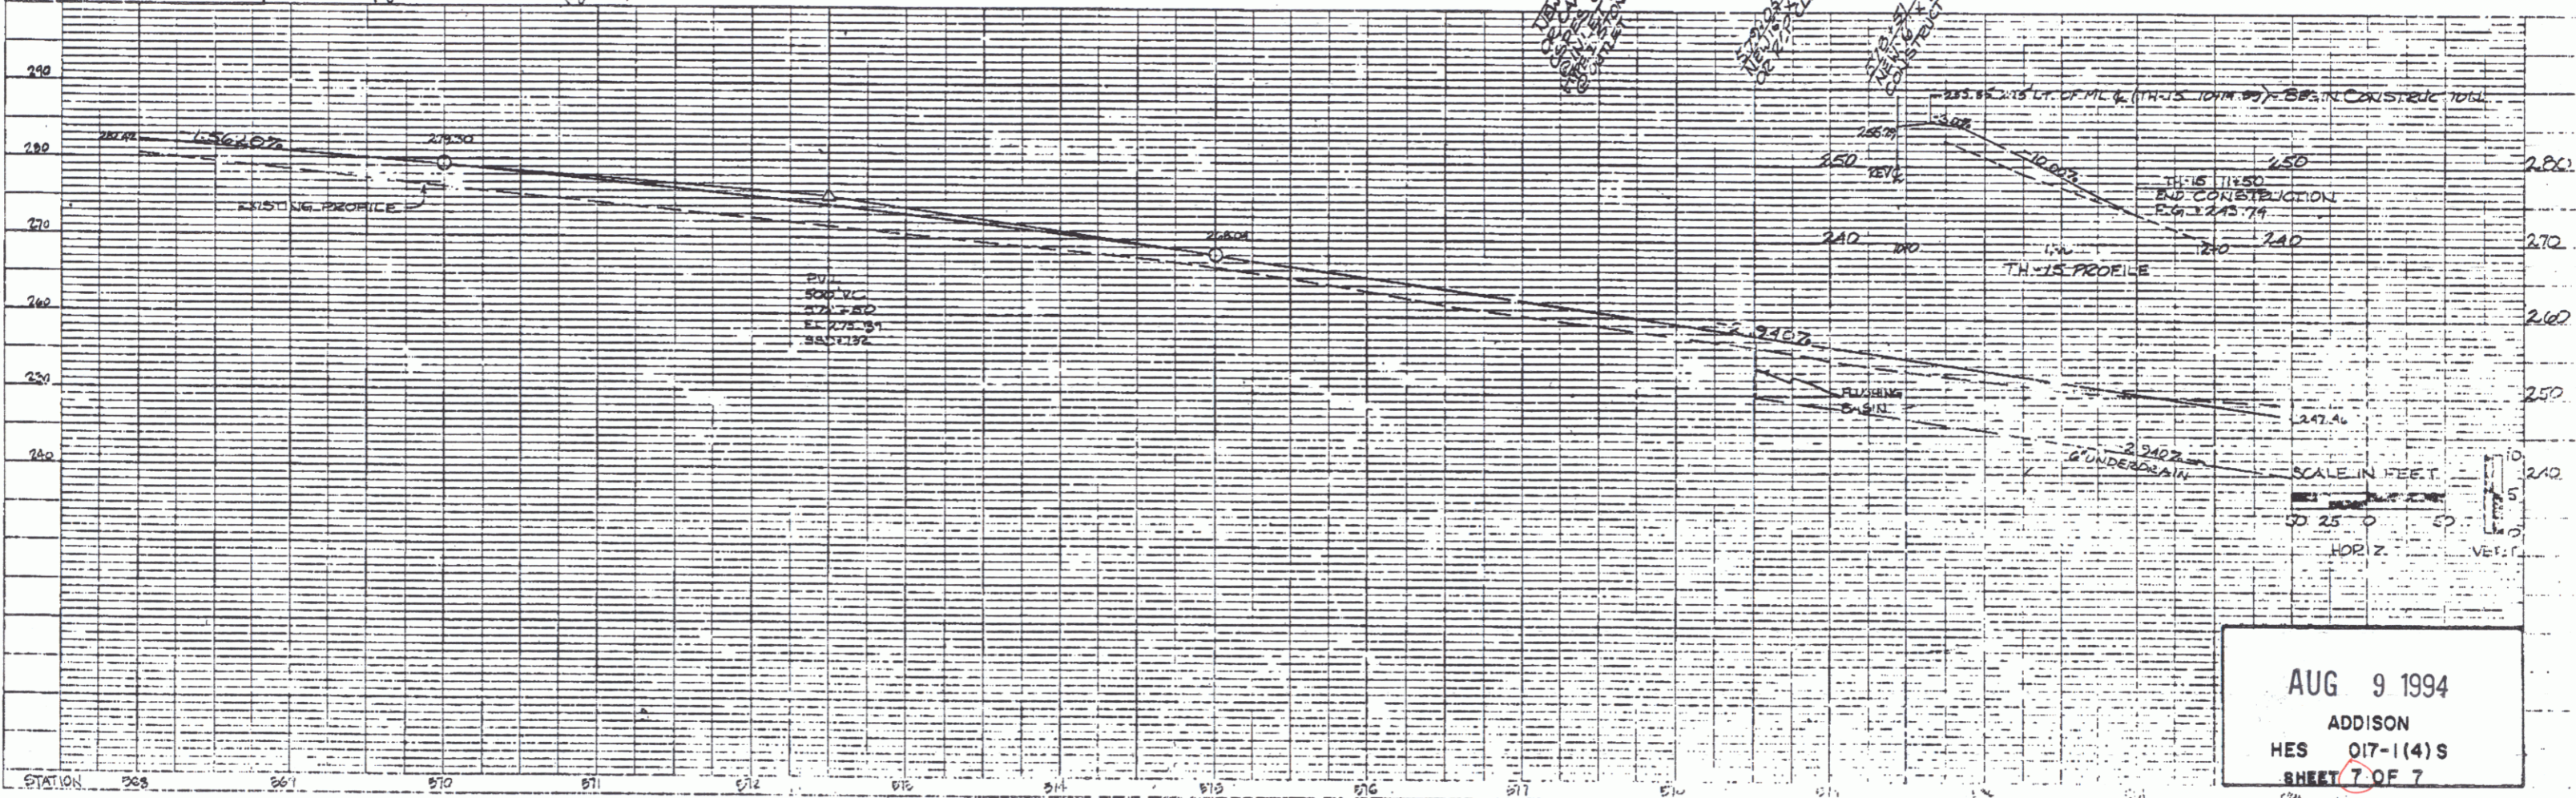

STONE FILL TYPE 2, ITEM 63.10  
 574+01 ~ 582+00 RT  
 TH-15: 10+50 LT ~ 11+00 LT

EROSION MATING ITEM 64.10  
 565+00 RT ~ 571+50 RT  
 78+50 LT ~ 87+77 LT

NOTE: 5' X 10' STA 579+50 RT TO BE REMOVED BY OWNER.

SCALE IN FEET  
 HORIZ. 1" = 25'  
 VERT. 1" = 5'

AUG 9 1994  
 ADDISON  
 HES 017-11(4)S  
 SHEET 7 OF 7