


POOR ORIGINAL COPY

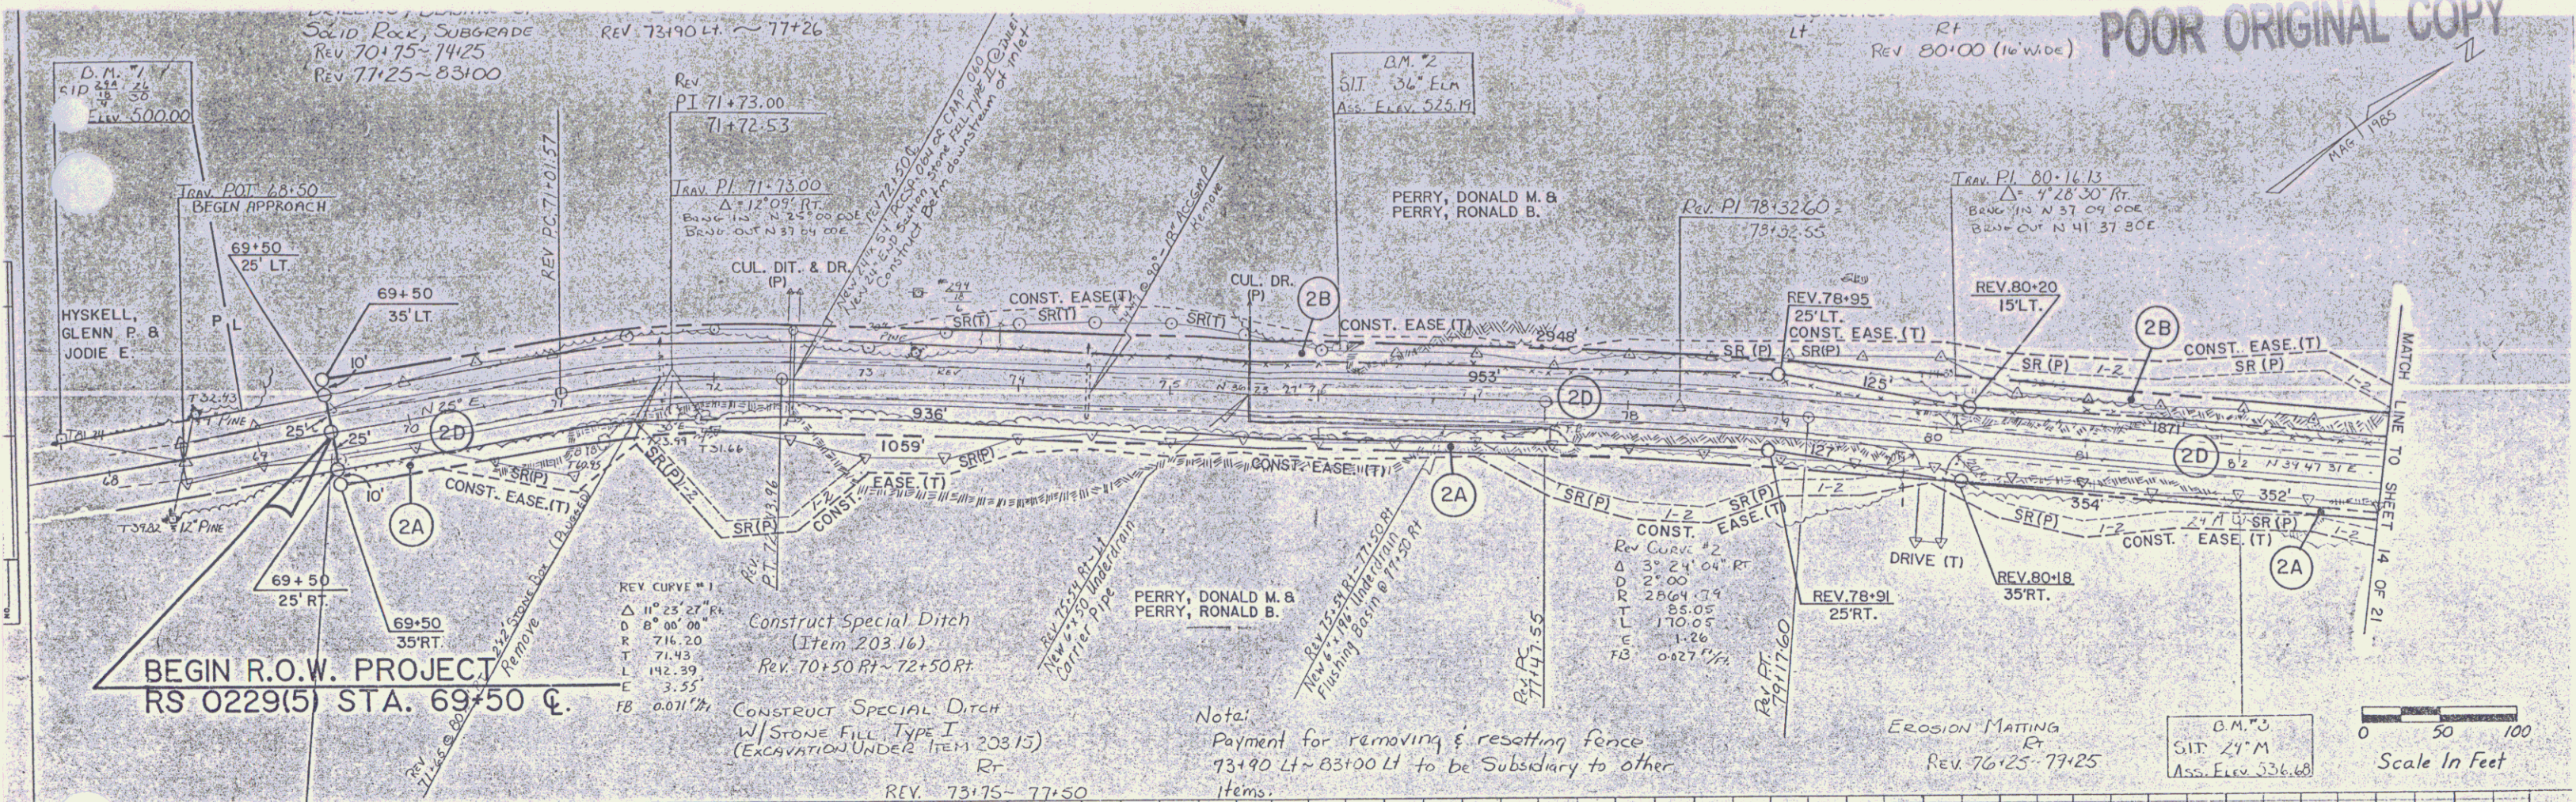

BEGIN R.O.W. PROJECT
RS 0229(5) STA. 69+50 C.

Construct Special Ditch
(Item 203.16)
REV. 70+50 RT ~ 72+50 RT


Construct Special Ditch
W/STONE FILL TYPE I
(EXCAVATION UNDER ITEM 203.15)
RT
REV. 73+75 ~ 77+50

Notes:
Payment for removing & resetting fence
73+90 Lt ~ 83+00 Lt to be Subsidiary to other
Items.

Rev Curve #2
Δ 3° 24' 04" RT
D 27.00
R 2864.74
T 86.05
L 170.05
E 1.26
FB 0.027 1/2%

O.M.#3
SIT. 21'M
Ass. Elev. 536.68

Scale In Feet
0 50 100

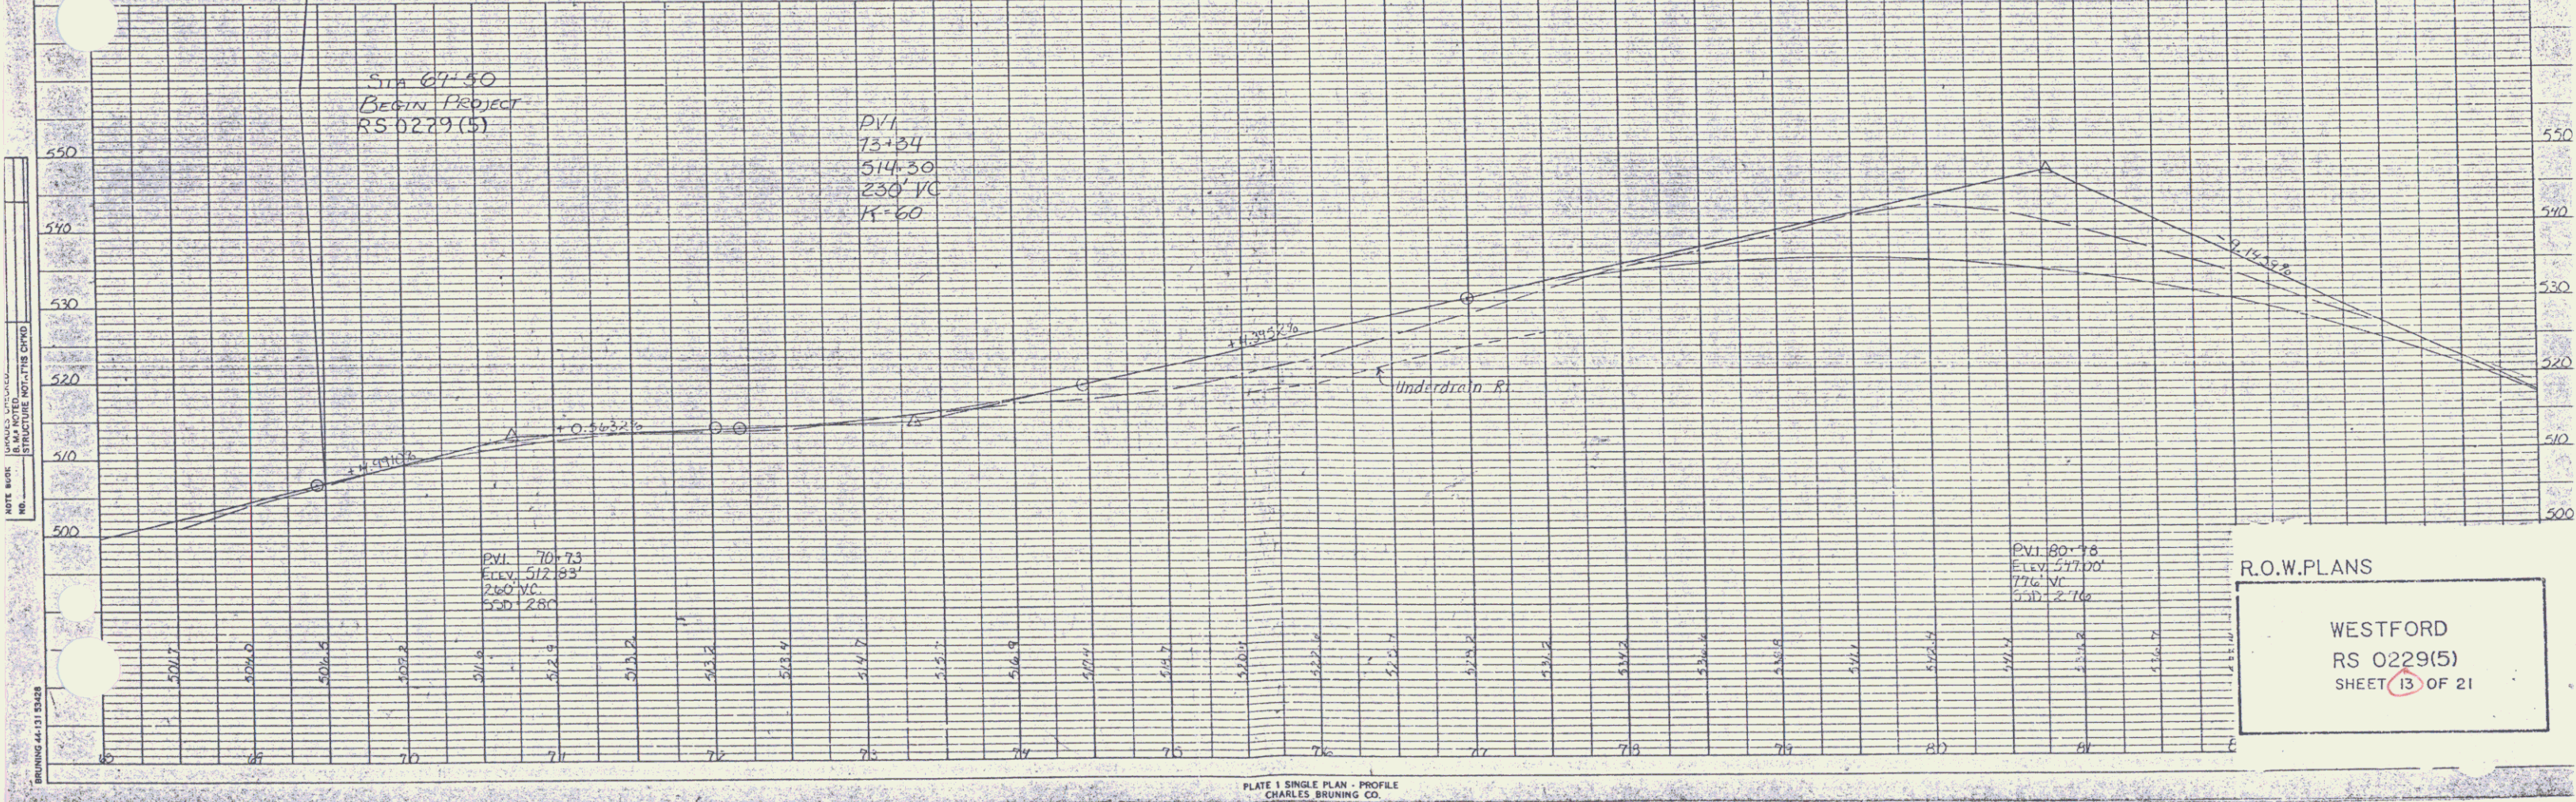

R.O.W. PLANS
WESTFORD
RS 0229(5)
SHEET 13 OF 21