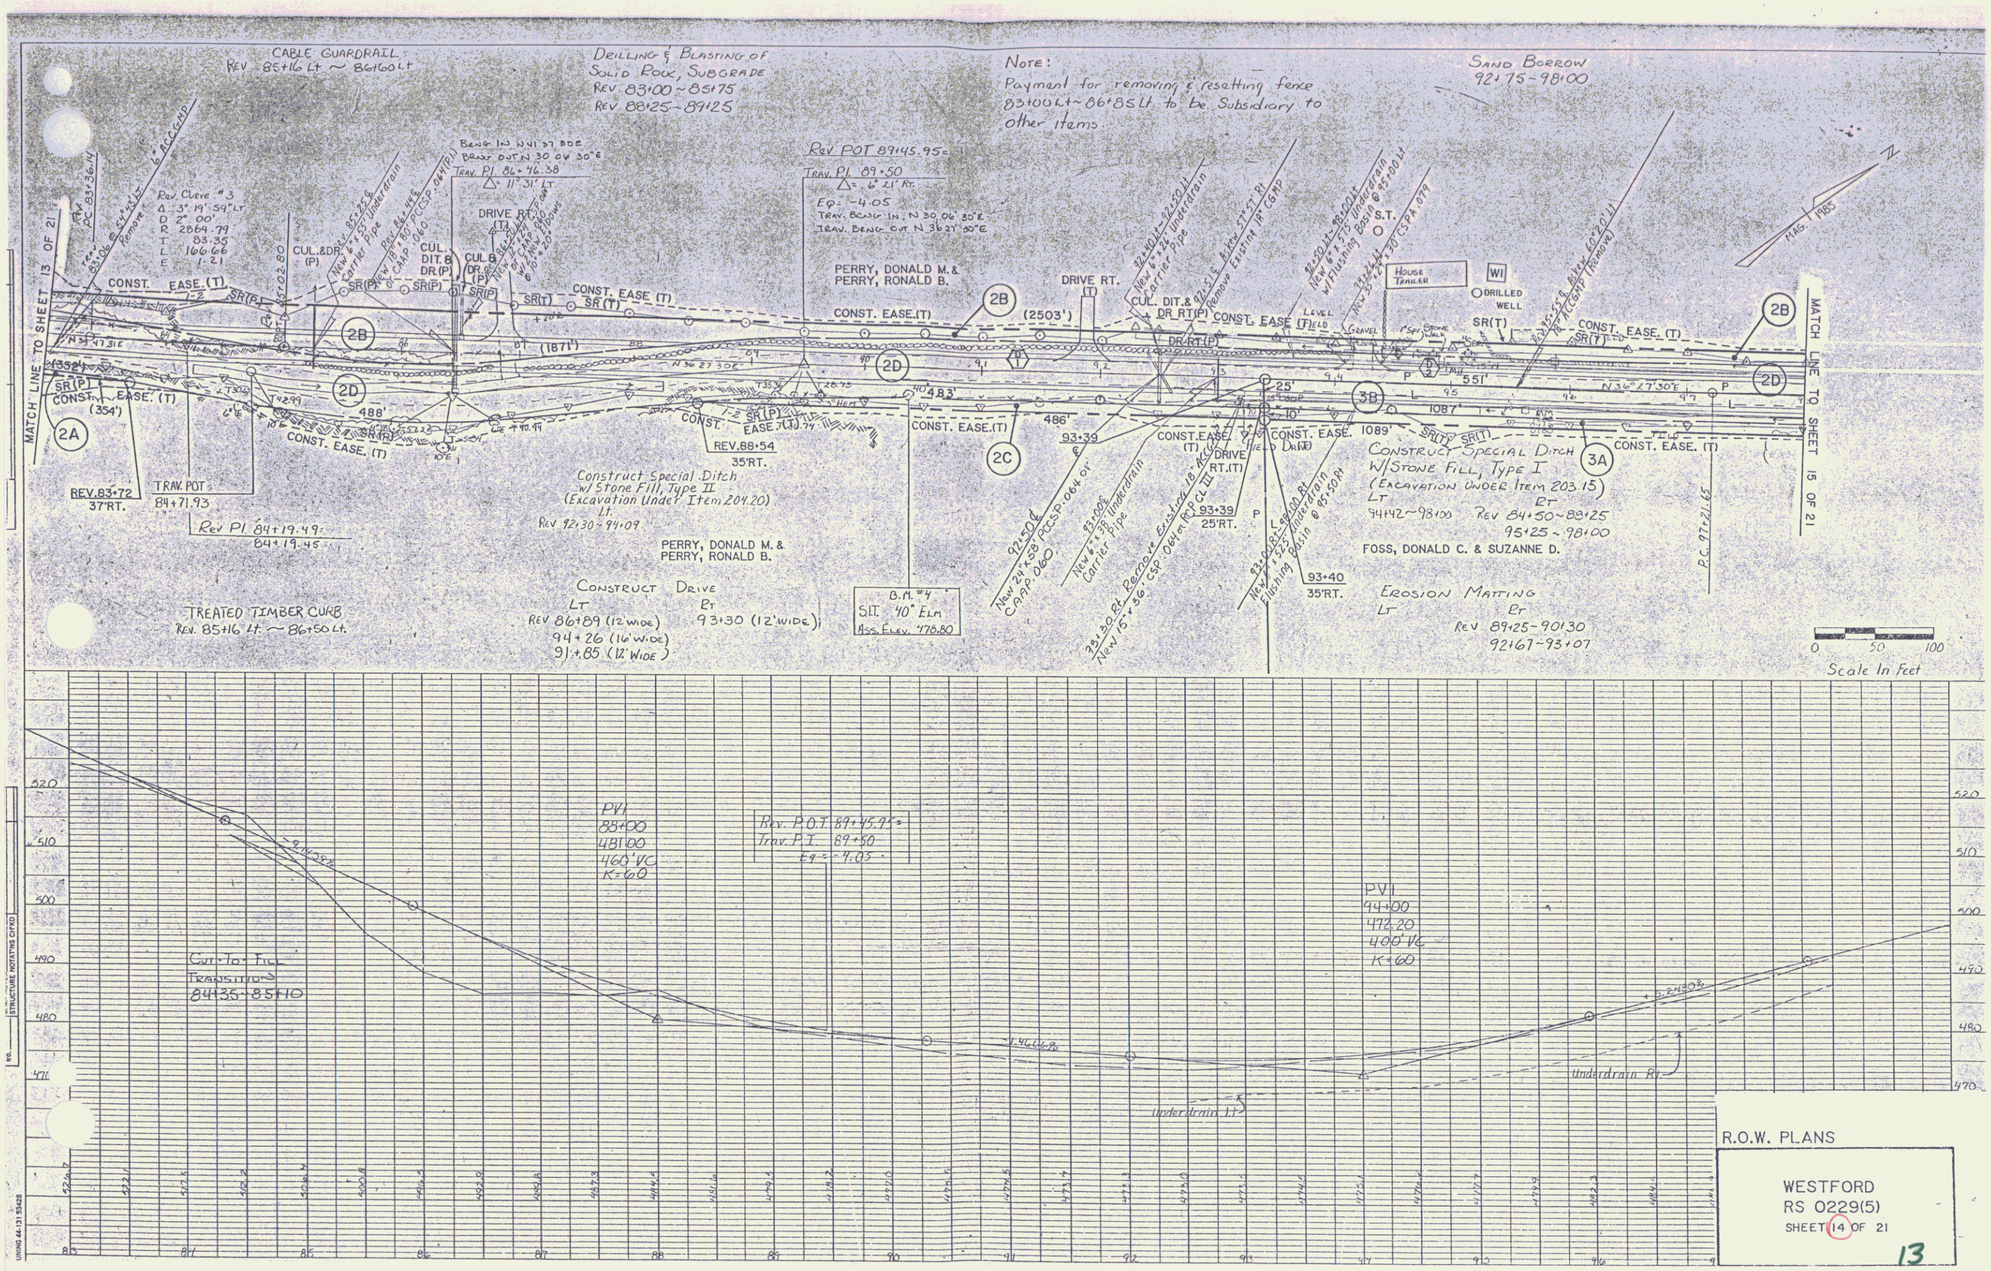

R.O.W. PLANS

WESTFORD
RS 0229(5)
SHEET 14 OF 21

13