STATE OF VERMONT
AGENCY OF TRANSPORTATION

R.O.W. PLANS

TOWNS OF STOWE—MORRISTOWN

COUNTY OF LAMOILLE

RTE. 100

LENGTH OF R.O.W. PROJ. 1850.00 FEET = 0.350 MILES

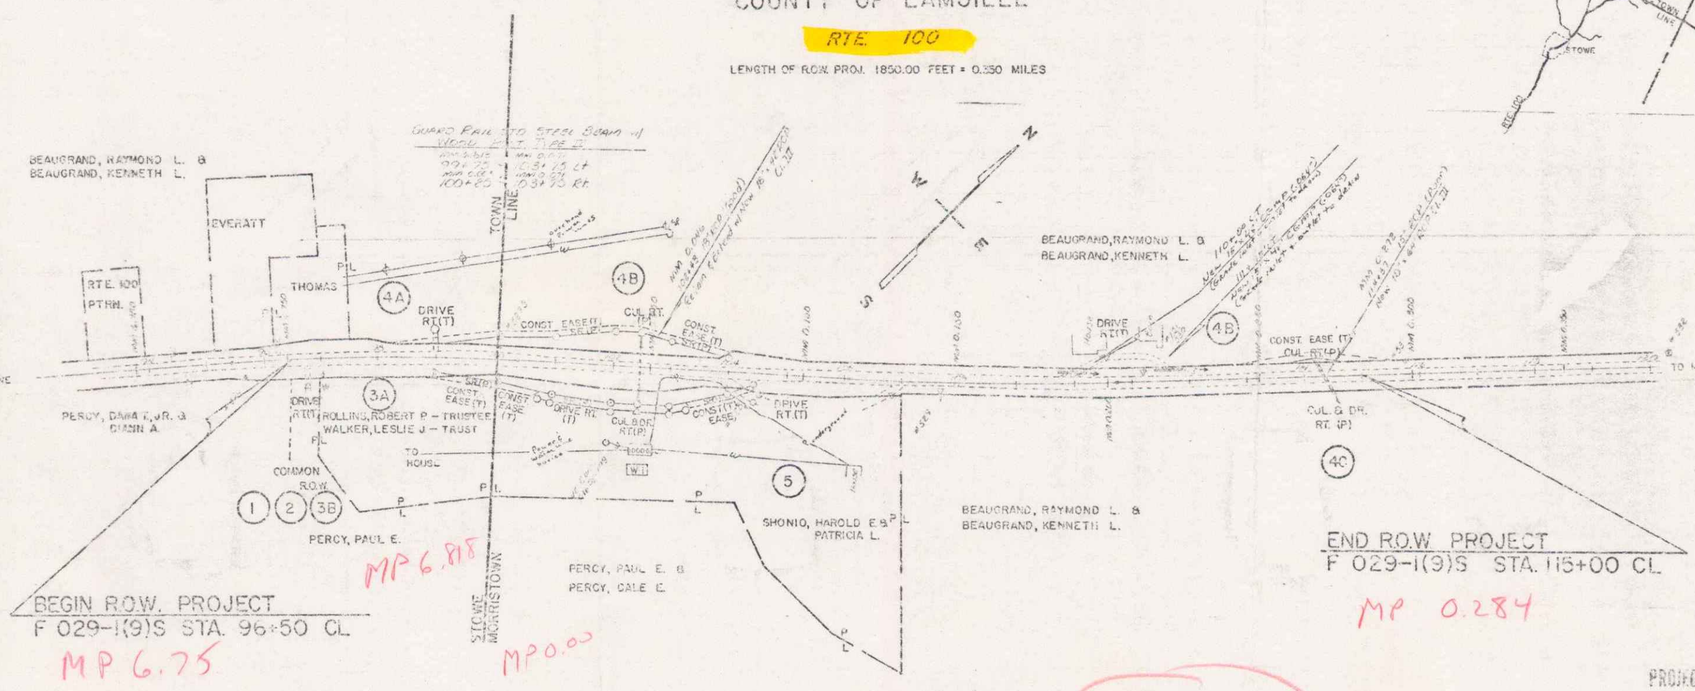

Stowe
Construct Drive
97+44 LT
96+67 RT
96+27 LT
95+77 RT
99+00 LT
101+75 – 103+35 RT
(Kilwine Service Dr.)

Morrristown
Construct Drive
104+00 RT (Paved)
106+85 RT (Paved)
110+00 LT
111+13 LT

OCT 27 1986

PROJECT PROCESSED UNDER SECONDARY ROAD PLAN

ALL DRIVES AS INDICATED ON PLANS ARE SUBJECT TO PERMITS PURSUANT TO TITLE 19, SECTION 43, V.S.A.

PROJECT: F 029-1(9)S
TOWN: STOWE
ROUTE: VT 100
P.N.: 84B903
DATE: 04/10/1985

Pin # 84B903

SUBMITTED BY ENDORSEMENT THE STATE TRANSPORTATION BOARD

APPROVED [signature] DATE [illegible]
DIRECTOR OF ENGINEERING AND CONSTRUCTION

APPROVED [signature] DATE [illegible]
CHIEF, PROPERTY ADMINISTRATION

STOWE – MORRISTOWN

Project No. F 029-1(9)S

SHEET 1 OF 2

1