PLAN		BY	DATE
NOTE BOOK NO.	SURVEYED PLOTTED CALCULATIONS CHECKED AS-BUILT CHECKED		

DATUM
VERTICAL NGVD 1929
HORIZONTAL N/A

AUG 3 1994

PROFILE		BY	DATE
NOTE BOOK NO.	SURVEYED PLOTTED CALCULATIONS CHECKED AS-BUILT CHECKED STRUCTURE INVENTRY CPTRD		

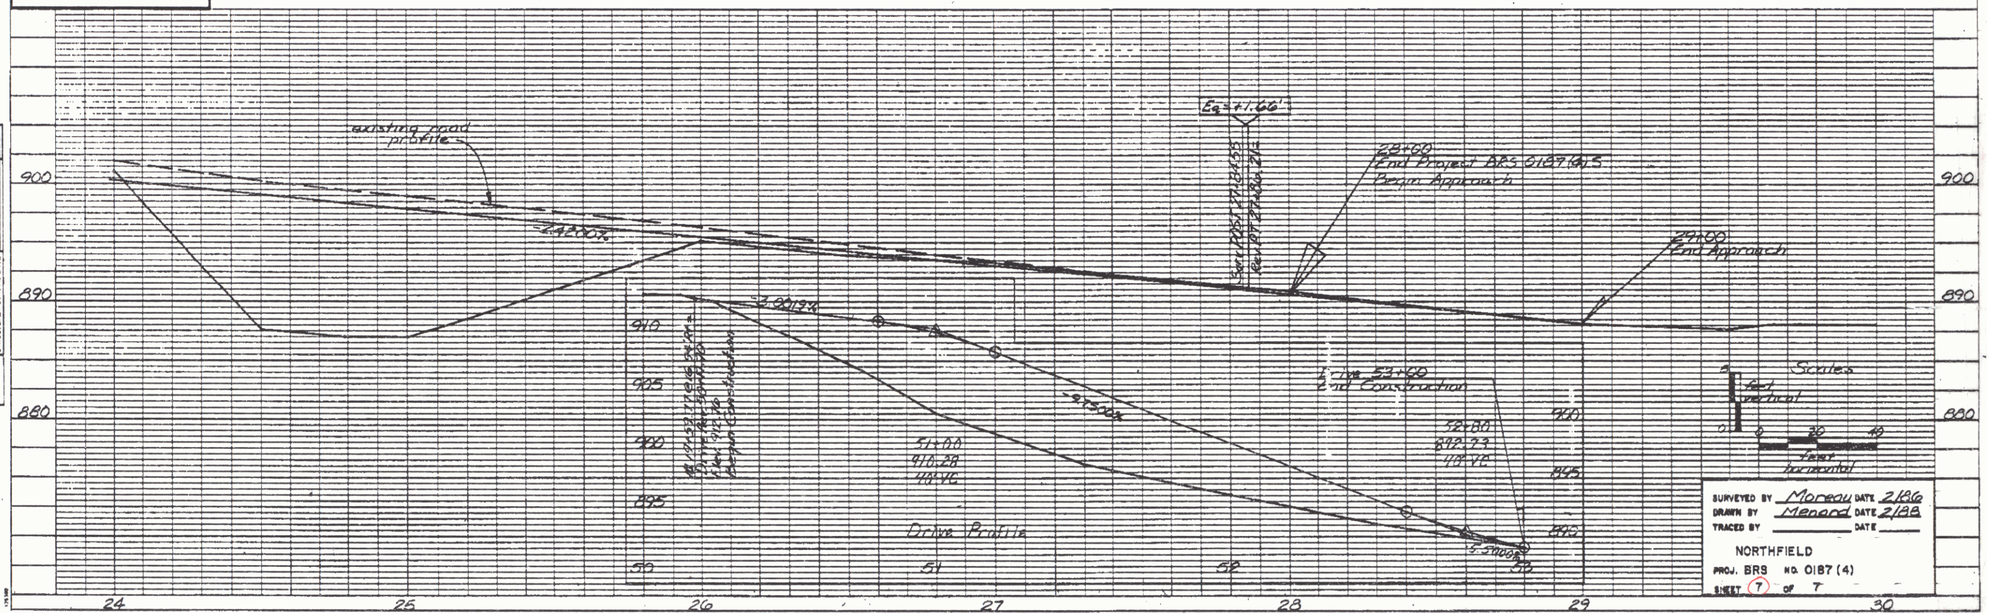

SURVEYED BY Moreau DATE 2/86
DRAWN BY Menard DATE 2/88
TRACED BY _____ DATE _____

NORTHFIELD
PROJ. BRS NO. 0187 (4)
SHEET 7 OF 7

PLATE 1 SINGLE PLAN - PROFILE
CHARLES BRUNNER CO.

7