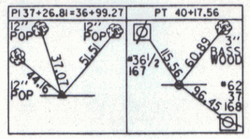

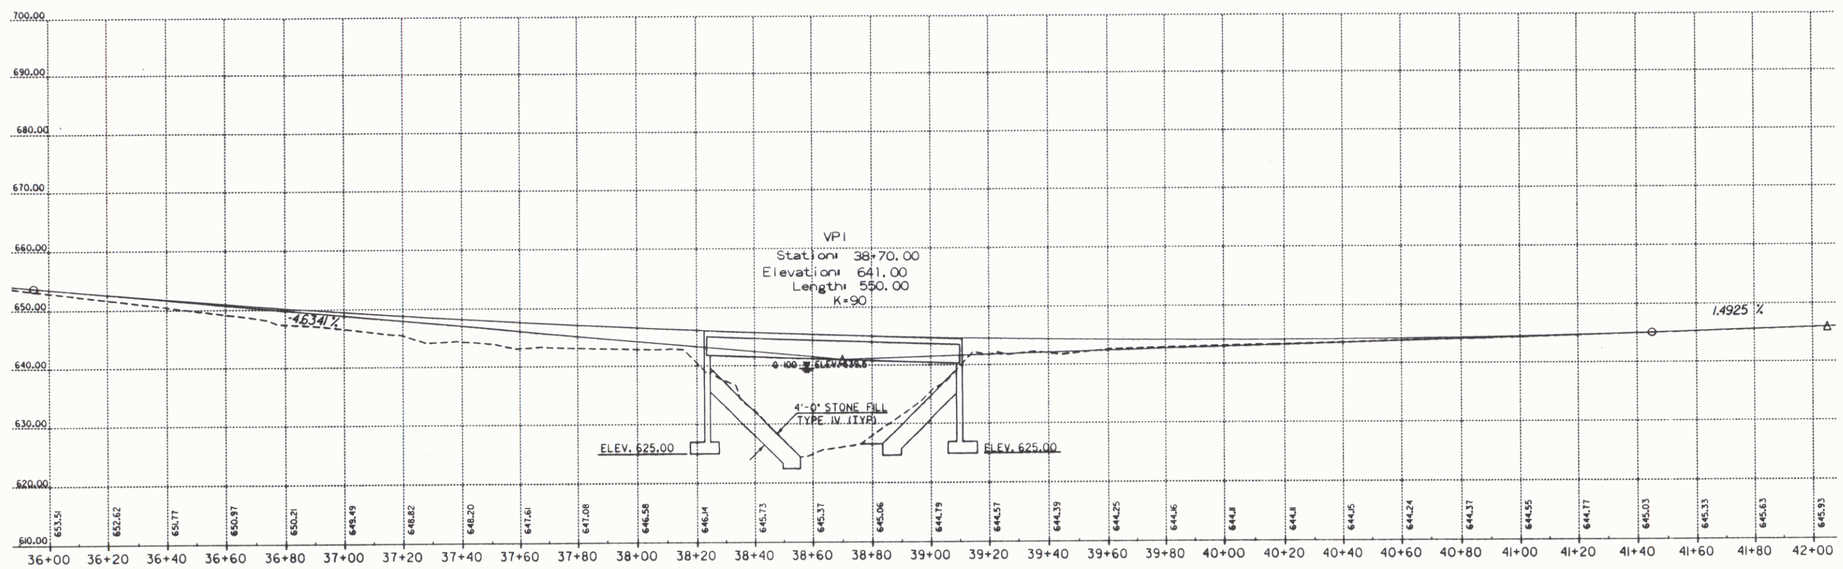

SCALES IN FEET

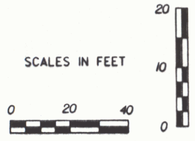

SURVEYED BY	SHERIDAN	DATE	8/88
DRAWN BY	SQUAD B	DATE	8/89
SQUAD LEADER	DUBRAY		
DESIGN FILE NO.	ZF2(52,50)85E033Z.DGN		
IPARM FILE	85E033P2	DATE PLOTTED	25-MAR-1993

RANDOLPH
BRS 0147(14)
R.O.W. SHEET 4 OF 11 SHEETS

DATUM
VERTICAL N/A
HORIZONTAL NGVD 1929

FEB 07 1997 4