


|      |           |  |
|------|-----------|--|
| PLAN | DATE      |  |
|      | BY        |  |
|      | SURVEYED  |  |
|      | NOTE BOOK |  |
|      | NO.       |  |

|         |           |  |
|---------|-----------|--|
| PROFILE | DATE      |  |
|         | BY        |  |
|         | SURVEYED  |  |
|         | NOTE BOOK |  |
|         | NO.       |  |

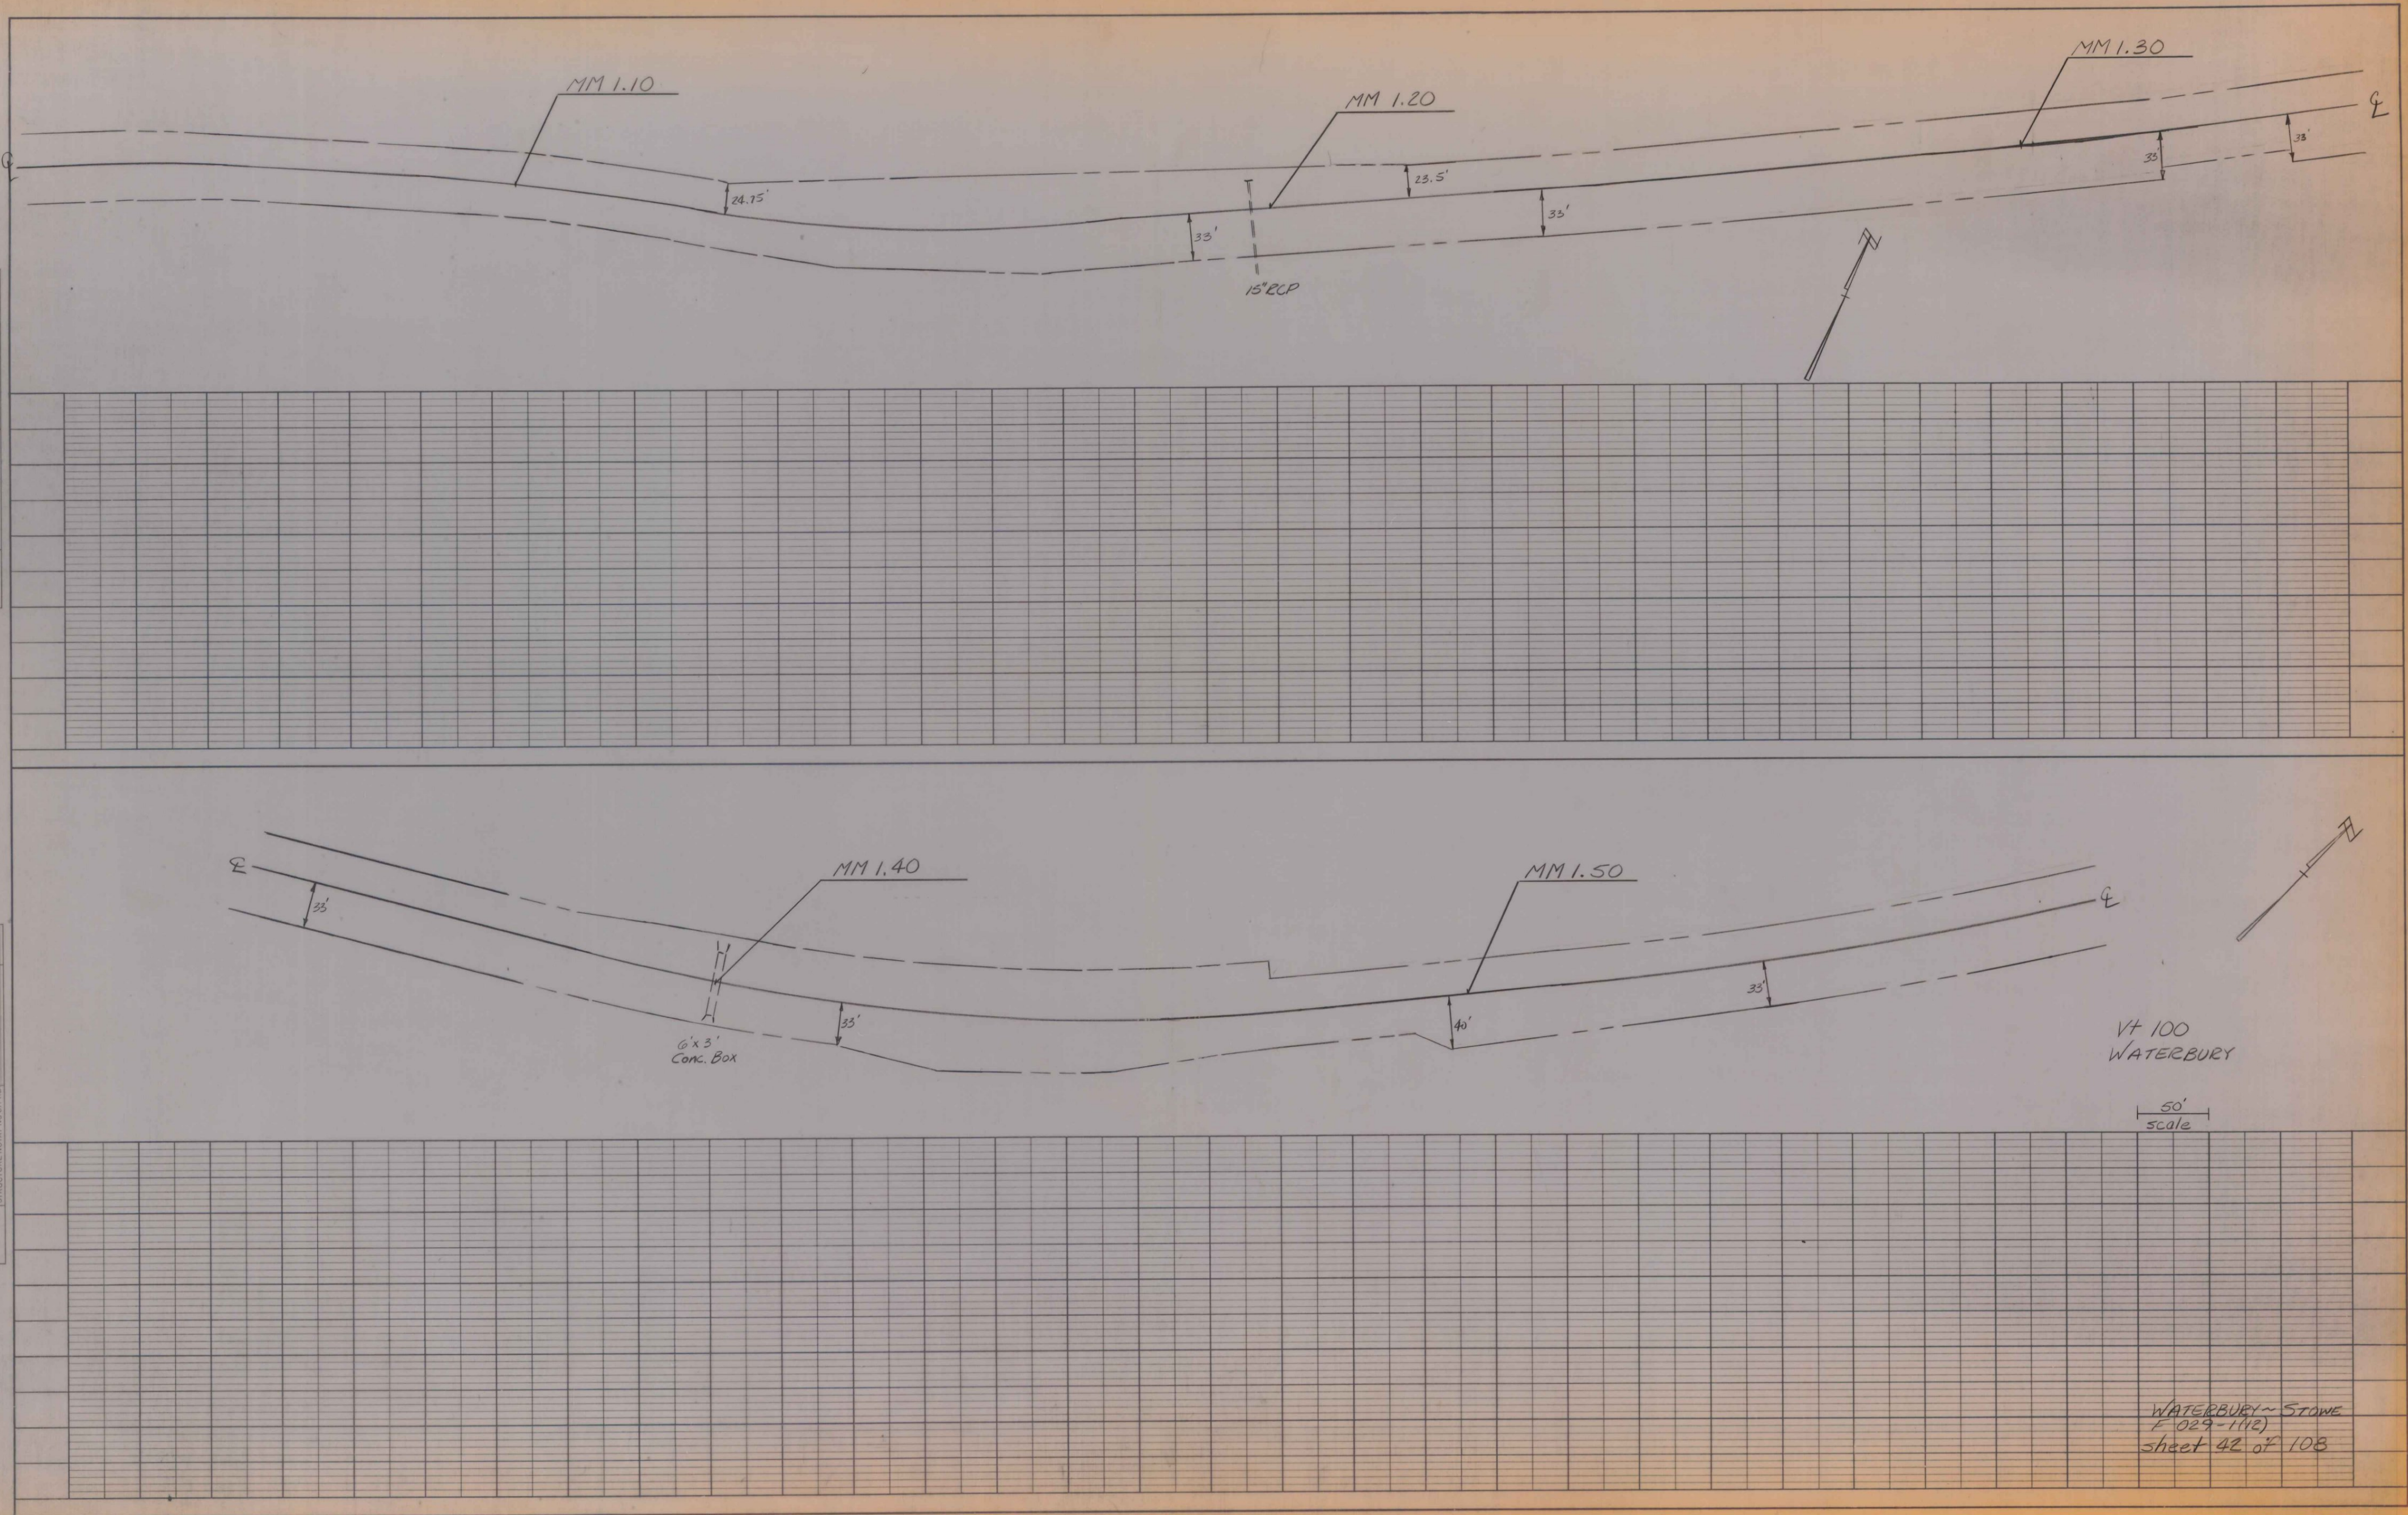

