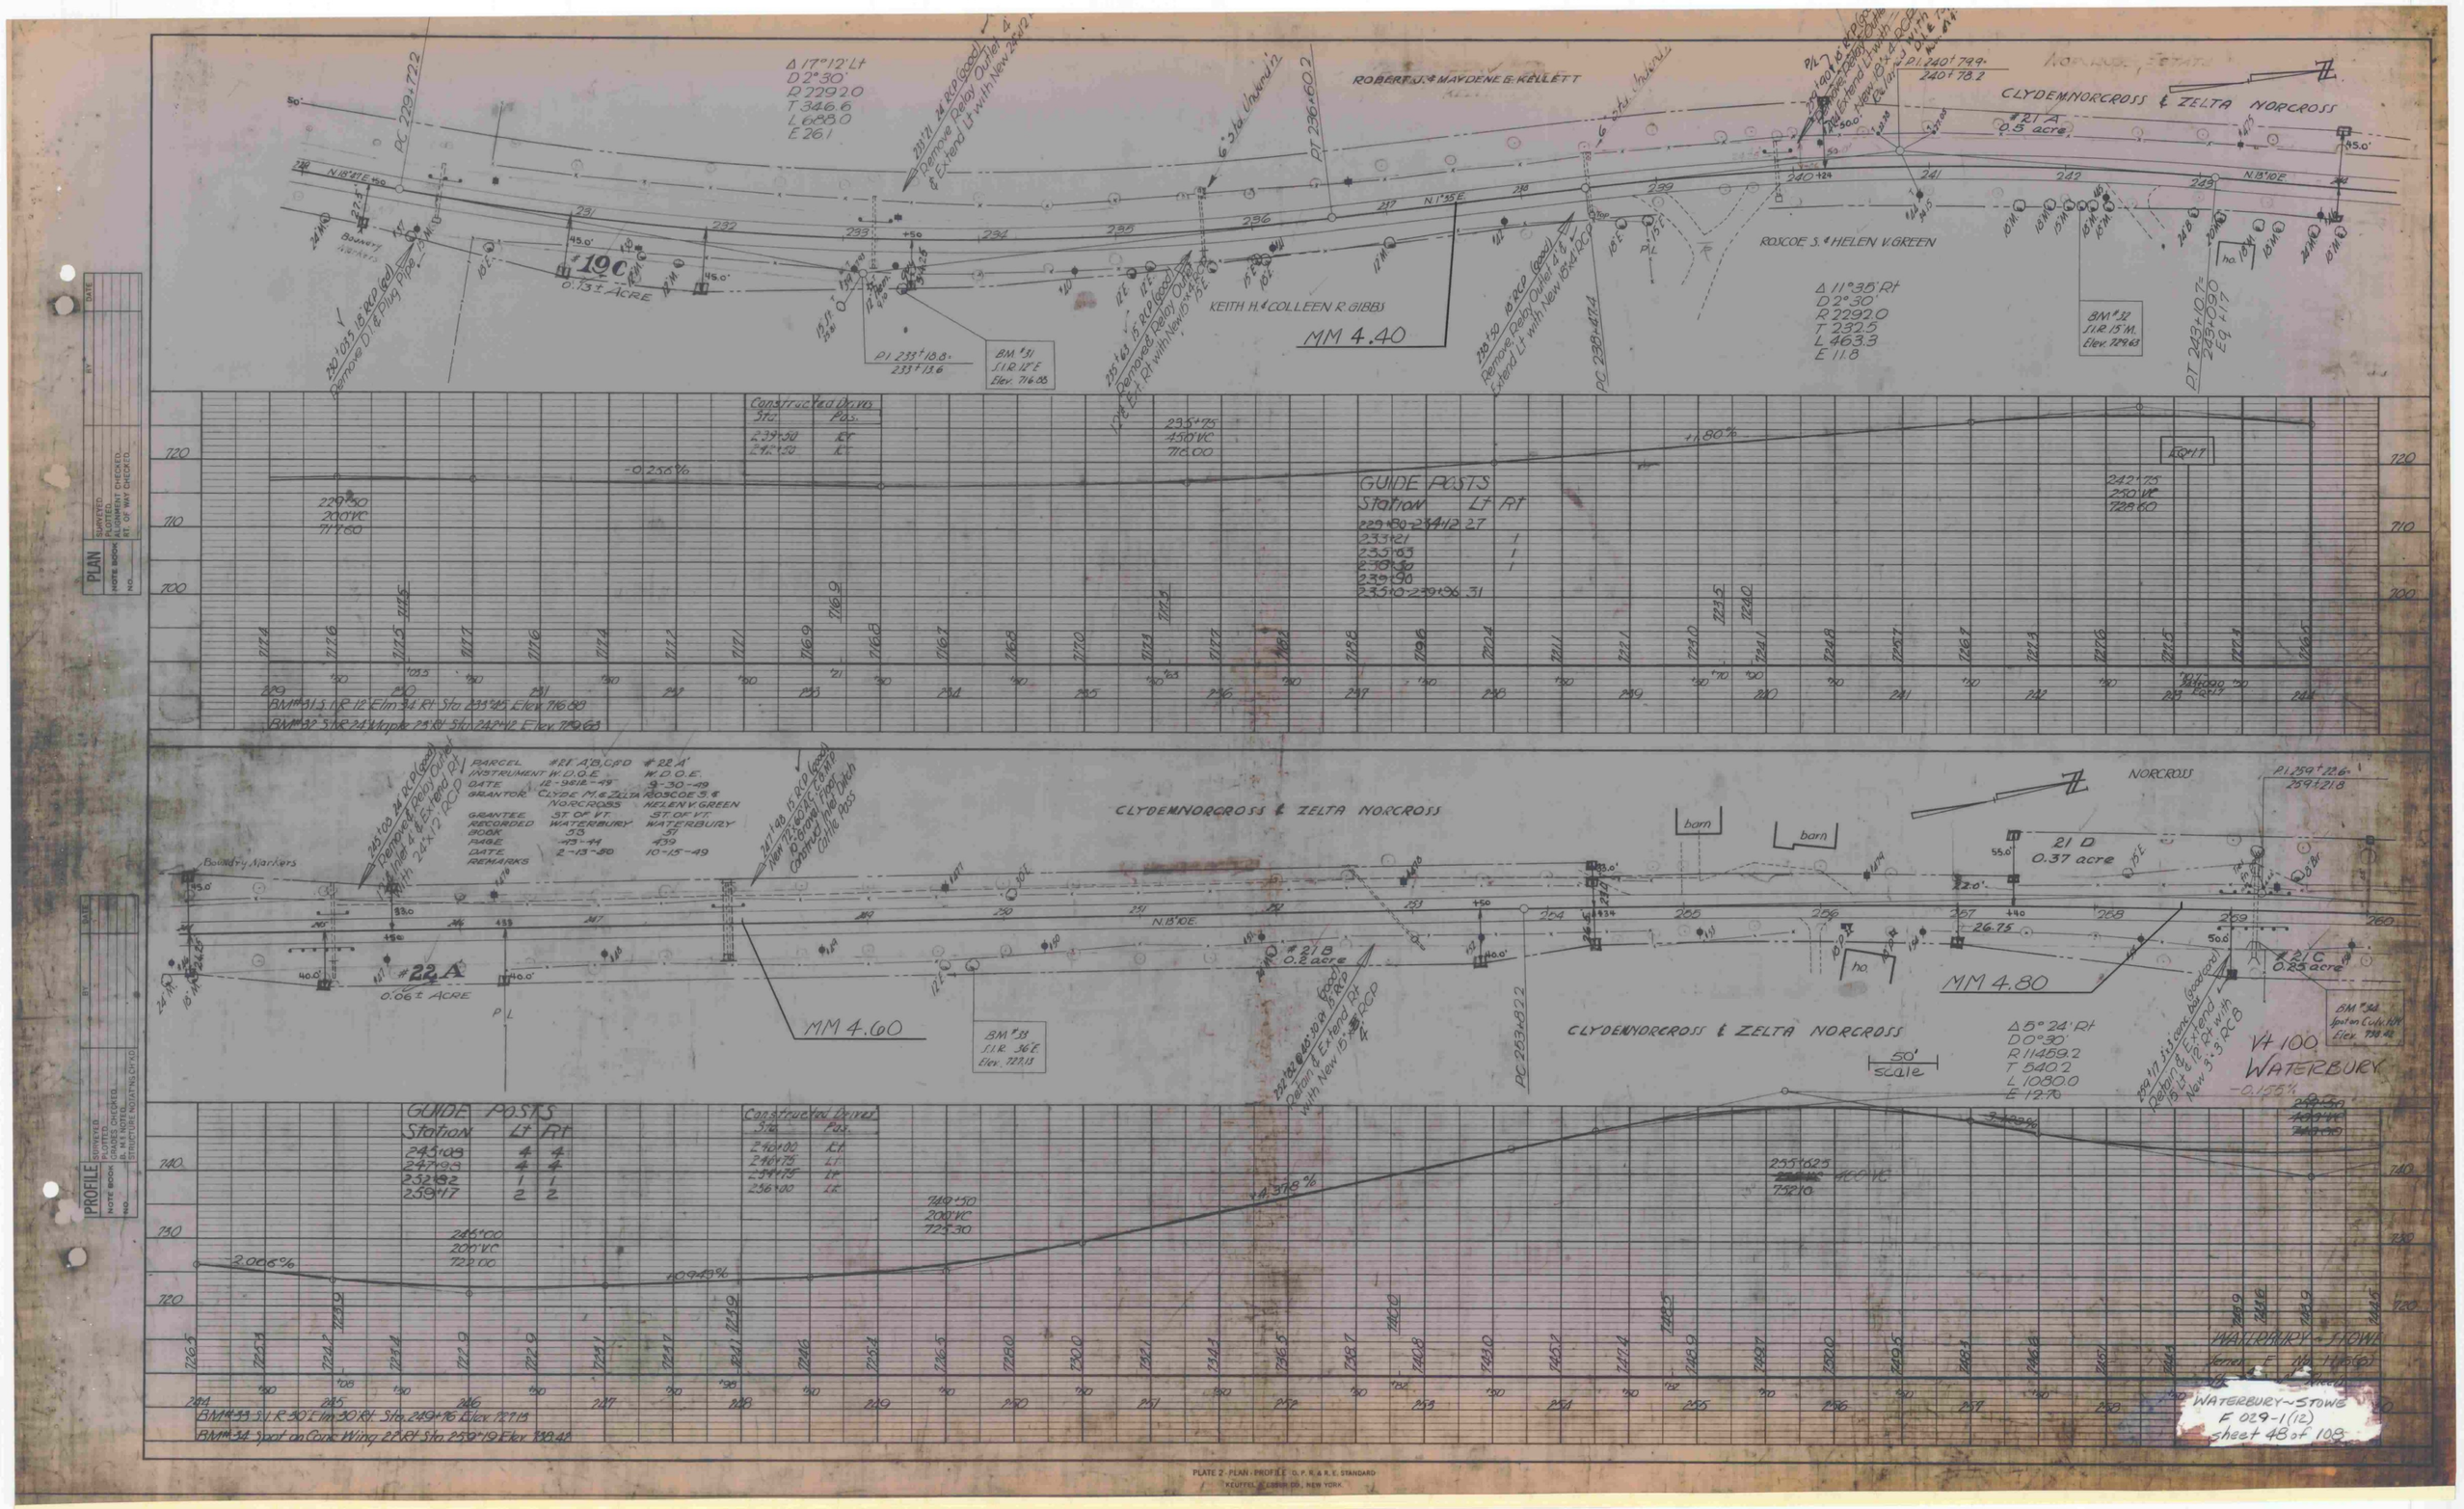
ROBERT J. & MAYDENE E. KELLETT
CLYDEM. NORCROSS & ZELTA NORCROSS
ROSCOE S. & HELEN V. GREEN
KEITH H. & COLLEEN R. GIBBS
MM 4.40
MM 4.60
MM 4.80
Δ 17°12' Lt
D 2°30'
R 2292.0
T 346.6
L 688.0
E 26.1
Δ 11°35' Rt
D 0°30'
R 2292.0
T 232.5
L 463.3
E 11.8
Δ 5°24' Rt
D 0°30'
R 11459.2
T 540.2
L 1080.0
E 12.8
PC 229+72.2
PT 236+60.2
PC 238+47.4
PC 253+82.2
P.I. 240+79.9
240+78.2
P.I. 233+18.8
233+13.6
P.I. 243+07.5
243+09.0
E.9+17
P.I. 259+22.6
259+21.8
#19C
0.73± ACRE
#21 A
0.5 acre
#21 D
0.37 acre
#21 B
0.2 acre
#21 C
0.23 acre
#22 A
0.06± ACRE
Remove D.I. & Plug Pipe
Remove Relay Outlet & Extend Lt with New 24x12 RCP
Remove Relay Outlet & Ext. Rt with New 15x12 RCP
Remove Relay Outlet & Extend Lt with New 15x12 RCP
Remove Relay Outlet & Extend Rt with New 24x12 RCP
Remove Relay Outlet & Extend Rt with New 24x12 RCP
Remove Relay Outlet & Extend Rt with New 15x12 RCP
Remove Relay Outlet & Extend Rt with New 15x12 RCP
Remove Relay Outlet & Extend Rt with New 15x12 RCP
New 72x40 RCB to Replace Existing Constricted Hot Ditch Culvert
Boundary Markers
barn
ho.
BM #31 S.I.R. 12'E Elev. 716.05
BM #32 S.I.R. 15'M. Elev. 729.63
BM #33 S.I.R. 36'E Elev. 727.13
BM #34 Spot on Conc. Wing Elev. 728.48
GUIDE POSTS
Station Lt Rt
229+50-234+12 27
233+21 1
235+63 1
239+50 1
239+90
235+10-239+96 31
PARCEL #21 A,B,C&D #22 A
INSTRUMENT W.D.O.E. W.D.O.E.
DATE 12-9&12-49 9-30-49
GRANTOR CLYDE M. & ZELTA NORCROSS ROSCOE S. & HELEN V. GREEN
GRANTEE ST. OF VT. ST. OF VT.
RECORDED BOOK WATERBURY 55 WATERBURY 57
PAGE 43-44 439
DATE 2-13-50 10-15-49
REMARKS
GUIDE POSTS
Station Lt Rt
243+09 4 4
247+99 4 4
252+92 1 1
259+17 2 2
Constructed Drives
Sta. Pos.
240+00 Lt
240+75 Lt
244+75 Lt
256+00 Lt
BM #29 5 I.R. 30' Elm 30' Rt. Sta. 229+16 Elev. 729.18
BM #34 Spot on Conc. Wing 23' Rt. Sta. 259+19 Elev. 728.48
WATERBURY-STOWE
F 029-1(12)
sheet 48 of 108
PLAN
PROFILE
SURVEYED
PLOTTED
GRADES CHECKED
STRUCTURE NO. & TYPE CHKD.
ALIGNMENT CHECKED
RT. OF WAY CHECKED
NOTE BOOK
NO.
DATE
BY
PLATE 2 - PLAN - PROFILE O.P.R. & R.E. STANDARD
KEUFFEL & ESSER CO., NEW YORK