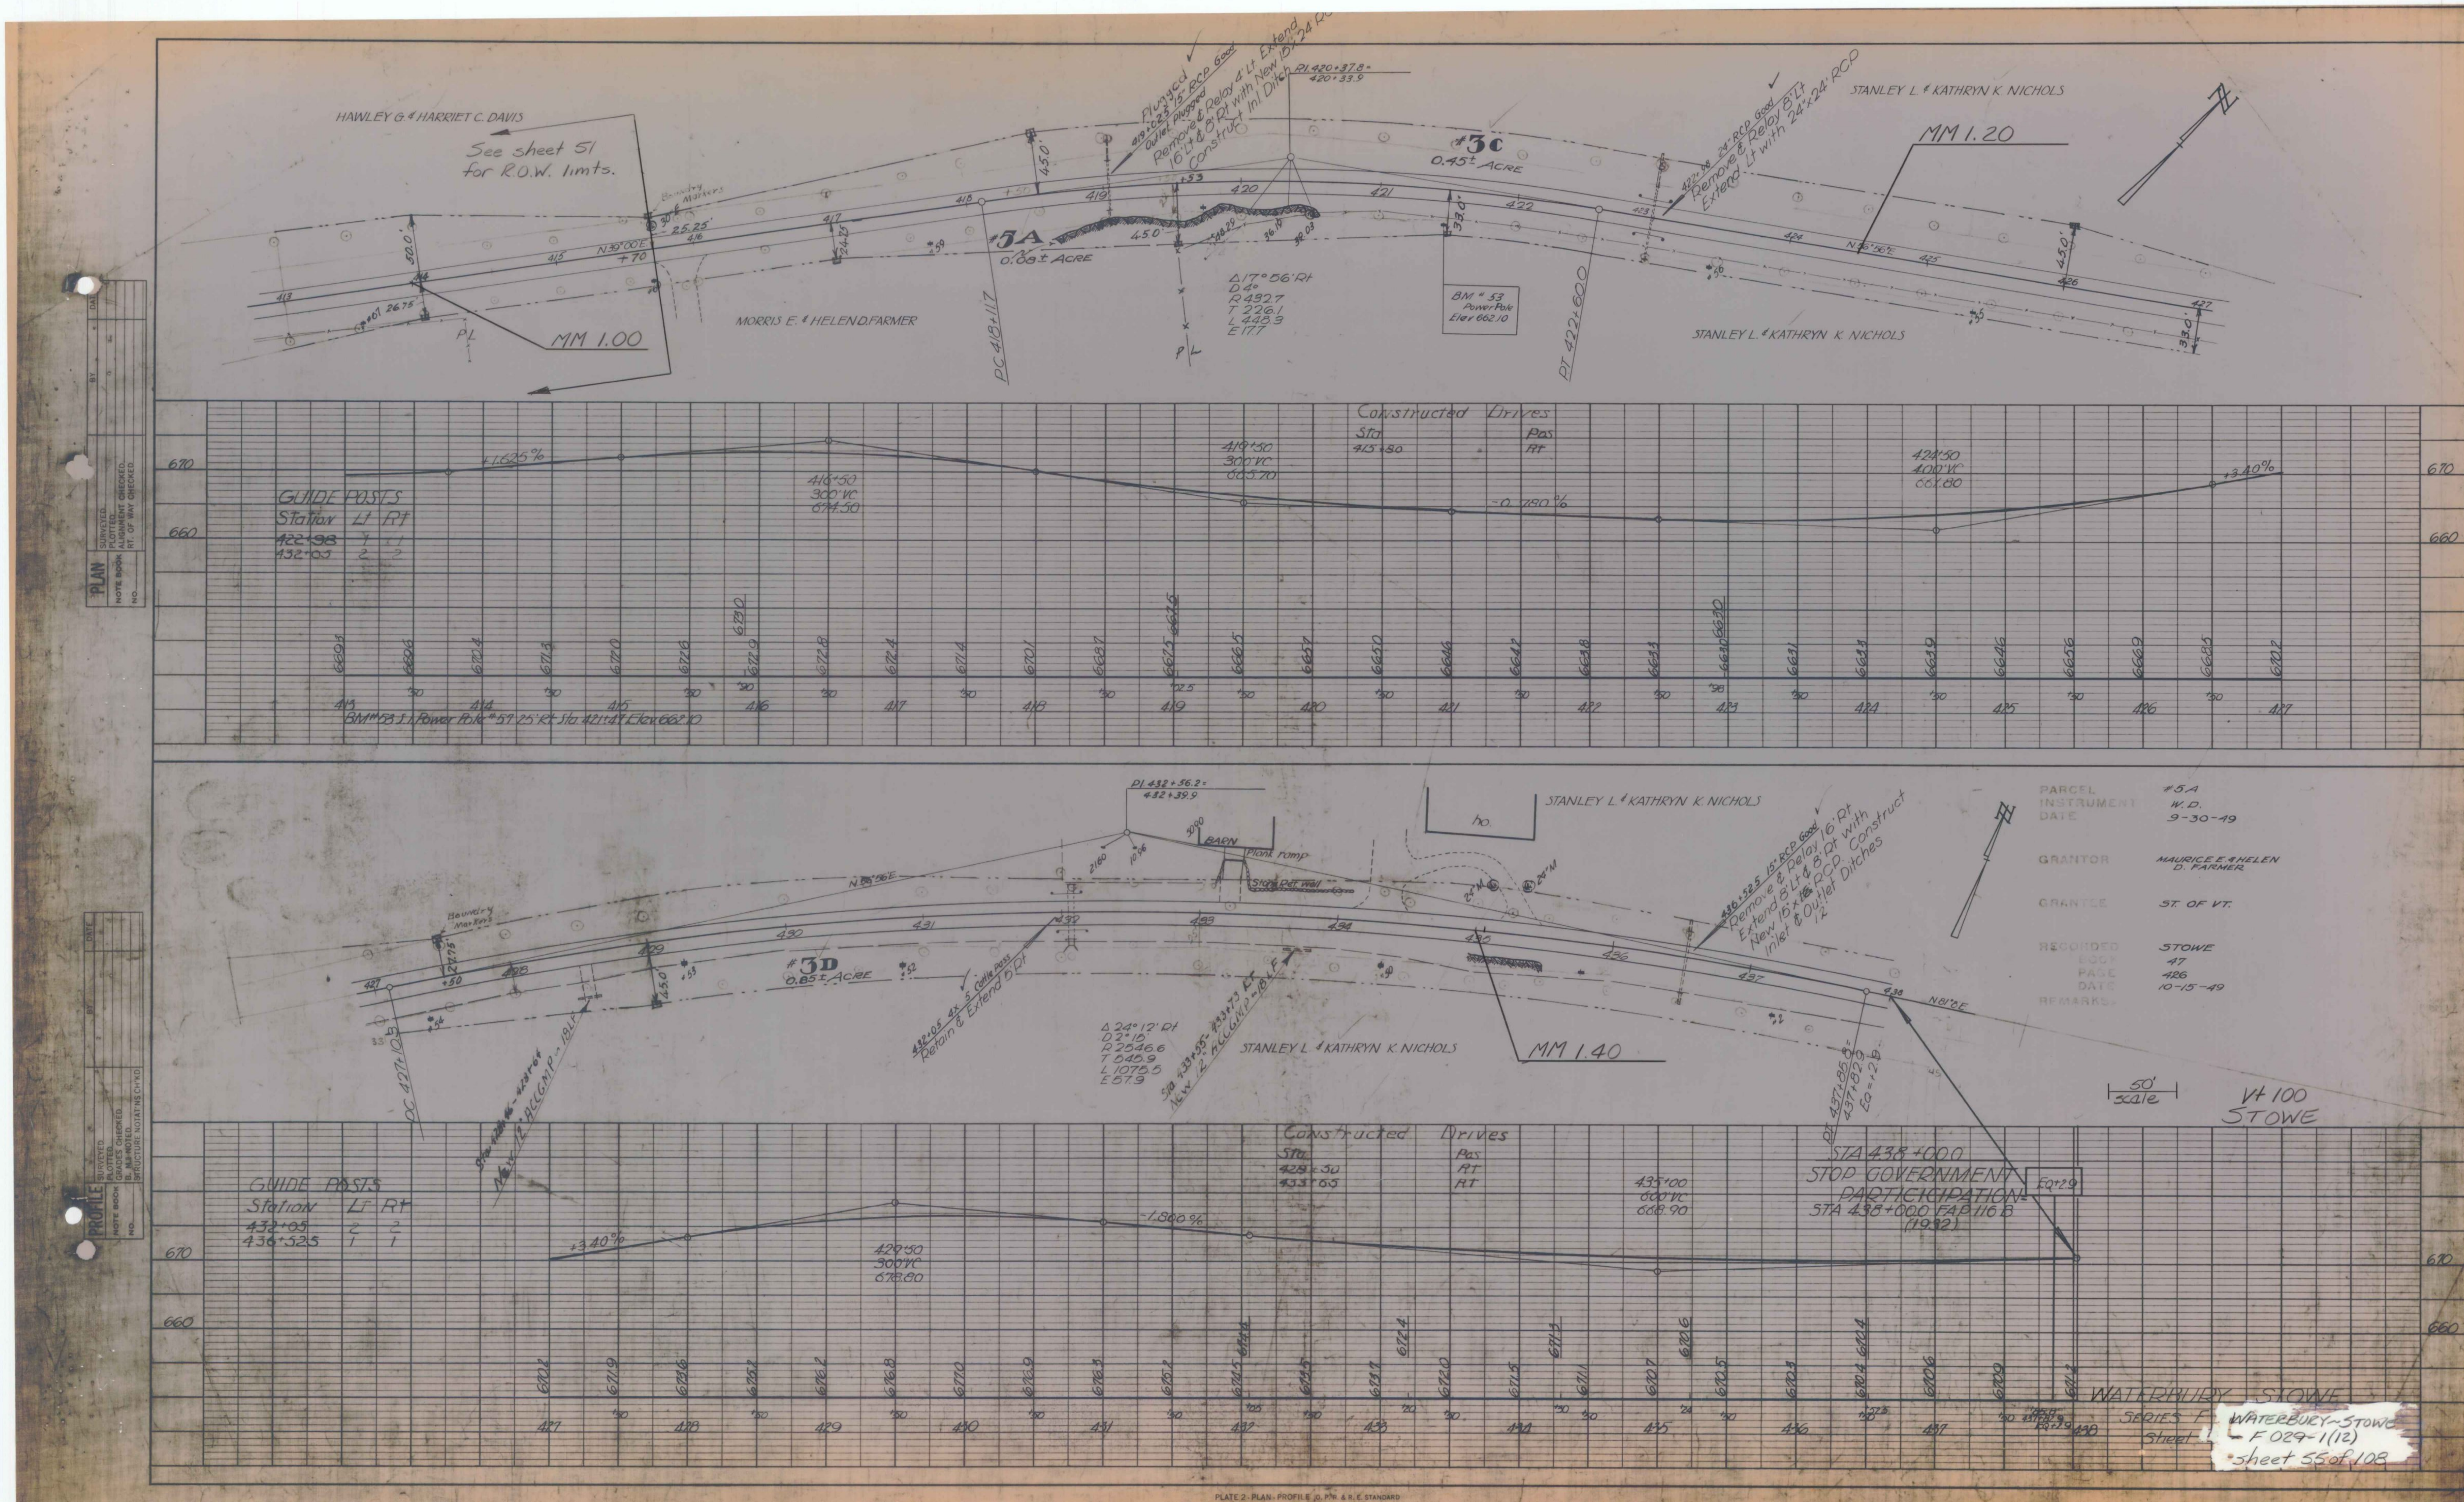

HAWLEY G. & HARRIET C. DAVIS
See sheet 51 for R.O.W. limts.
STANLEY L. & KATHRYN K. NICHOLS
MM 1.20
#3C
0.45± ACRE
#5A
0.08± ACRE
MORRIS E. & HELEN D. FARMER
MM 1.00
Δ 17°56' Rt
D 4°
R 1432.7
T 226.1
L 448.3
E 17.7
BM # 53
Power Pole
Elev 662.10
STANLEY L. & KATHRYN K. NICHOLS
PC 418+11.7
PT 422+60.0
Constructed Drives
GUIDE POSTS
Station Lt Rt
416+50
300' VC
674.50
419+50
300' VC
665.70
424+50
400' VC
661.80
STANLEY L. & KATHRYN K. NICHOLS
PARCEL #5A
INSTRUMENT W. D.
DATE 9-30-49
GRANTOR MAURICE E. & HELEN D. FARMER
GRANTEE ST. OF VT.
RECORDED STOWE
BOOK 47
PAGE 426
DATE 10-15-49
REMARKS
#3D
0.85± ACRE
Δ 24°12' Rt
D 2°10
R 2546.6
T 546.9
L 1075.5
E 57.9
STANLEY L. & KATHRYN K. NICHOLS
MM 1.40
50' scale
VT 100
STOWE
Constructed Drives
GUIDE POSTS
Station Lt Rt
429+50
300' VC
678.80
435+00
600' VC
668.90
STA 438+00.0
STOP GOVERNMENT PARTICIPATION
STA 438+00.0 FAP 116 B (1932)
WATERBURY - STOWE
WATERBURY-STOWE
F 029-1(12)
sheet 55 of 108
PLATE 2 - PLAN - PROFILE
KEUFFEL & ESSER CO., NEW YORK