


DATE  
BY  
PLW  
CHECKED  
PLOTTER  
NOTE BOOK  
NO.

PROFILE  
DATE  
BY  
NOTE BOOK  
NO.

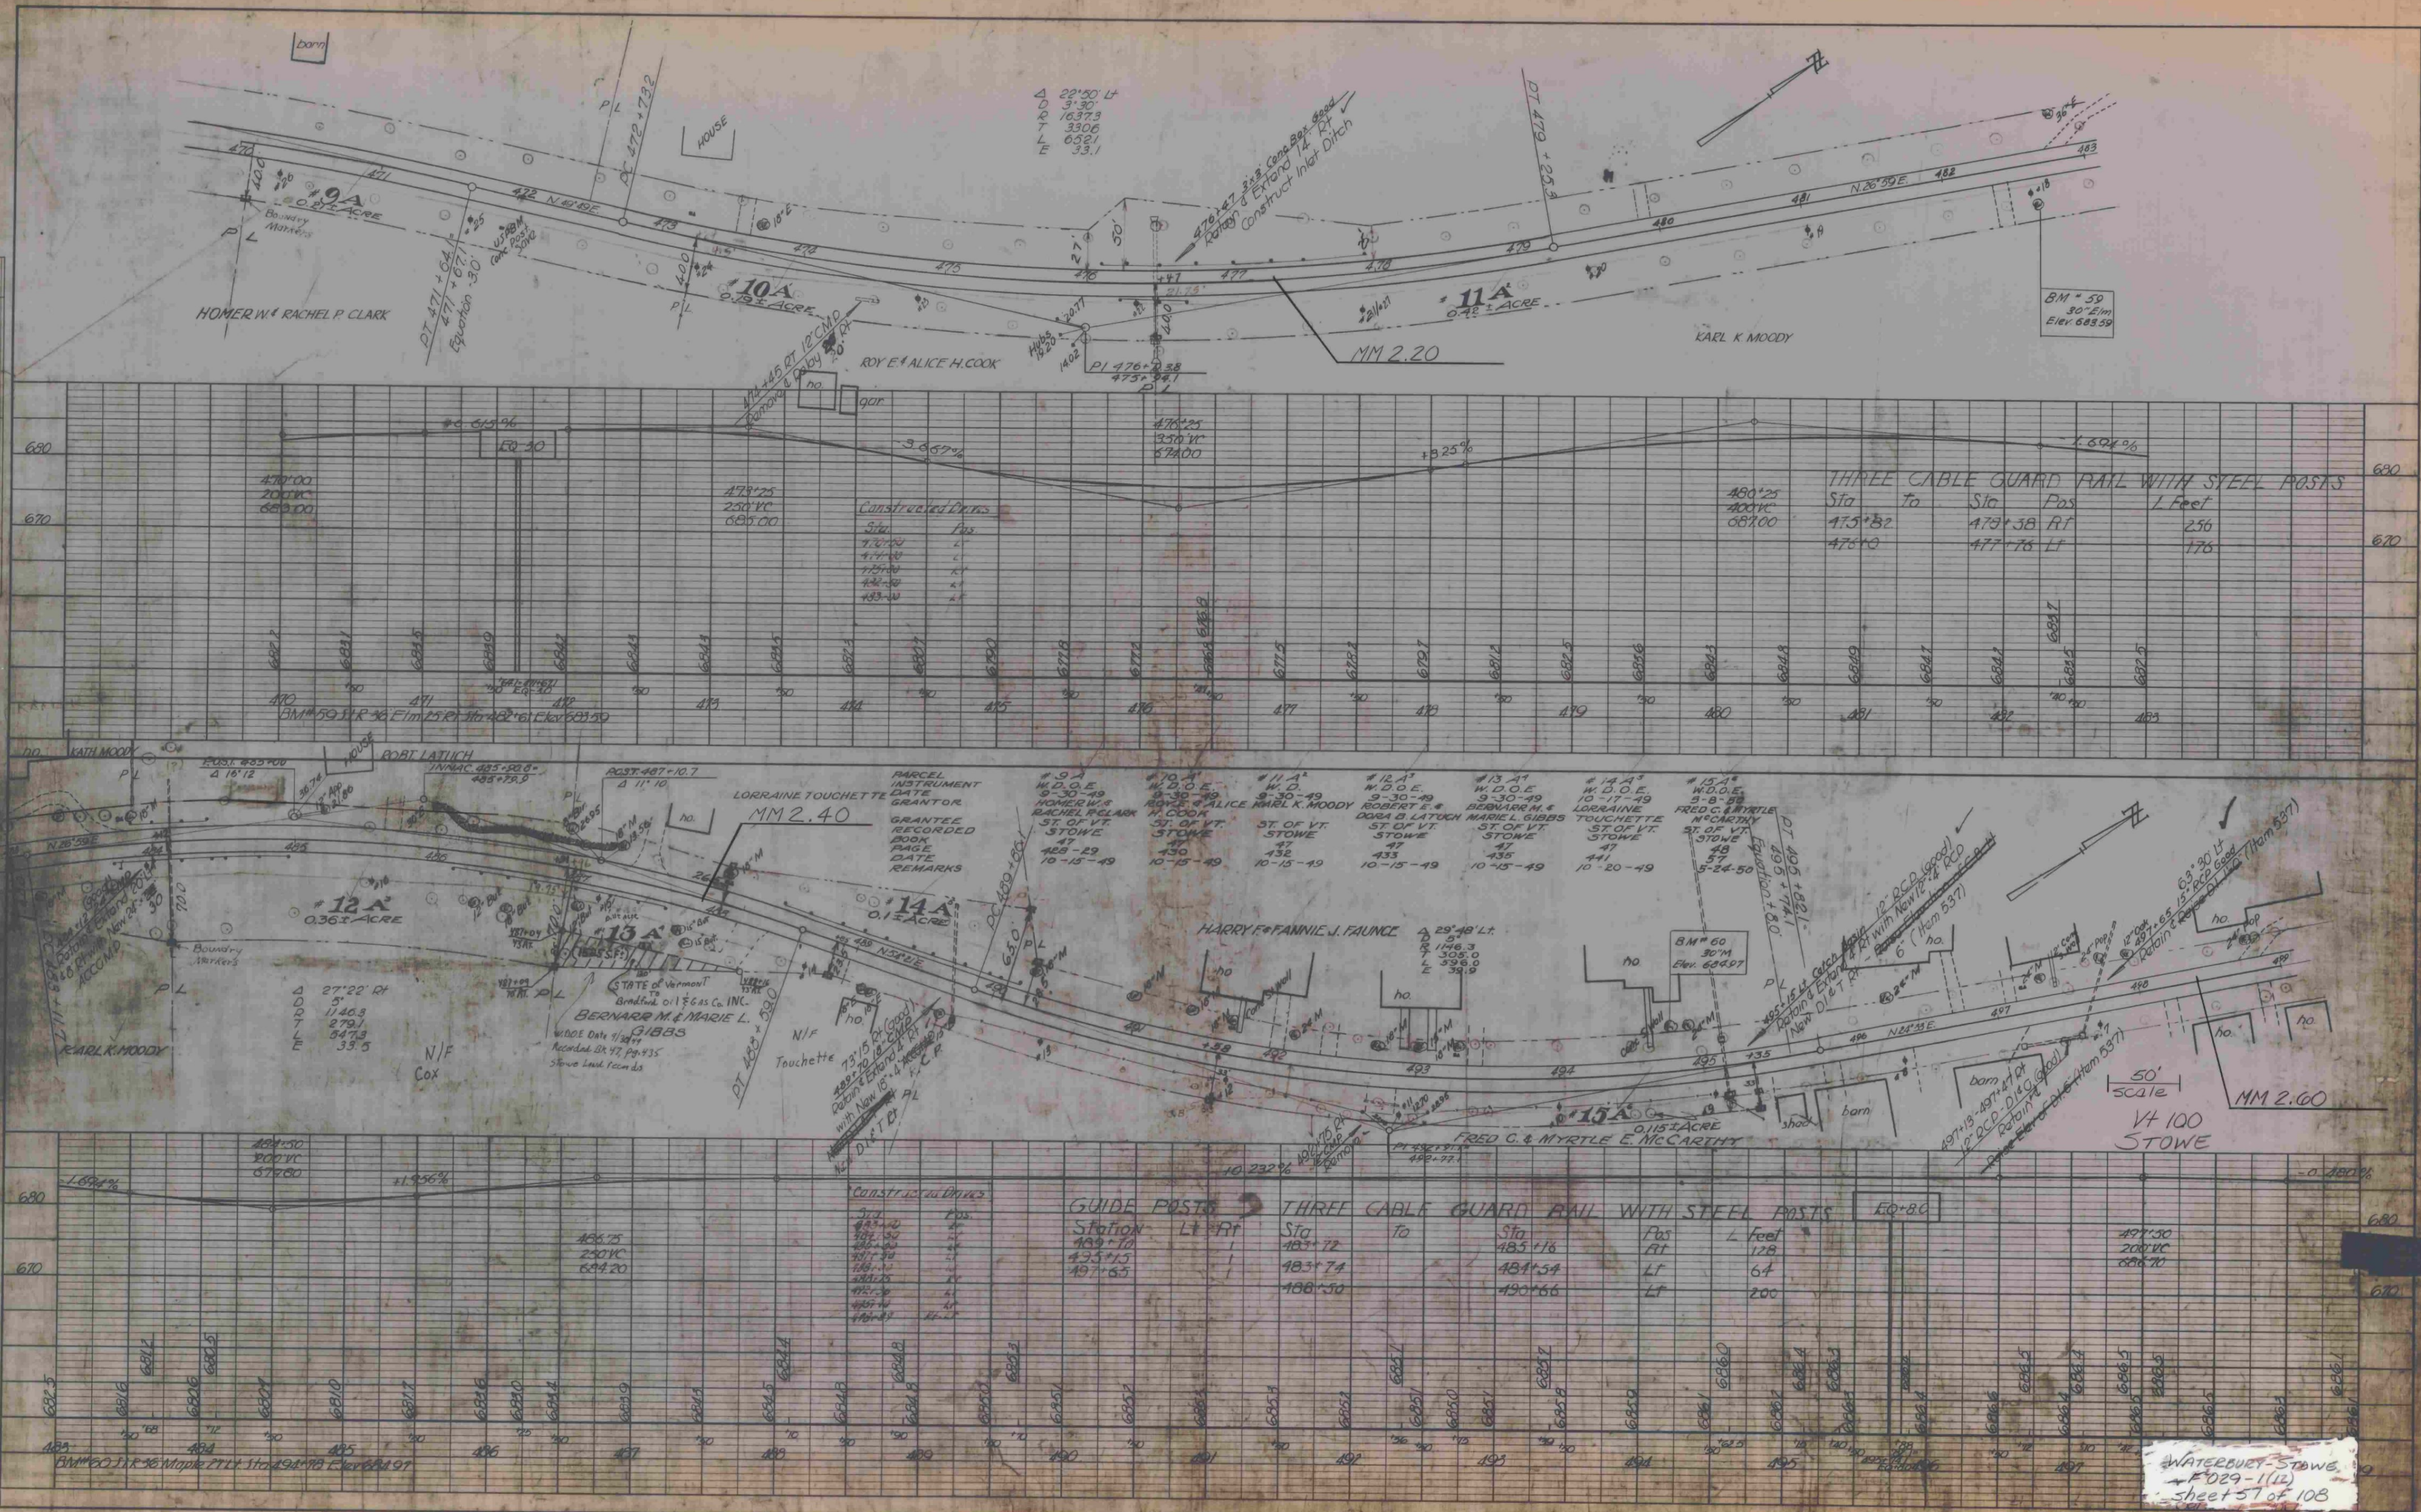

Constructed Ditches

| Sta    | Flow |
|--------|------|
| 478+00 | L    |

GUIDE POSTS

| Station | LT | RT |
|---------|----|----|
| 478+70  |    |    |

THREE CABLE GUARD RAIL WITH STEEL POSTS

| Sta    | To | Sta    | To | Pos | L Feet |
|--------|----|--------|----|-----|--------|

EQ+80


WATERBURY STONE  
F029-1(12)  
Sheet 57 of 108  
