FED. ROAD DIST. NO.	STATE	FED. AID PROJ. NO.	FISCAL YEAR	SHEET NO.	TOTAL SHEETS
1	VT	BRA (2)	1941	13	169

PARCEL	INSTRUMENT	DATE	GRANTOR	GRANTEE	RECORDED BOOK	RECORDED PAGE	RECORDED DATE	REMARKS
				WOLCOTT				
C B	W.D.O.E	4-7-41	W.C. & F.N. REED	ST OF VT.	27	347-2-3	4-28-41	
D.E.	W.D.O.E	3-3-41	C.F. & EVELYN REED	ST OF VT	27	274-5-6-7	3-12-41	

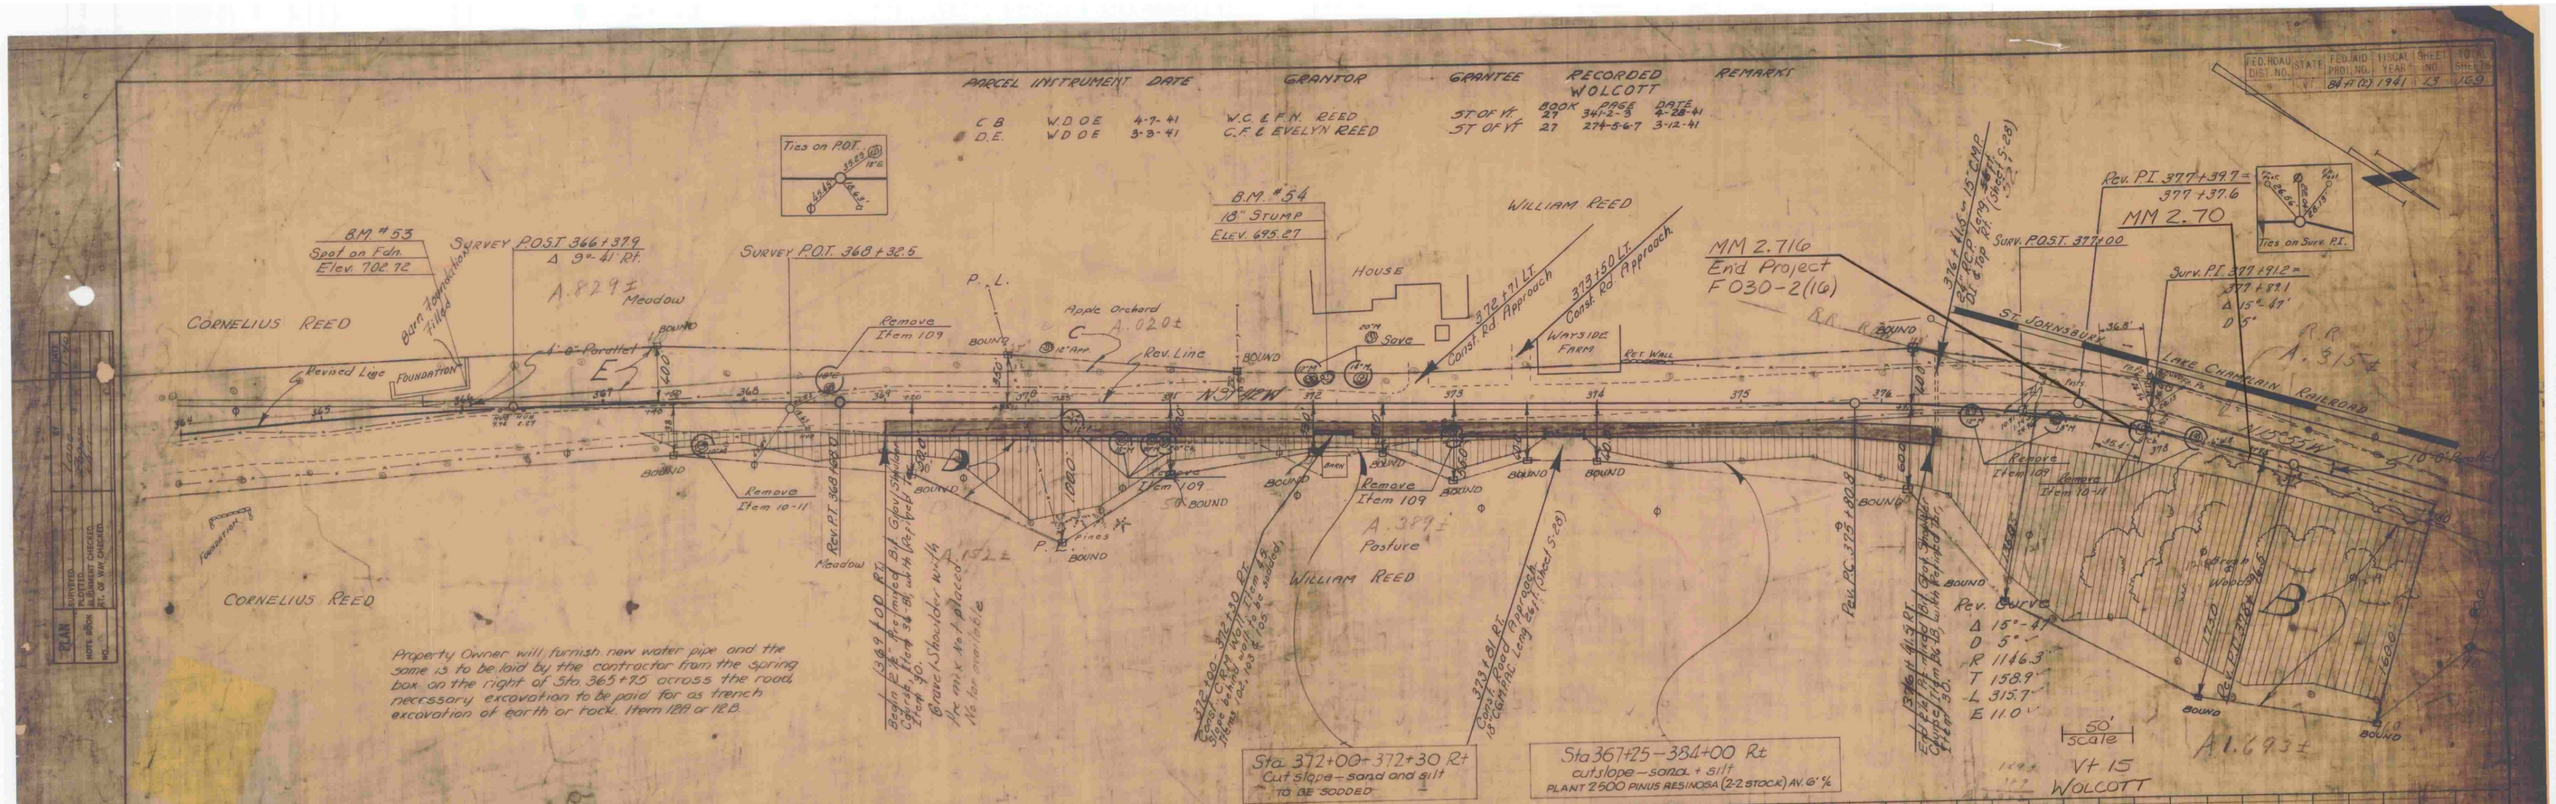

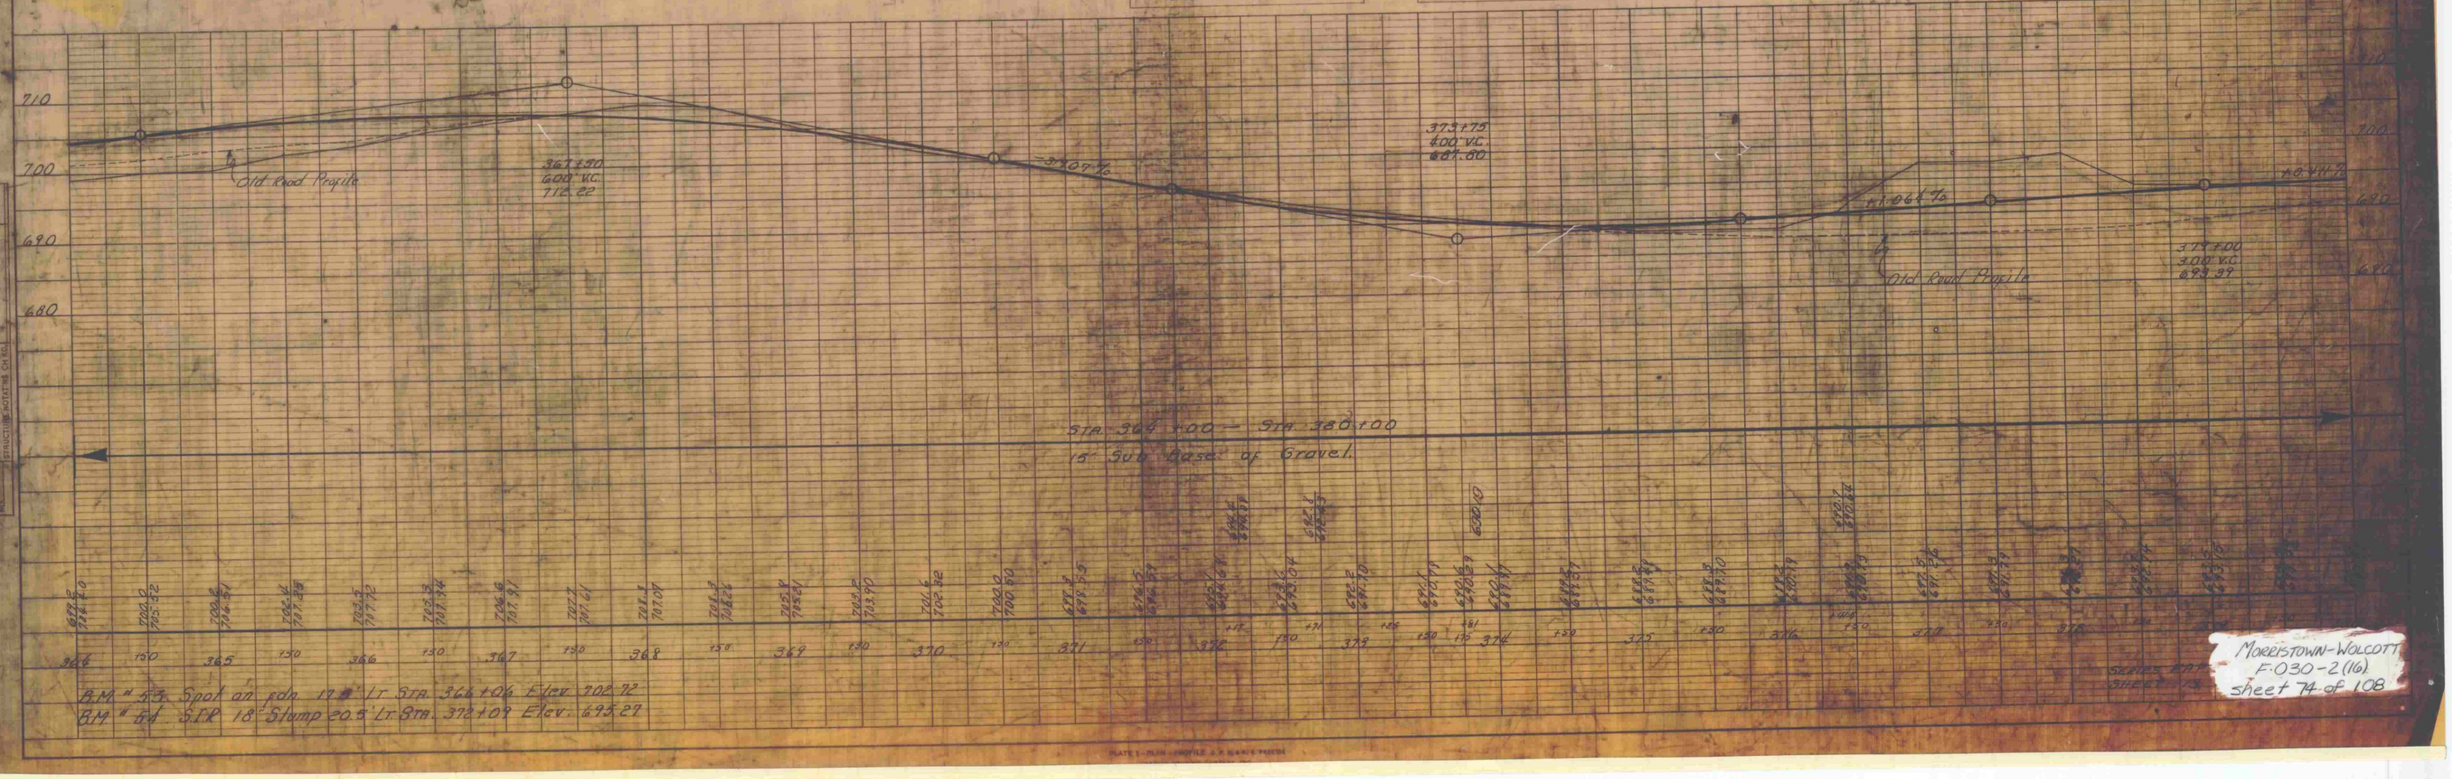

MORRISTOWN-WOLCOTT
F-030-2(16)
sheet 74 of 108