TOWNS OF GUILFORD-SPRINGFIELD

Pin # 87A028

Project IR 091-1(18) 4/1

Route I91
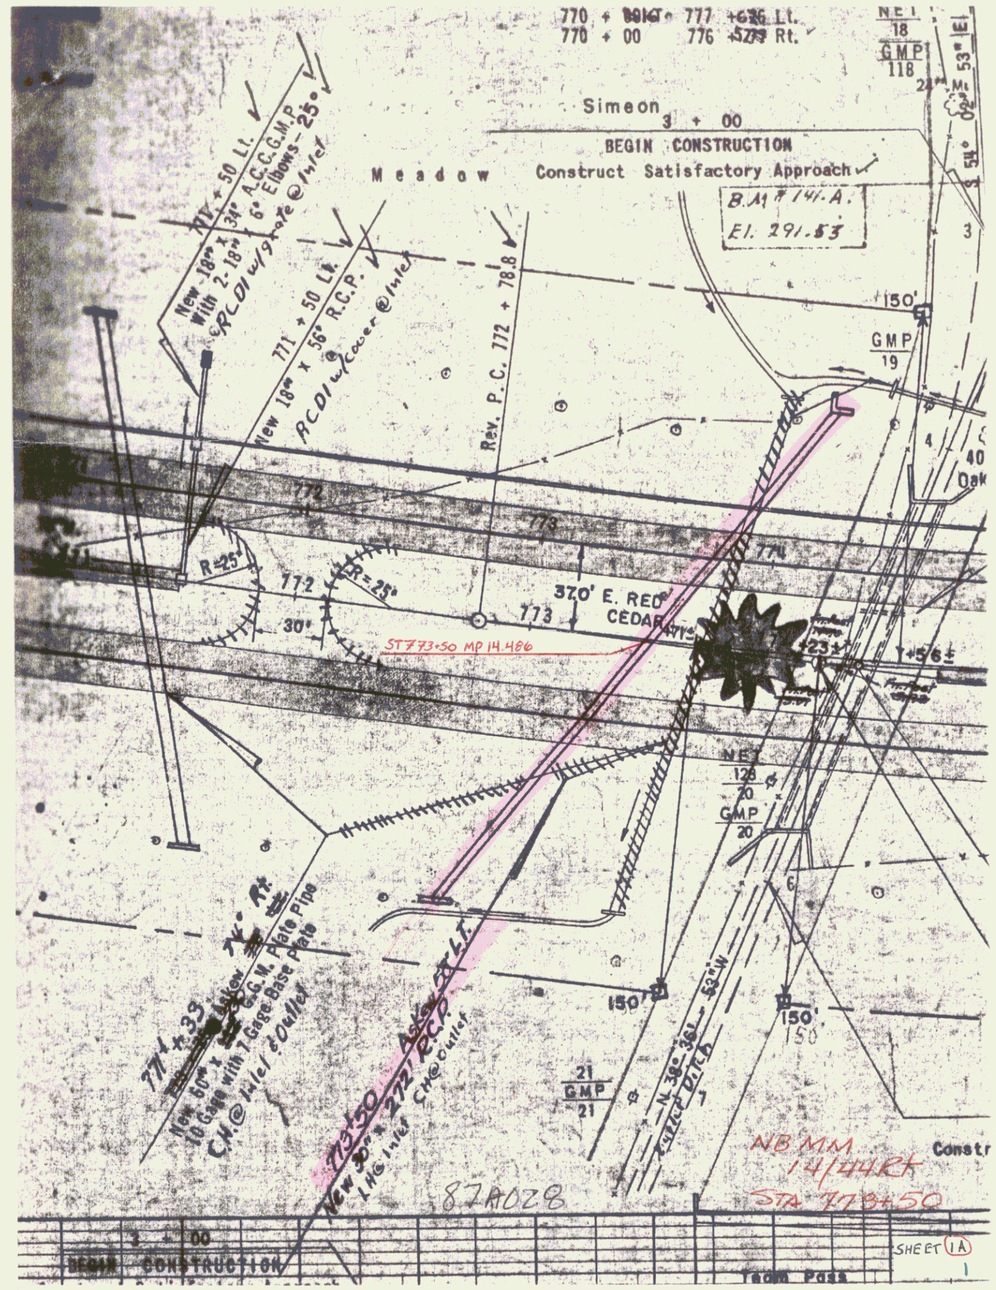
Date 9/4/2004