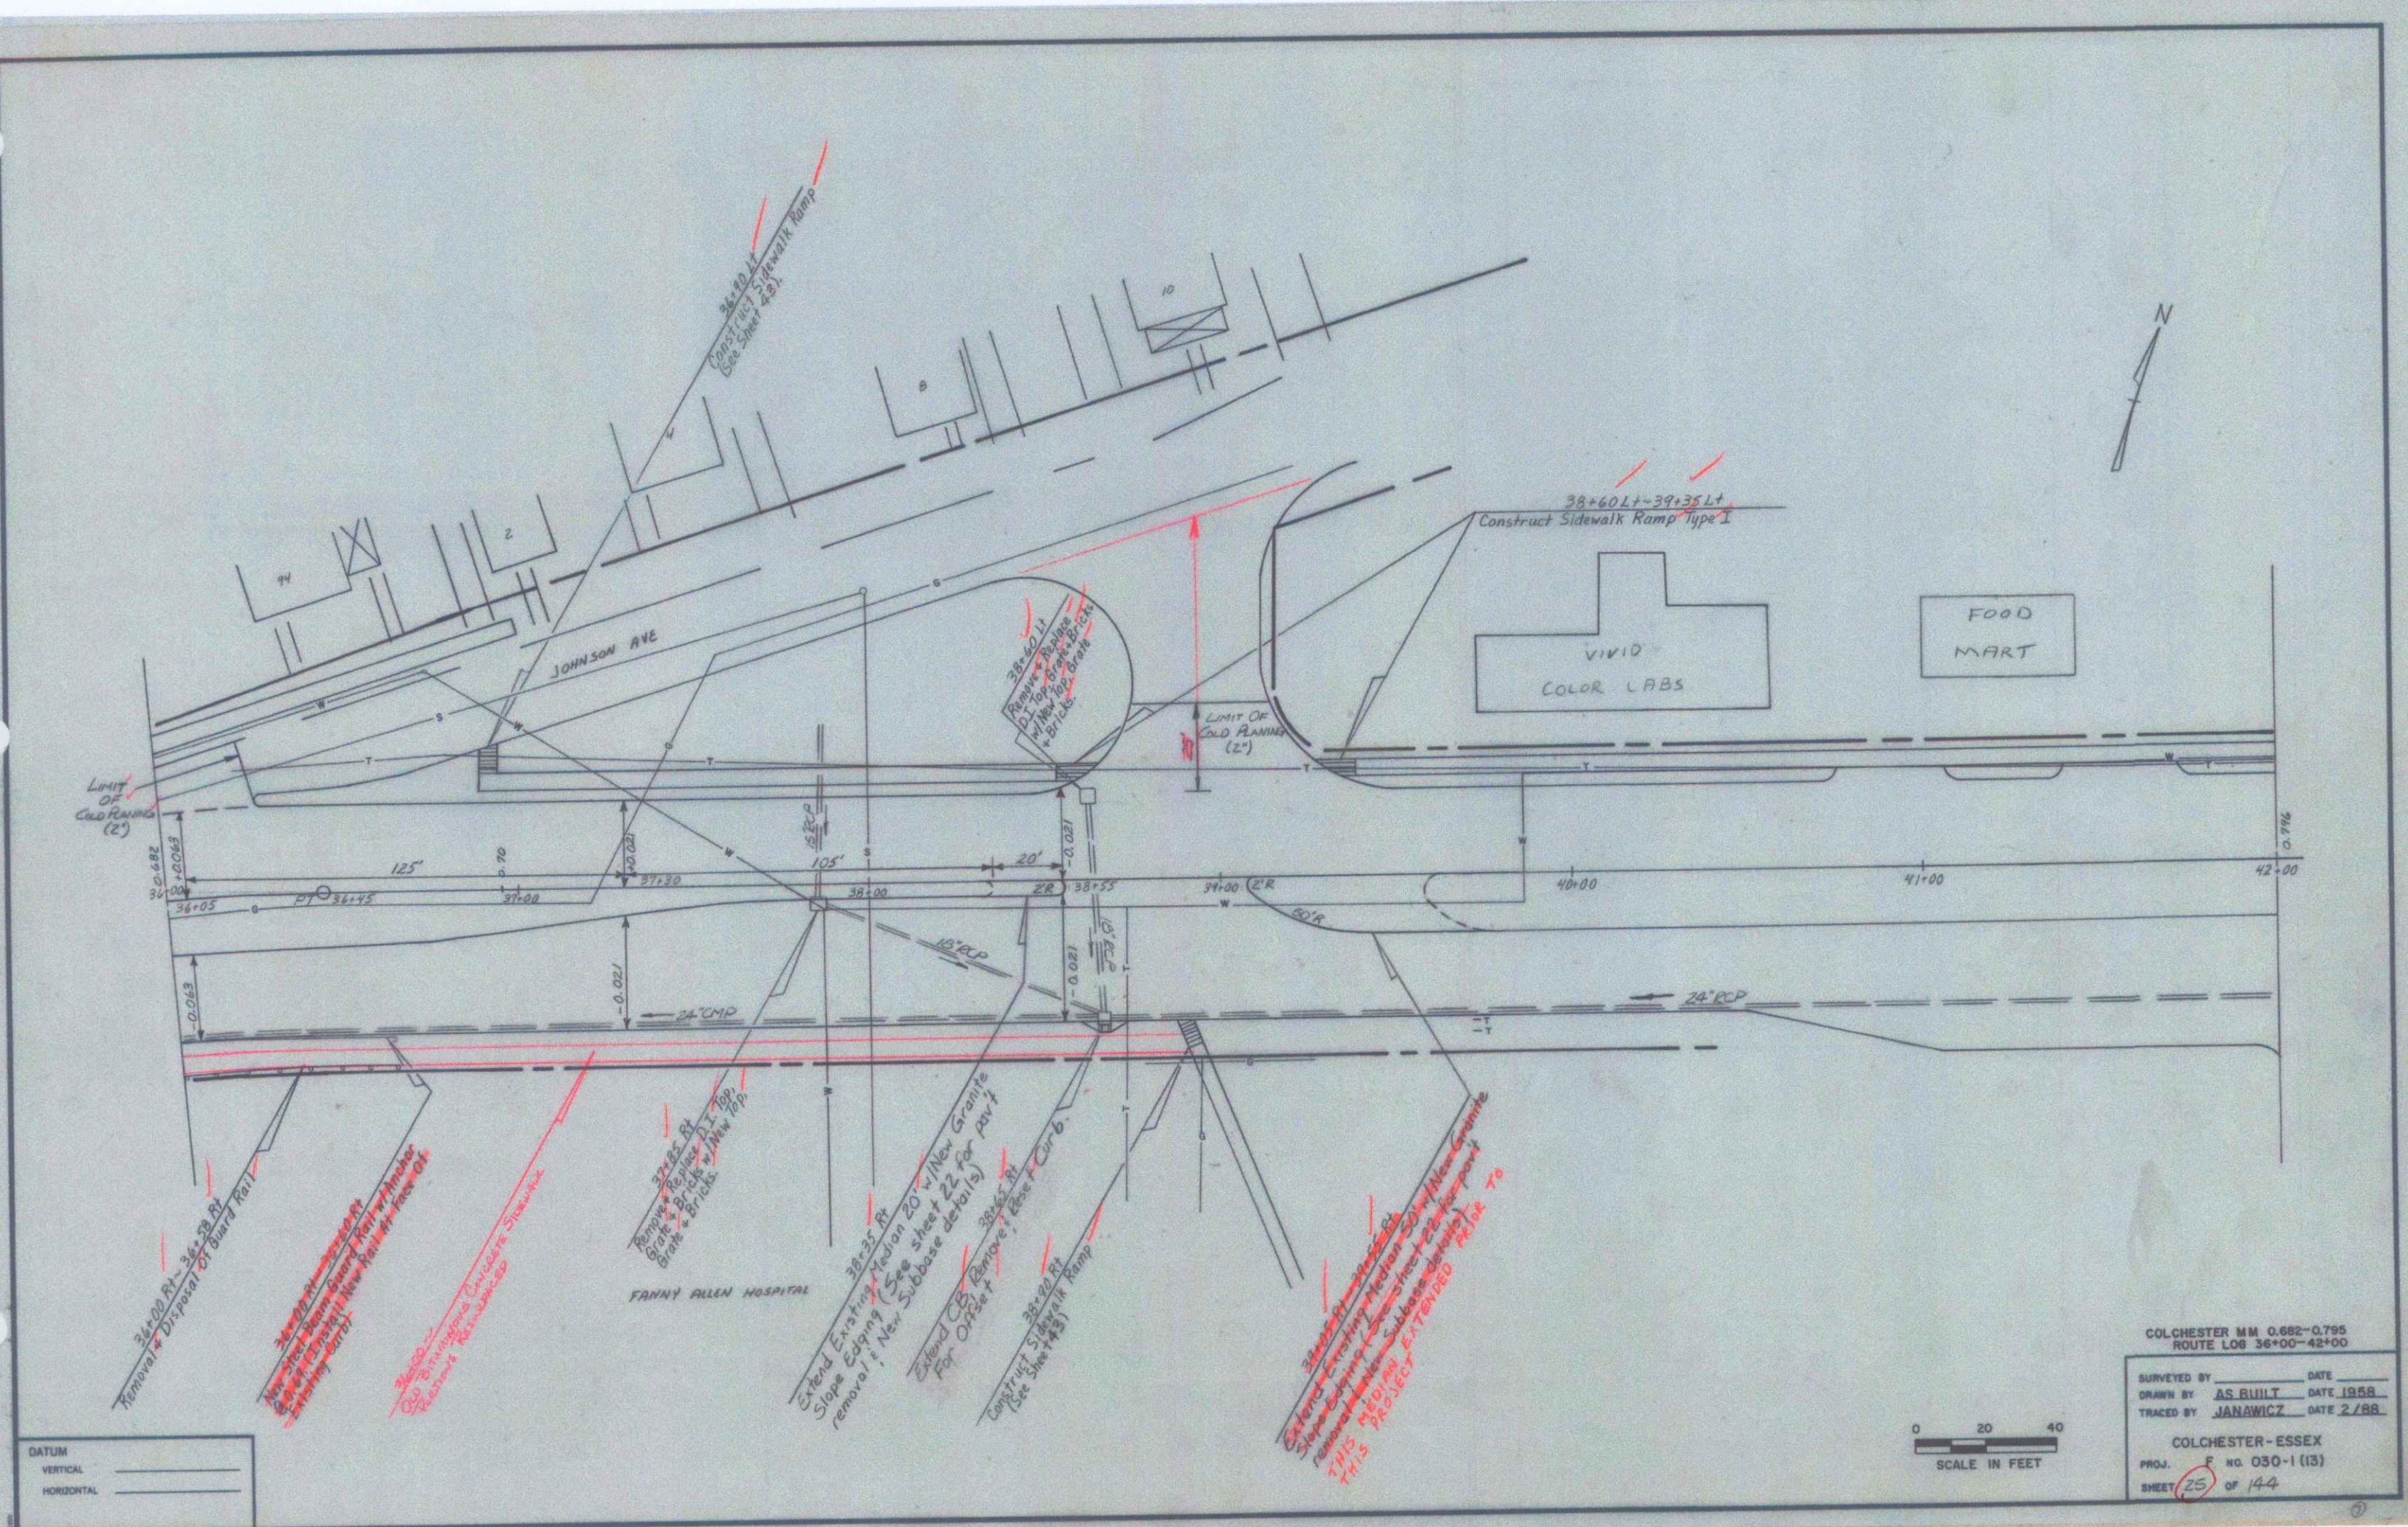


COLCHESTER MM 0.682-0.795
ROUTE LOS 36+00-42+00

SURVEYED BY	DATE
DRAWN BY AS BUILT	DATE 1958
TRACED BY JANAWICZ	DATE 2/88

COLCHESTER-ESSEX
PROJ. F NO 030-1 (13)
SHEET 25 OF 144