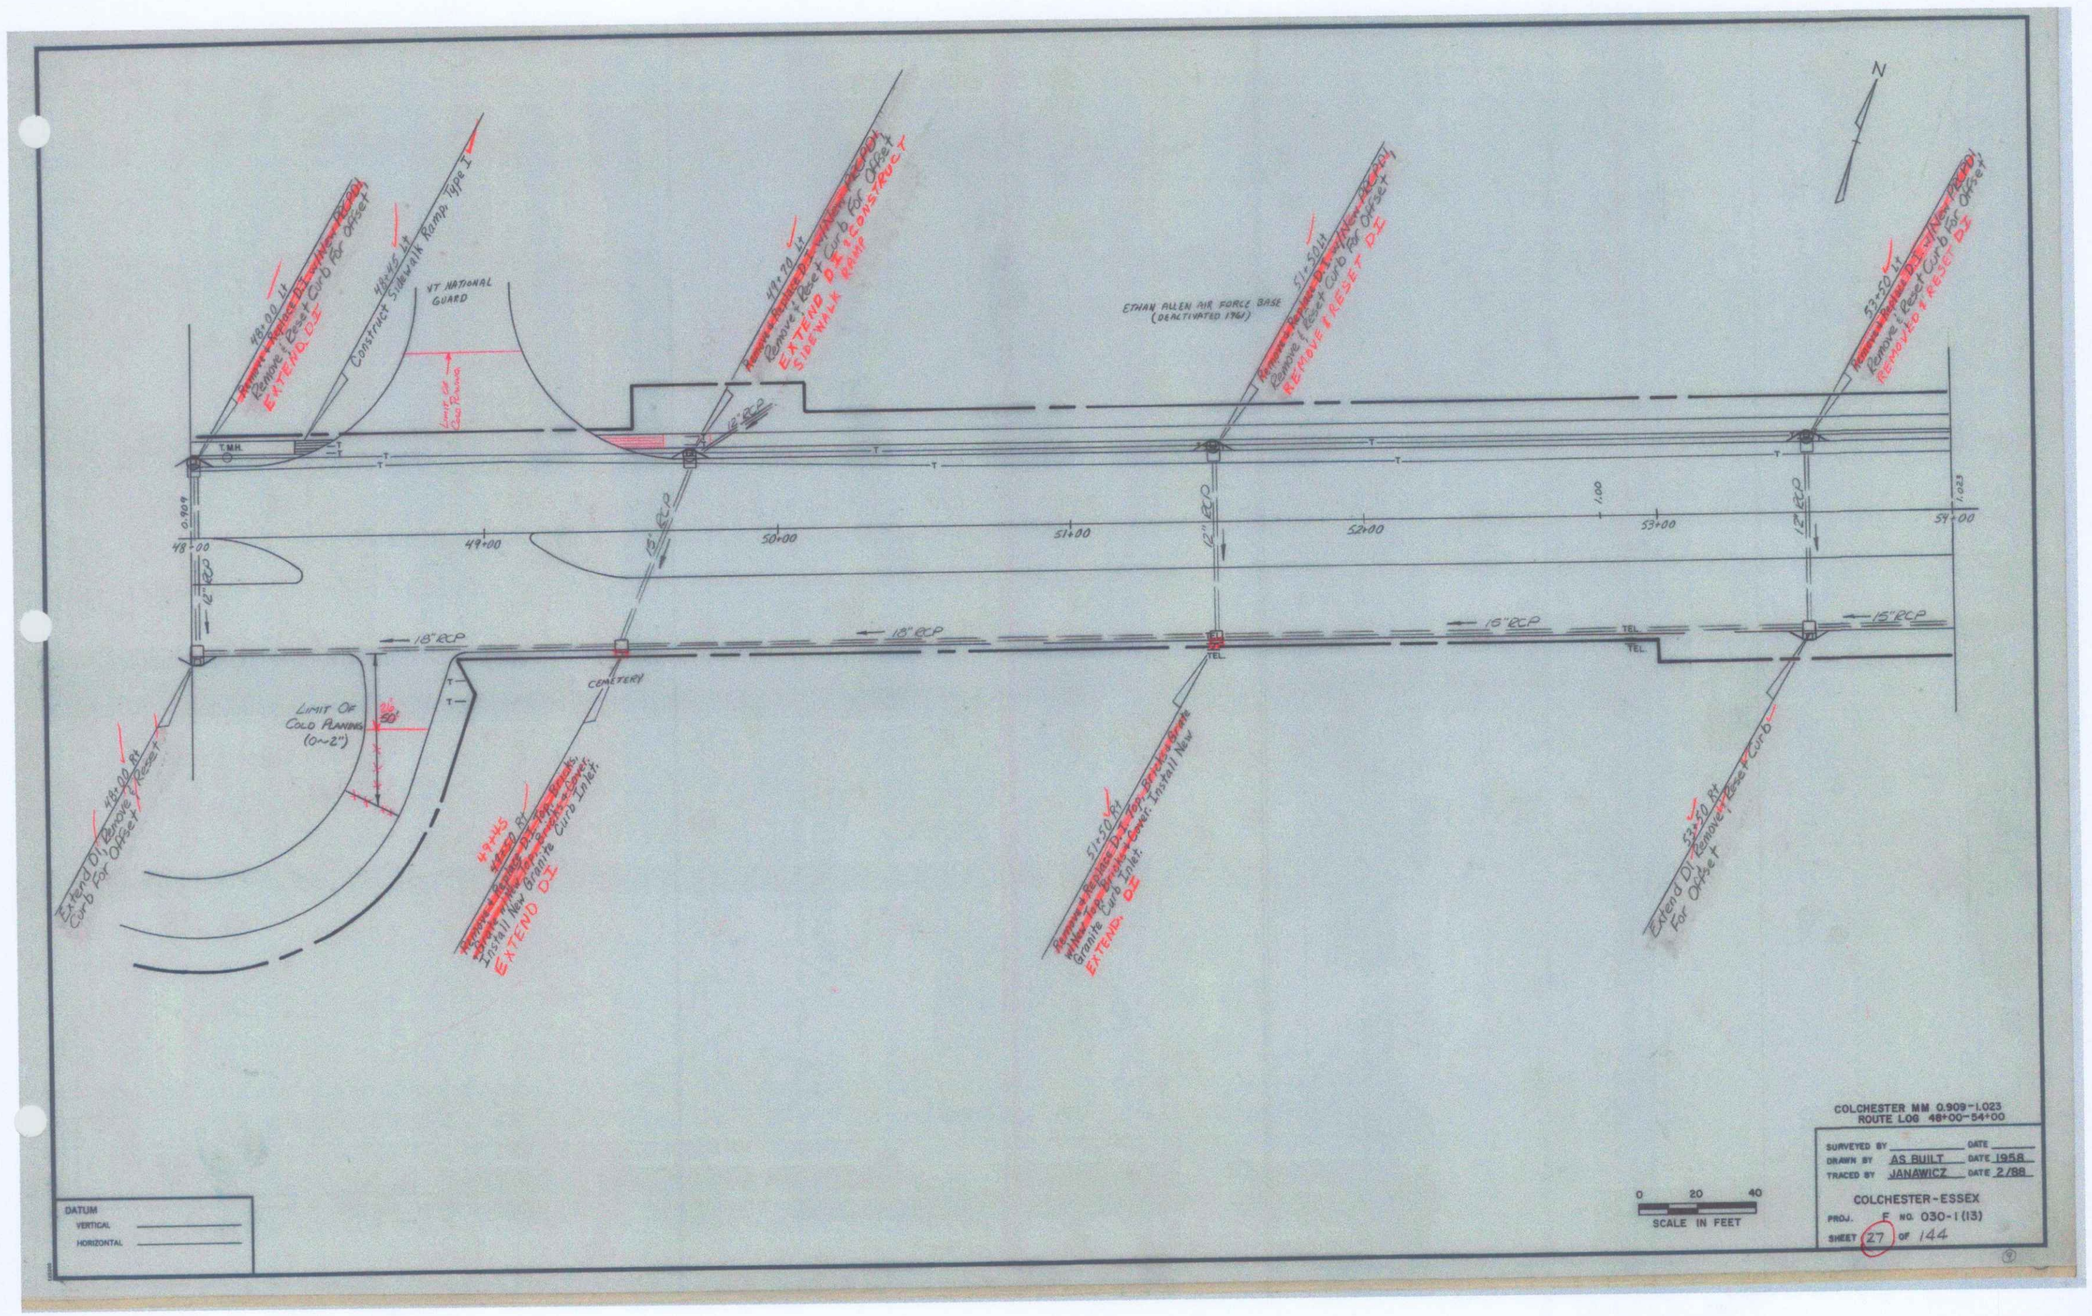
N
VT NATIONAL GUARD
ETHAN ALLEN AIR FORCE BASE (DEACTIVATED 1961)
Construct Sidewalk Ramp Type I
EXTEND DI & CONSTRUCT SIDEWALK RAMP
REMOVE & RESET DI
EXTEND DI
Remove & Reset Curb for Offset
Extend DI Remove & Reset Curb For Offset
Extend DI Remove Curb For Offset
Limit Of Cold Planing
T.M.H.
48+00
49+00
50+00
51+00
52+00
53+00
54+00
0.909
1.00
1.023
18" RCP
16" RCP
15" RCP
12" RCP
TEL.
CEMETERY
LIMIT OF COLD PLANING (0~2")
Install New Granite Curb Inlet
EXTEND DI
Granite Curb Inlet
DATUM
VERTICAL
HORIZONTAL
0 20 40
SCALE IN FEET
COLCHESTER MM 0.909-1.023
ROUTE LOG 48+00-54+00
SURVEYED BY
DATE
DRAWN BY AS BUILT
DATE 1958
TRACED BY JANAWICZ
DATE 2/88
COLCHESTER-ESSEX
PROJ. F NO. 030-1(13)
SHEET 27 OF 144

11