Keuffel & Esser Company PLATE 3, CROSS SECTION 48 7055 Made in U.S.A.

BRANDON 1443(22)

STRUCTURE SHEET # 1

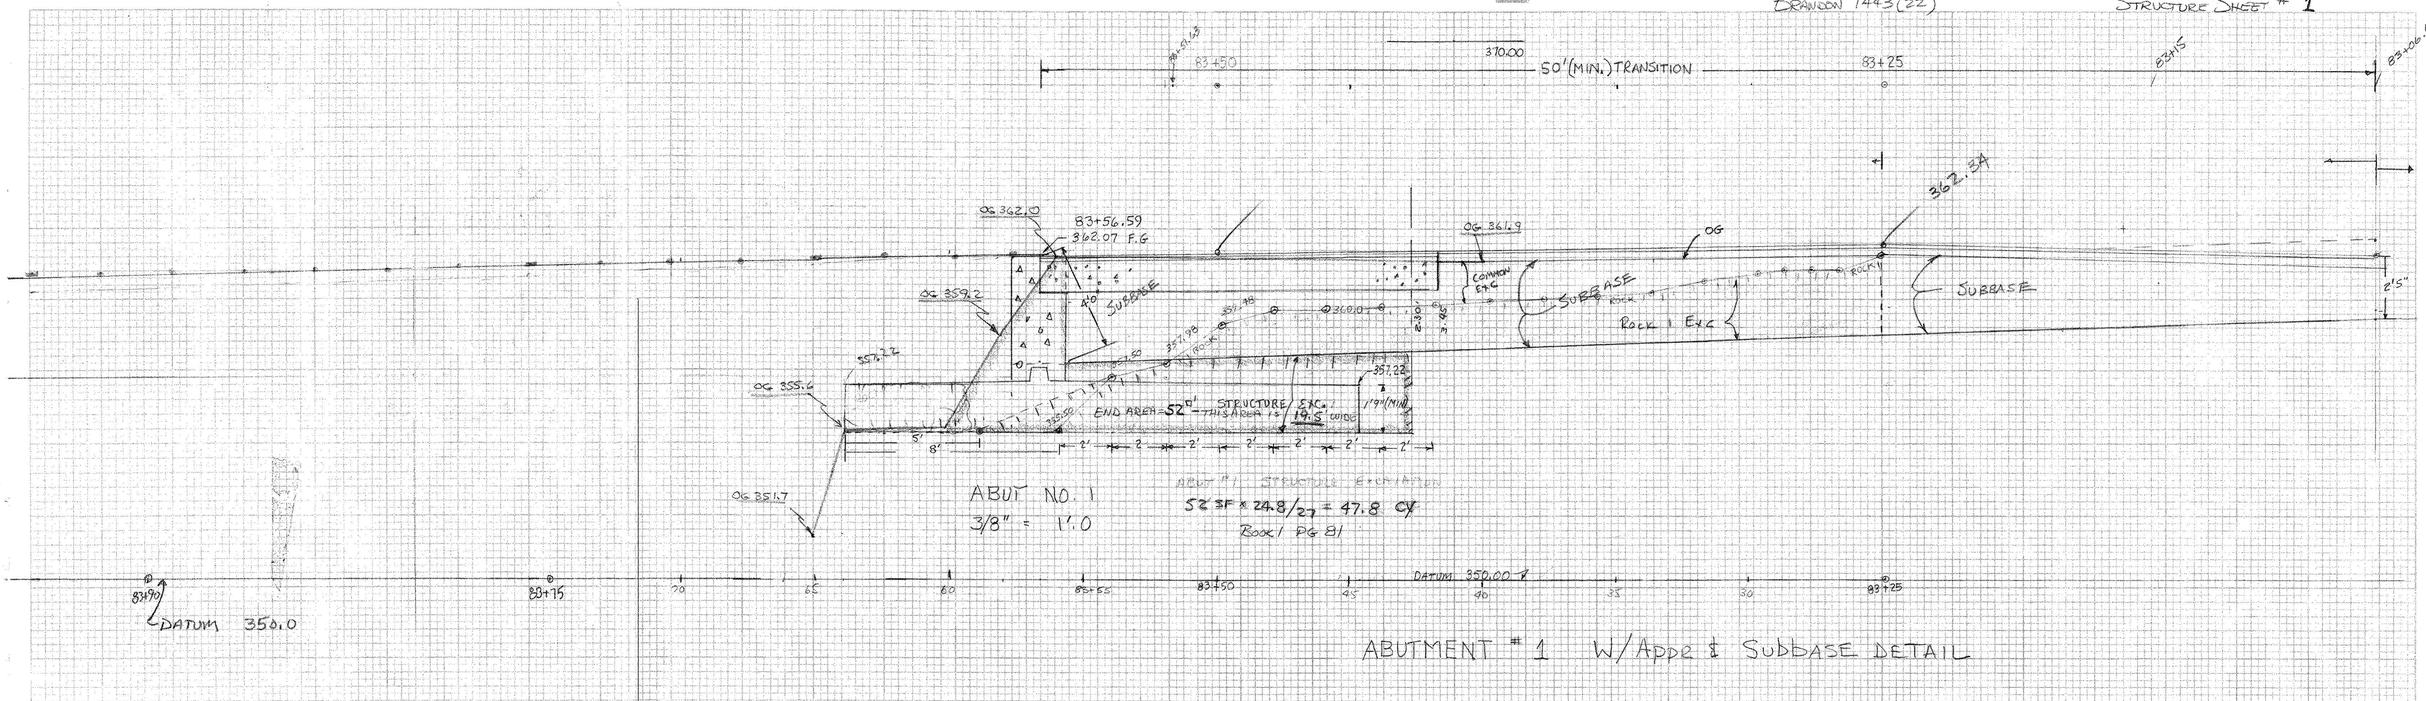

ABUTMENT # 1 W/APPR & SUBBASE DETAIL

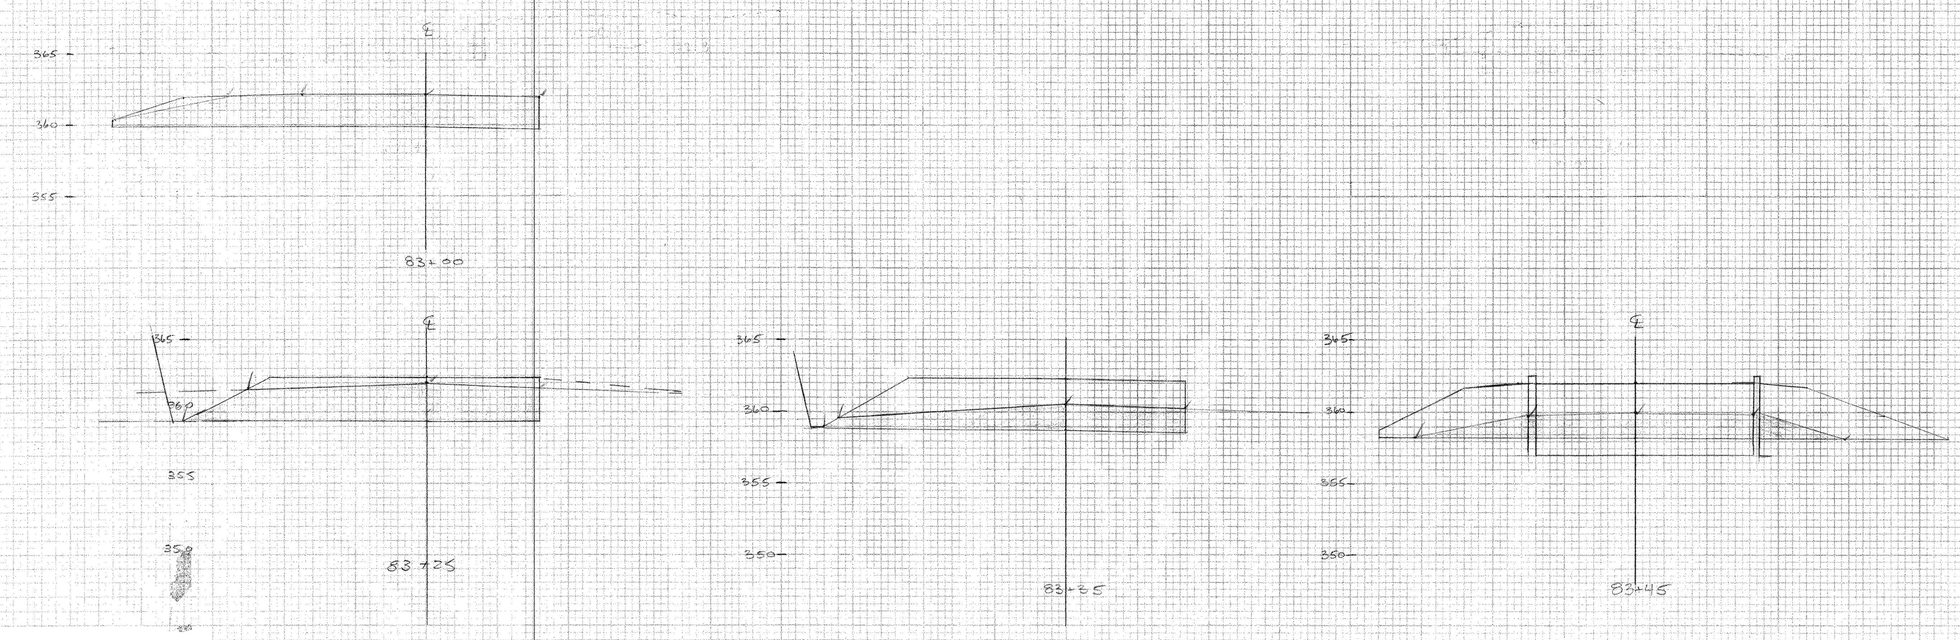

G.P.I.

052

STRUCTURE SHEET # 1 DTP 11/22/02