BRANDON BRZ 1443 (22)

STRUCTURE SHEET # 2

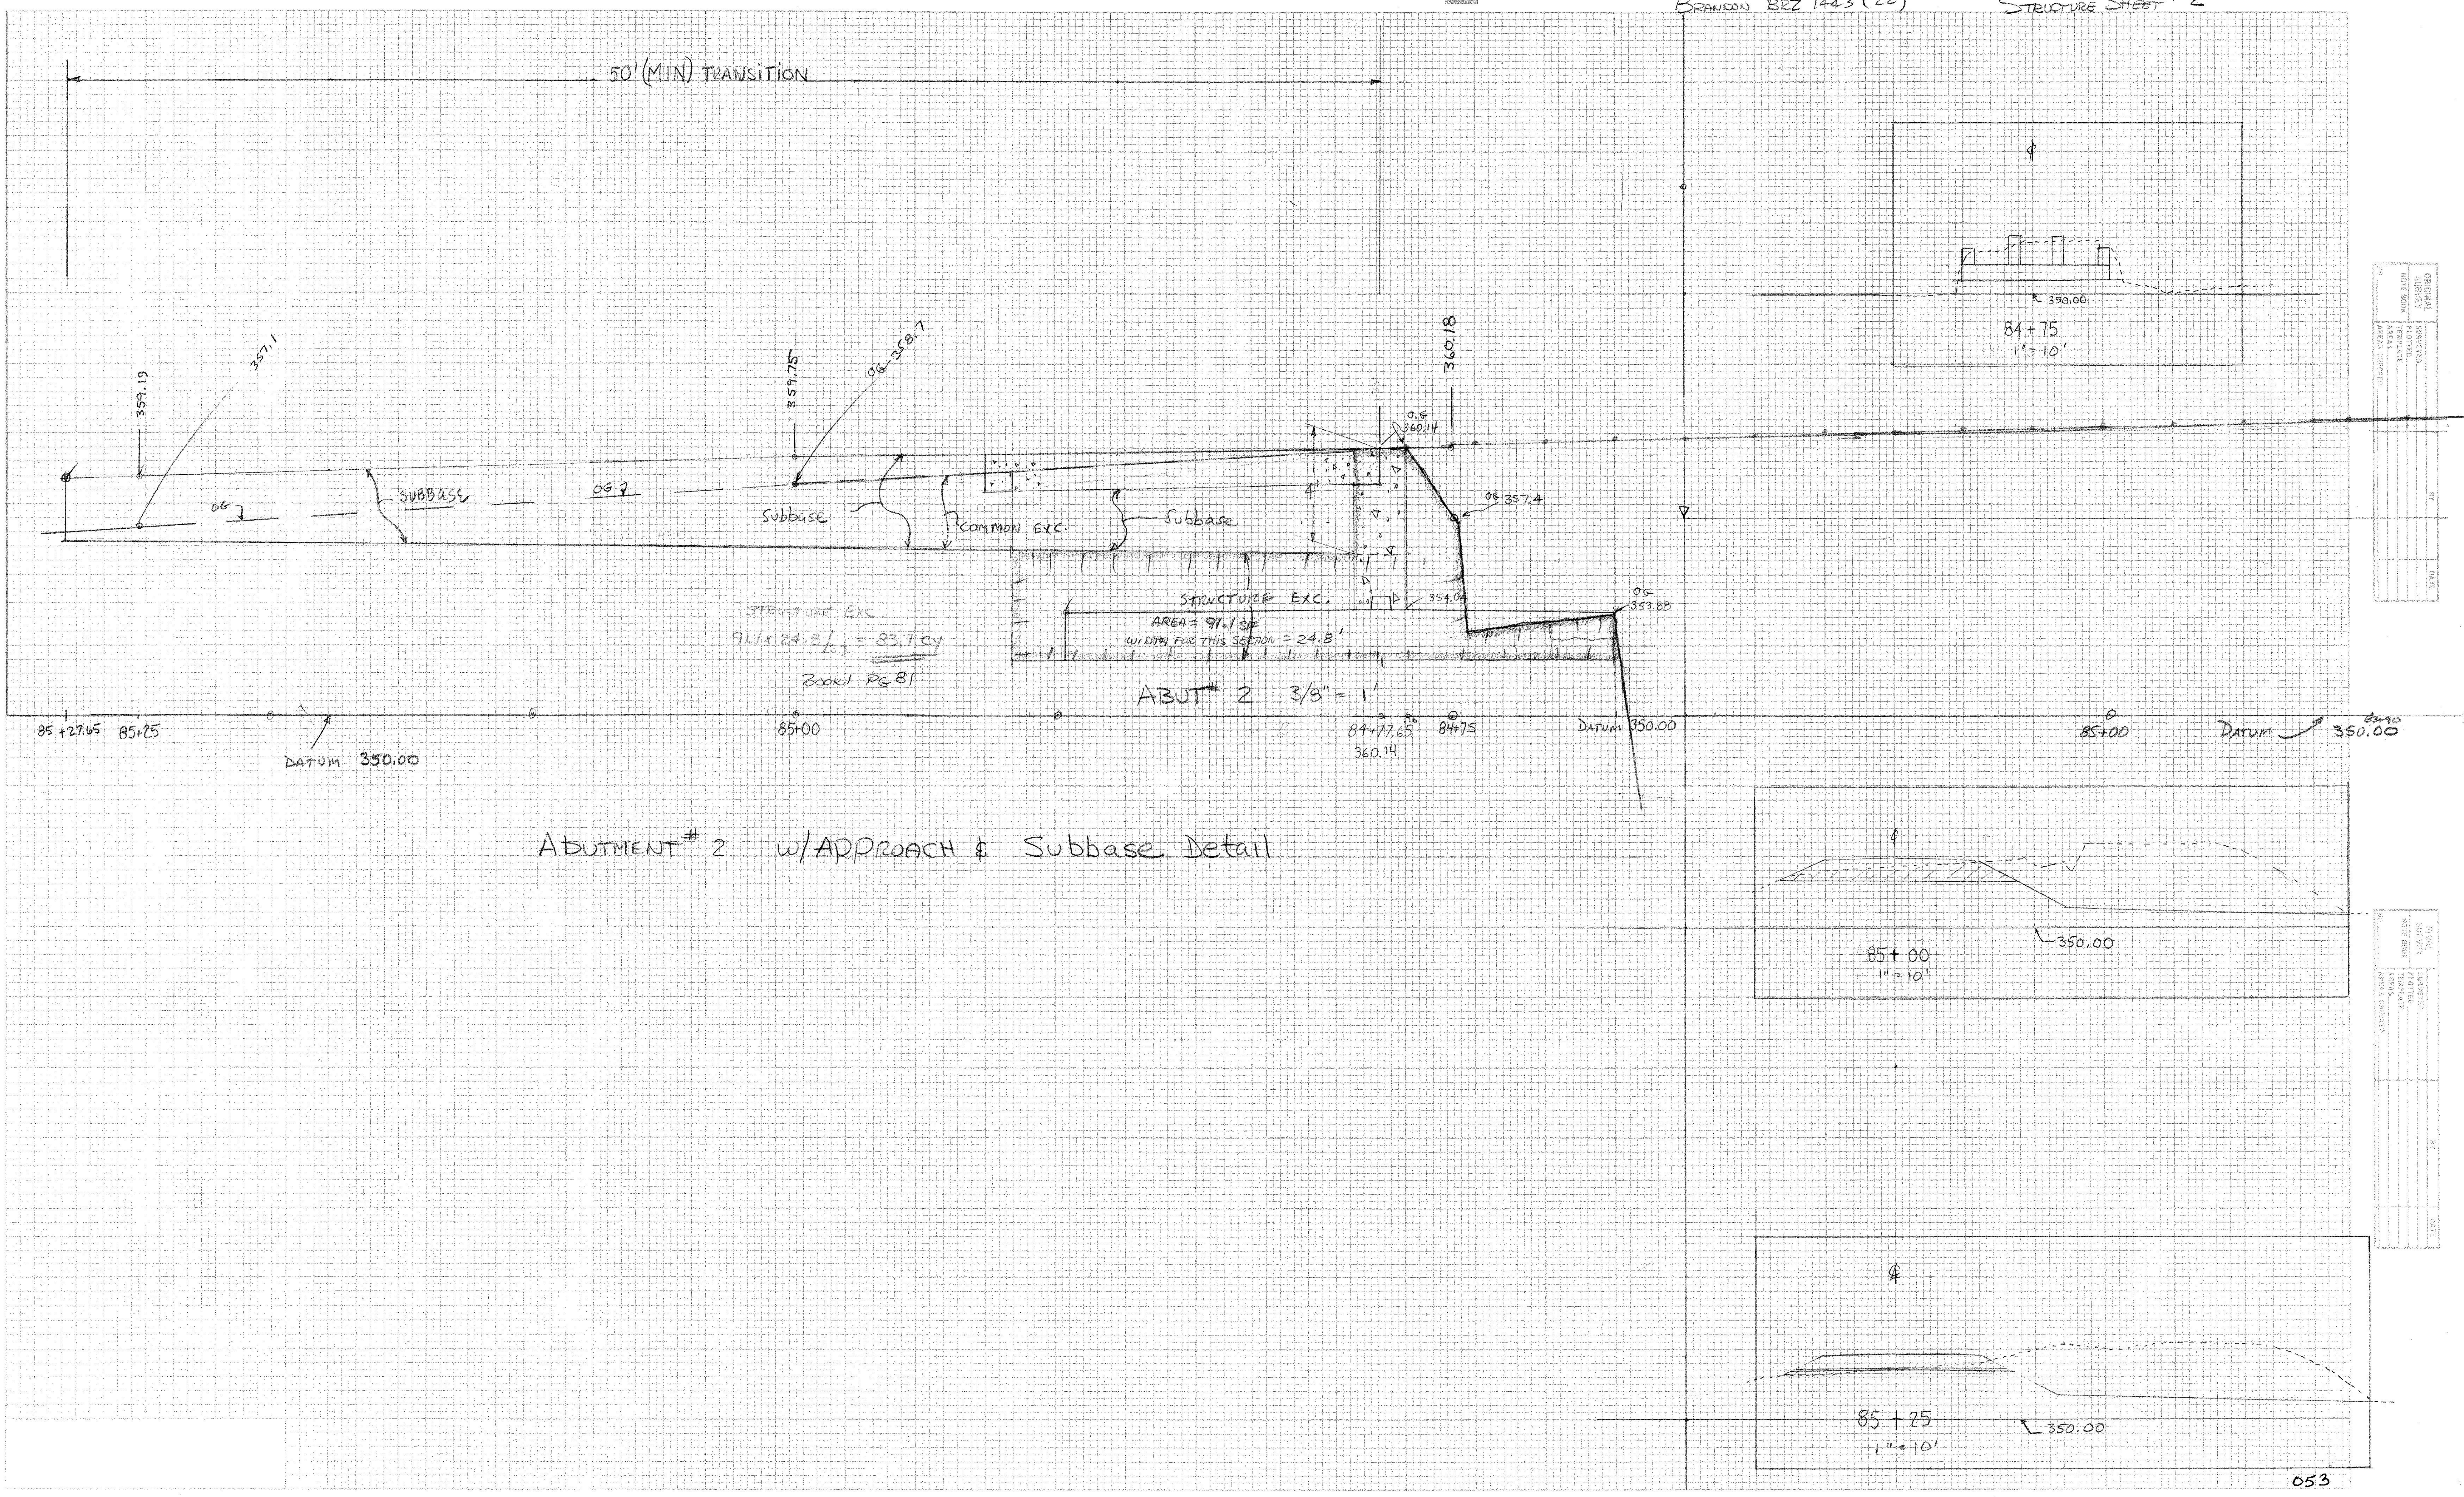
50' (MIN) TRANSITION
359.19
357.1
359.75
OG 358.7
360.18
O.G 360.14
SUBBASE
OG
OG
Subbase
COMMON EXC.
Subbase
4'
OG 357.4
STRUCTURE EXC.
354.04
OG 353.88
AREA = 91.1 SF
WIDTH FOR THIS SECTION = 24.8'
85+27.65
85+25
DATUM 350.00
85+00
84+77.65
360.14
84+75
DATUM 350.00
85+00
83+90
DATUM 350.00
℄
350.00
℄
350.00
℄
350.00

STRUCTURE EXC.
91.1 x 24.8/27 = 83.7 CY

Book 1 PG 81

ABUT # 2 3/8" = 1'

ADUTMENT # 2 w/APPROACH & Subbase Detail

84+75
1" = 10'

85+00
1" = 10'

85+25
1" = 10'

GPI.

DTP- 11/22/02