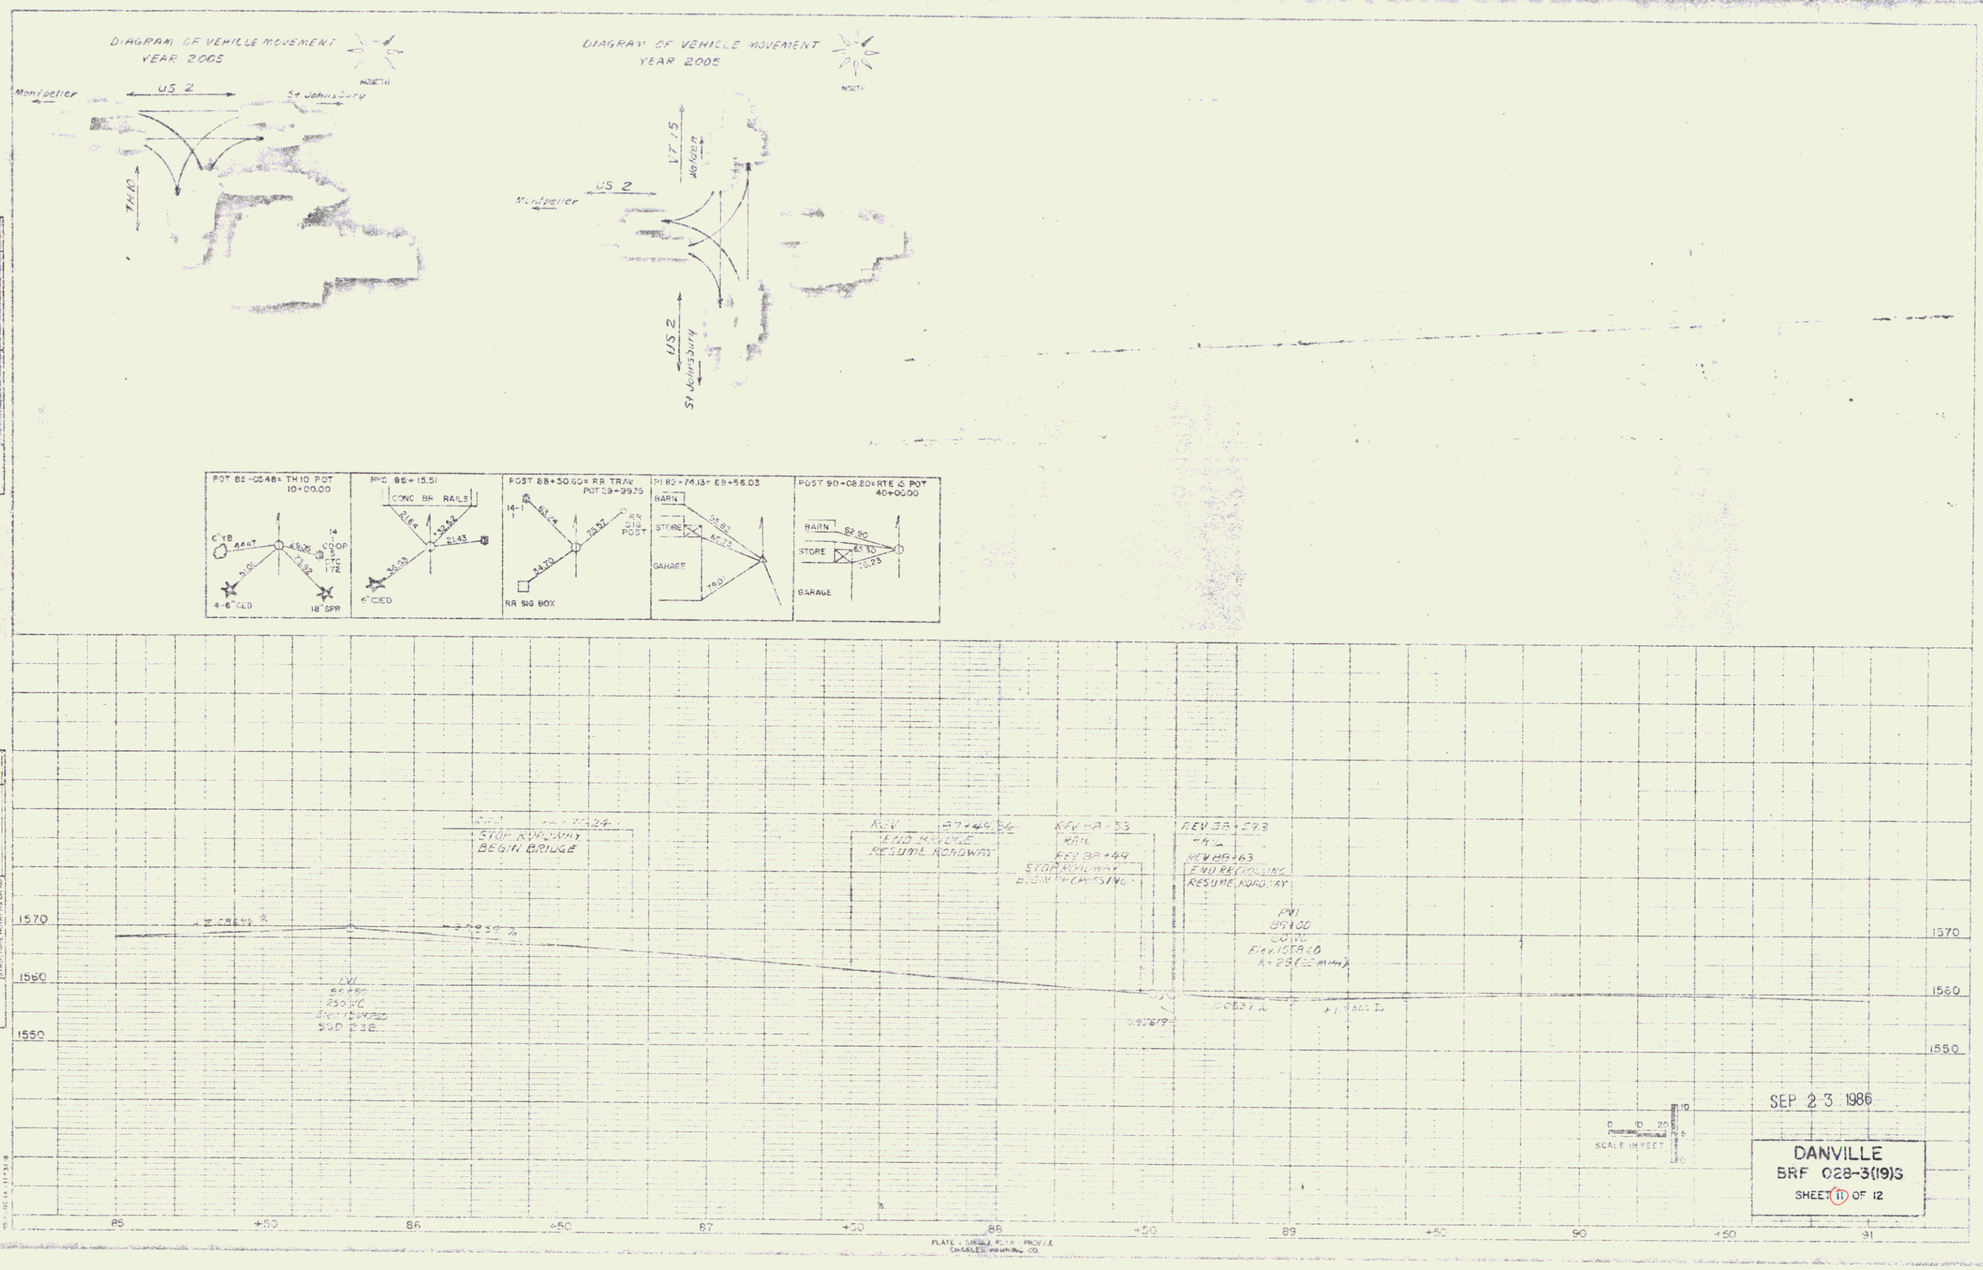
DIAGRAM OF VEHICLE MOVEMENT
YEAR 2005
NORTH
Montpelier
US 2
St Johnsbury
TH 10
DIAGRAM OF VEHICLE MOVEMENT
YEAR 2005
NORTH
VT 15
Montpelier
US 2
US 2
St Johnsbury
POST 88+05.48± TH 10 POST
10+00.00
CYB
4-6" CED
18" SPR
14
COOP
BR
CTS
172
BRC 88+15.51
CONC BR RAILS
6" CED
POST 88+50.60± RR TRAV
POST 29+99.75
14-1
RR SIG POST
RR SIG BOX
PI 89+74.13± E9+56.03
BARN
STORE
GARAGE
POST 90+08.20± RTE 15 POST
40+00.00
BARN
STORE
GARAGE
PLAN
PROFILE
STOP ROADWAY
BEGIN BRIDGE
END BRIDGE
RESUME ROADWAY
STOP ROADWAY
BEGIN CONSTRUCTION
END RECONSTRUCTION
RESUME ROADWAY
PVI
89+00
1570
1560
1550
85
+50
86
+50
87
+50
88
+50
89
+50
90
+50
91
SCALE IN FEET
SEP 23 1986
DANVILLE
BRF 028-3(19)S
SHEET 11 OF 12

11