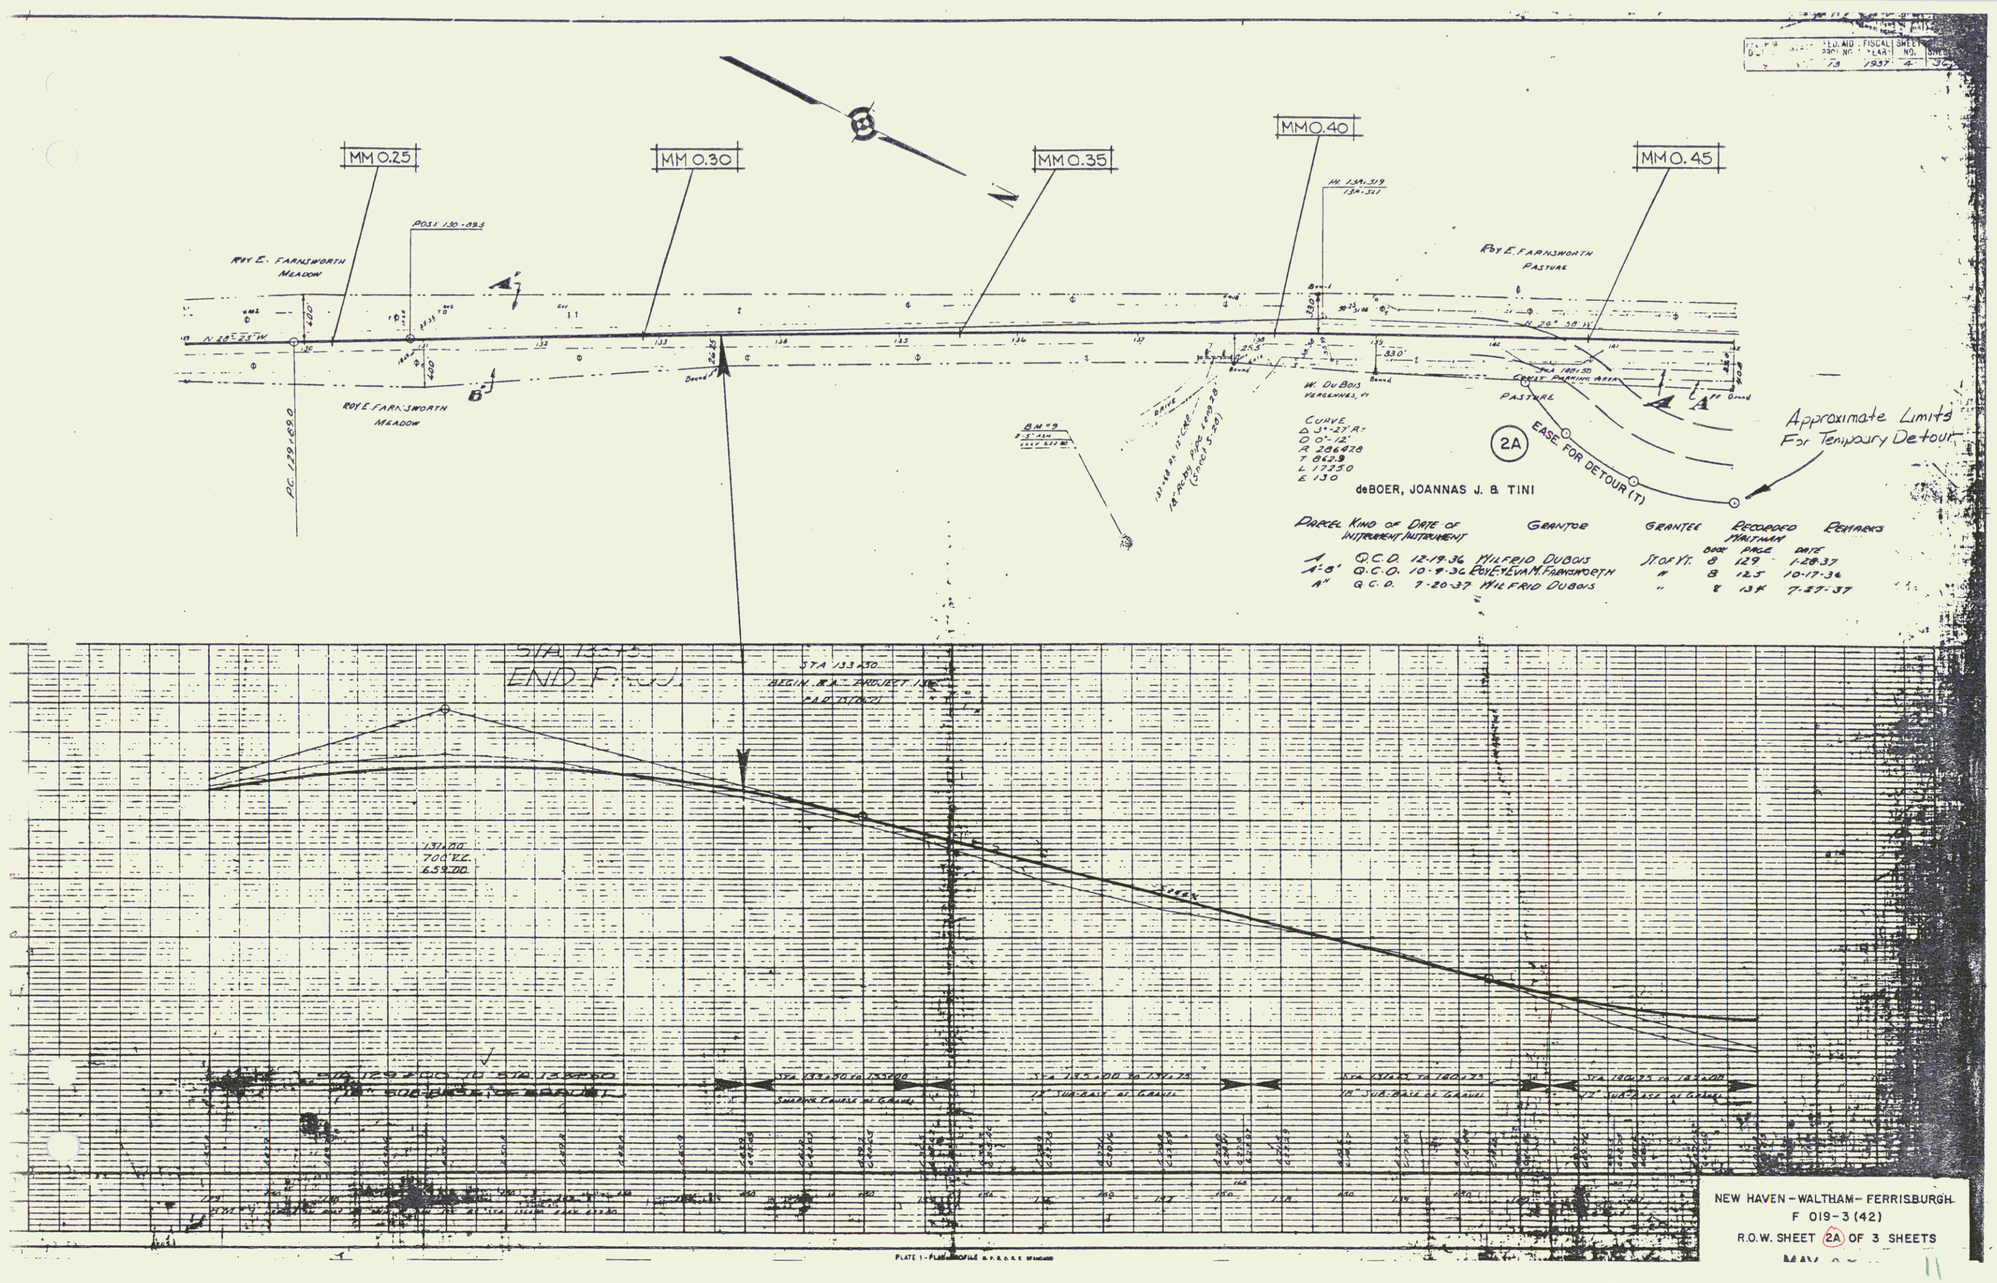
MM 0.25
MM 0.30
MM 0.35
MM 0.40
MM 0.45
ROY E. FARNSWORTH MEADOW
ROY E. FARNSWORTH PASTURE
W. DUBOIS
PASTURE
2A
EASE FOR DETOUR (T)
Approximate Limits For Temporary Detour
deBOER, JOANNAS J. & TINI
PARCEL KIND OF INSTRUMENT DATE OF INSTRUMENT GRANTOR GRANTEE RECORDED WALTHAM BOOK PAGE DATE REMARKS
A Q.C.D. 12-19-36 WILFRID DUBOIS St. of Vt. 8 129 1-28-37
A-8' Q.C.D. 10-9-36 ROY E. & EVA M. FARNSWORTH " 8 125 10-17-36
A" Q.C.D. 7-20-37 WILFRID DUBOIS " 8 134 7-27-37
STA 133+50
BEGIN N.H. PROJECT
END F.A.U.
NEW HAVEN - WALTHAM - FERRISBURGH
F 019-3 (42)
R.O.W. SHEET 2A OF 3 SHEETS