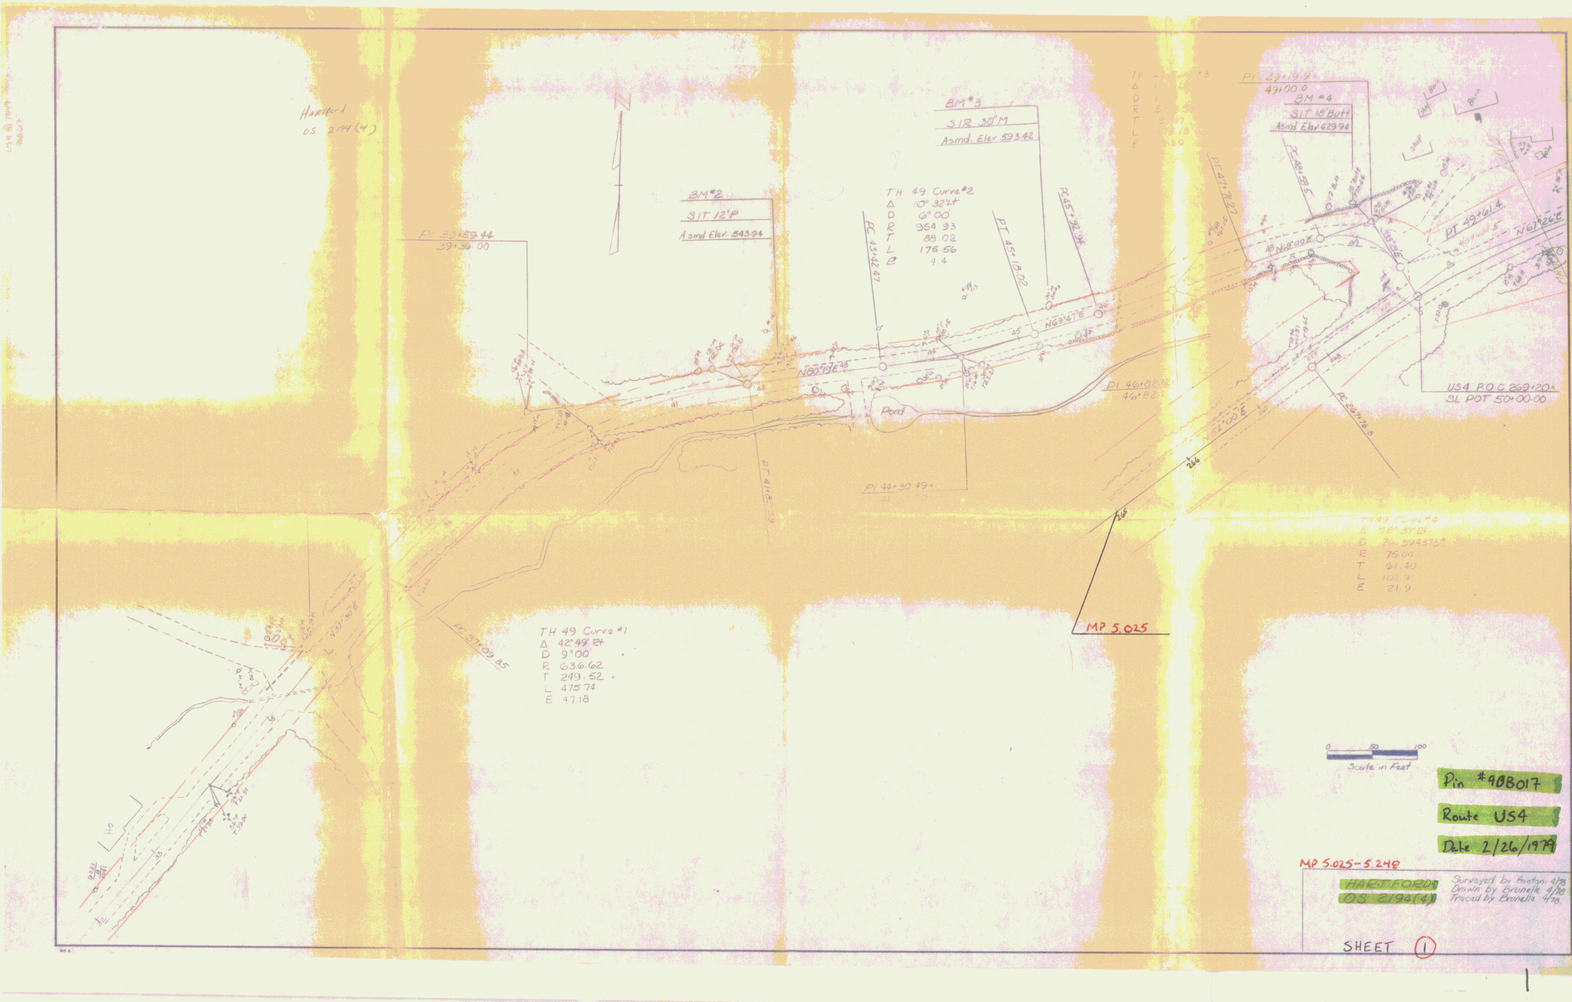
Hartford
OS 2194(4)
BM#2
SIT 12"P
Asmd. Elev. 843.94
BM#3
SIR 30"M
Asmd. Elev. 593.42
BM#4
SIT 18"Butt
TH 49 Curve #2
Δ 10°32'24"
D 6°00
R 954.93
T 88.02
L 175.56
E 4.4
TH 49 Curve #1
Δ 42°49'24"
D 9°00
R 636.62
T 249.52
L 475.74
E 47.18
Pond
PI 39+59.44
39+36.00
PC 43+42.47
PT 45+18.02
PC 45+92.94
PI 46+86.84
PI 44+30.49
PT 41+18.33
PI 49+19.9
49+00.0
US4 P.O.C. 269+20±
SL POT 50+00.00
MP 5.025
Scale in Feet
0 50 100
Pin #90B017
Route US4
Date 2/26/1979
MP 5.025-5.248
HARTFORD
OS 2194(4)
Surveyed by Fantoni 4/78
Drawn by Brunelle 4/78
Traced by Brunelle 4/78
SHEET 1