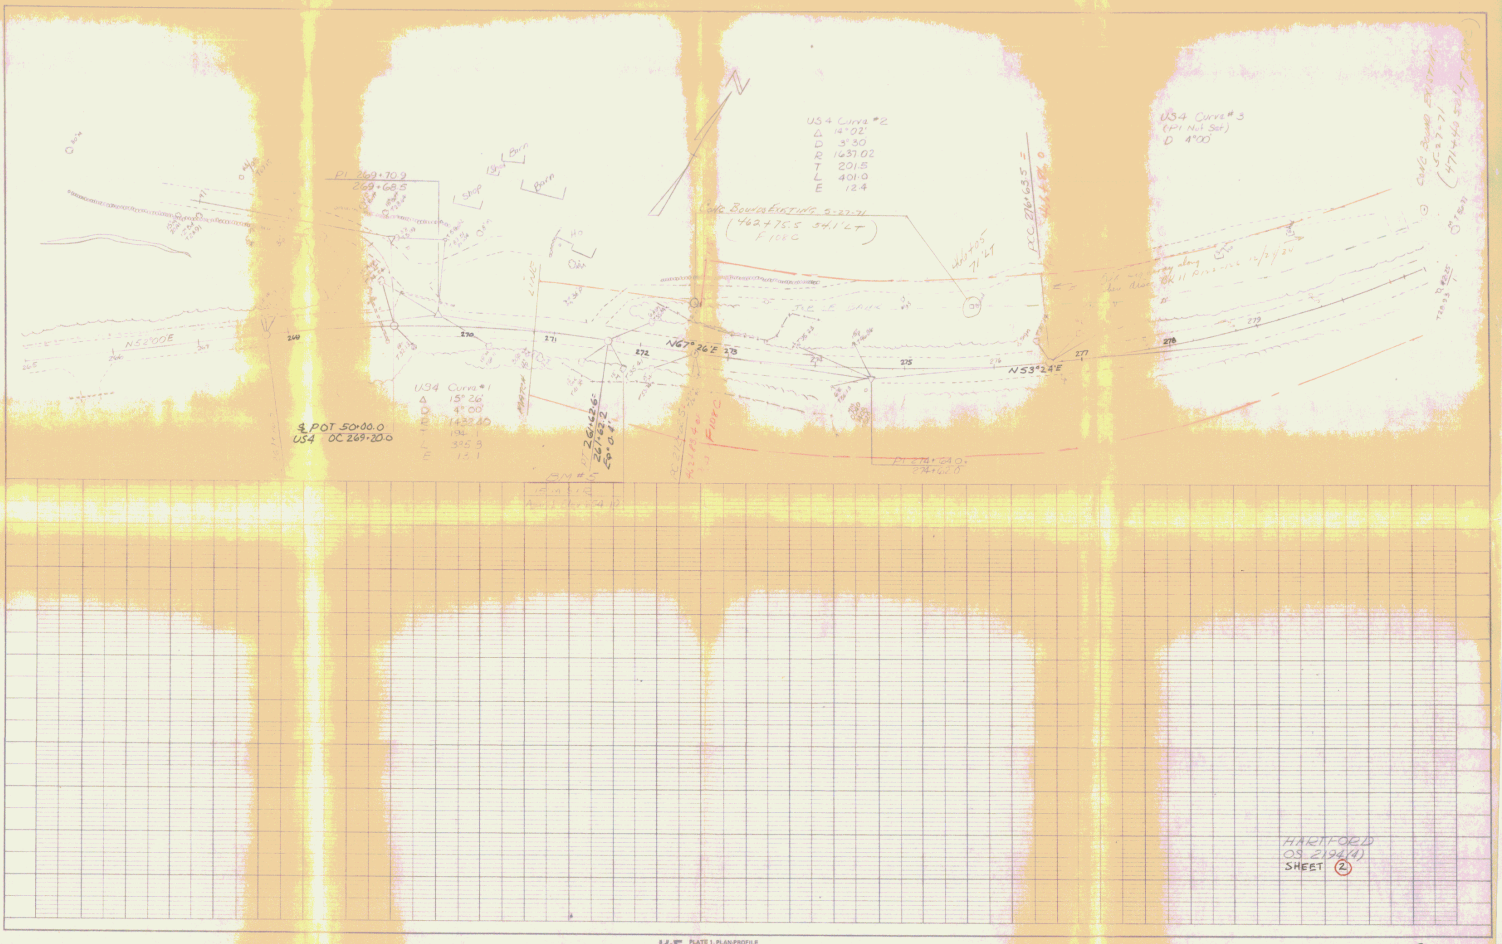

PLAN

PROFILE

K+E PLATE 1, PLAN-PROFILE
KEUFFEL & ESSER CO.
80 7038 MADE IN U.S.A.

2